5 cm

04DM13 - 155 101

C CENTRAL
LIFT 16.

0374-2103

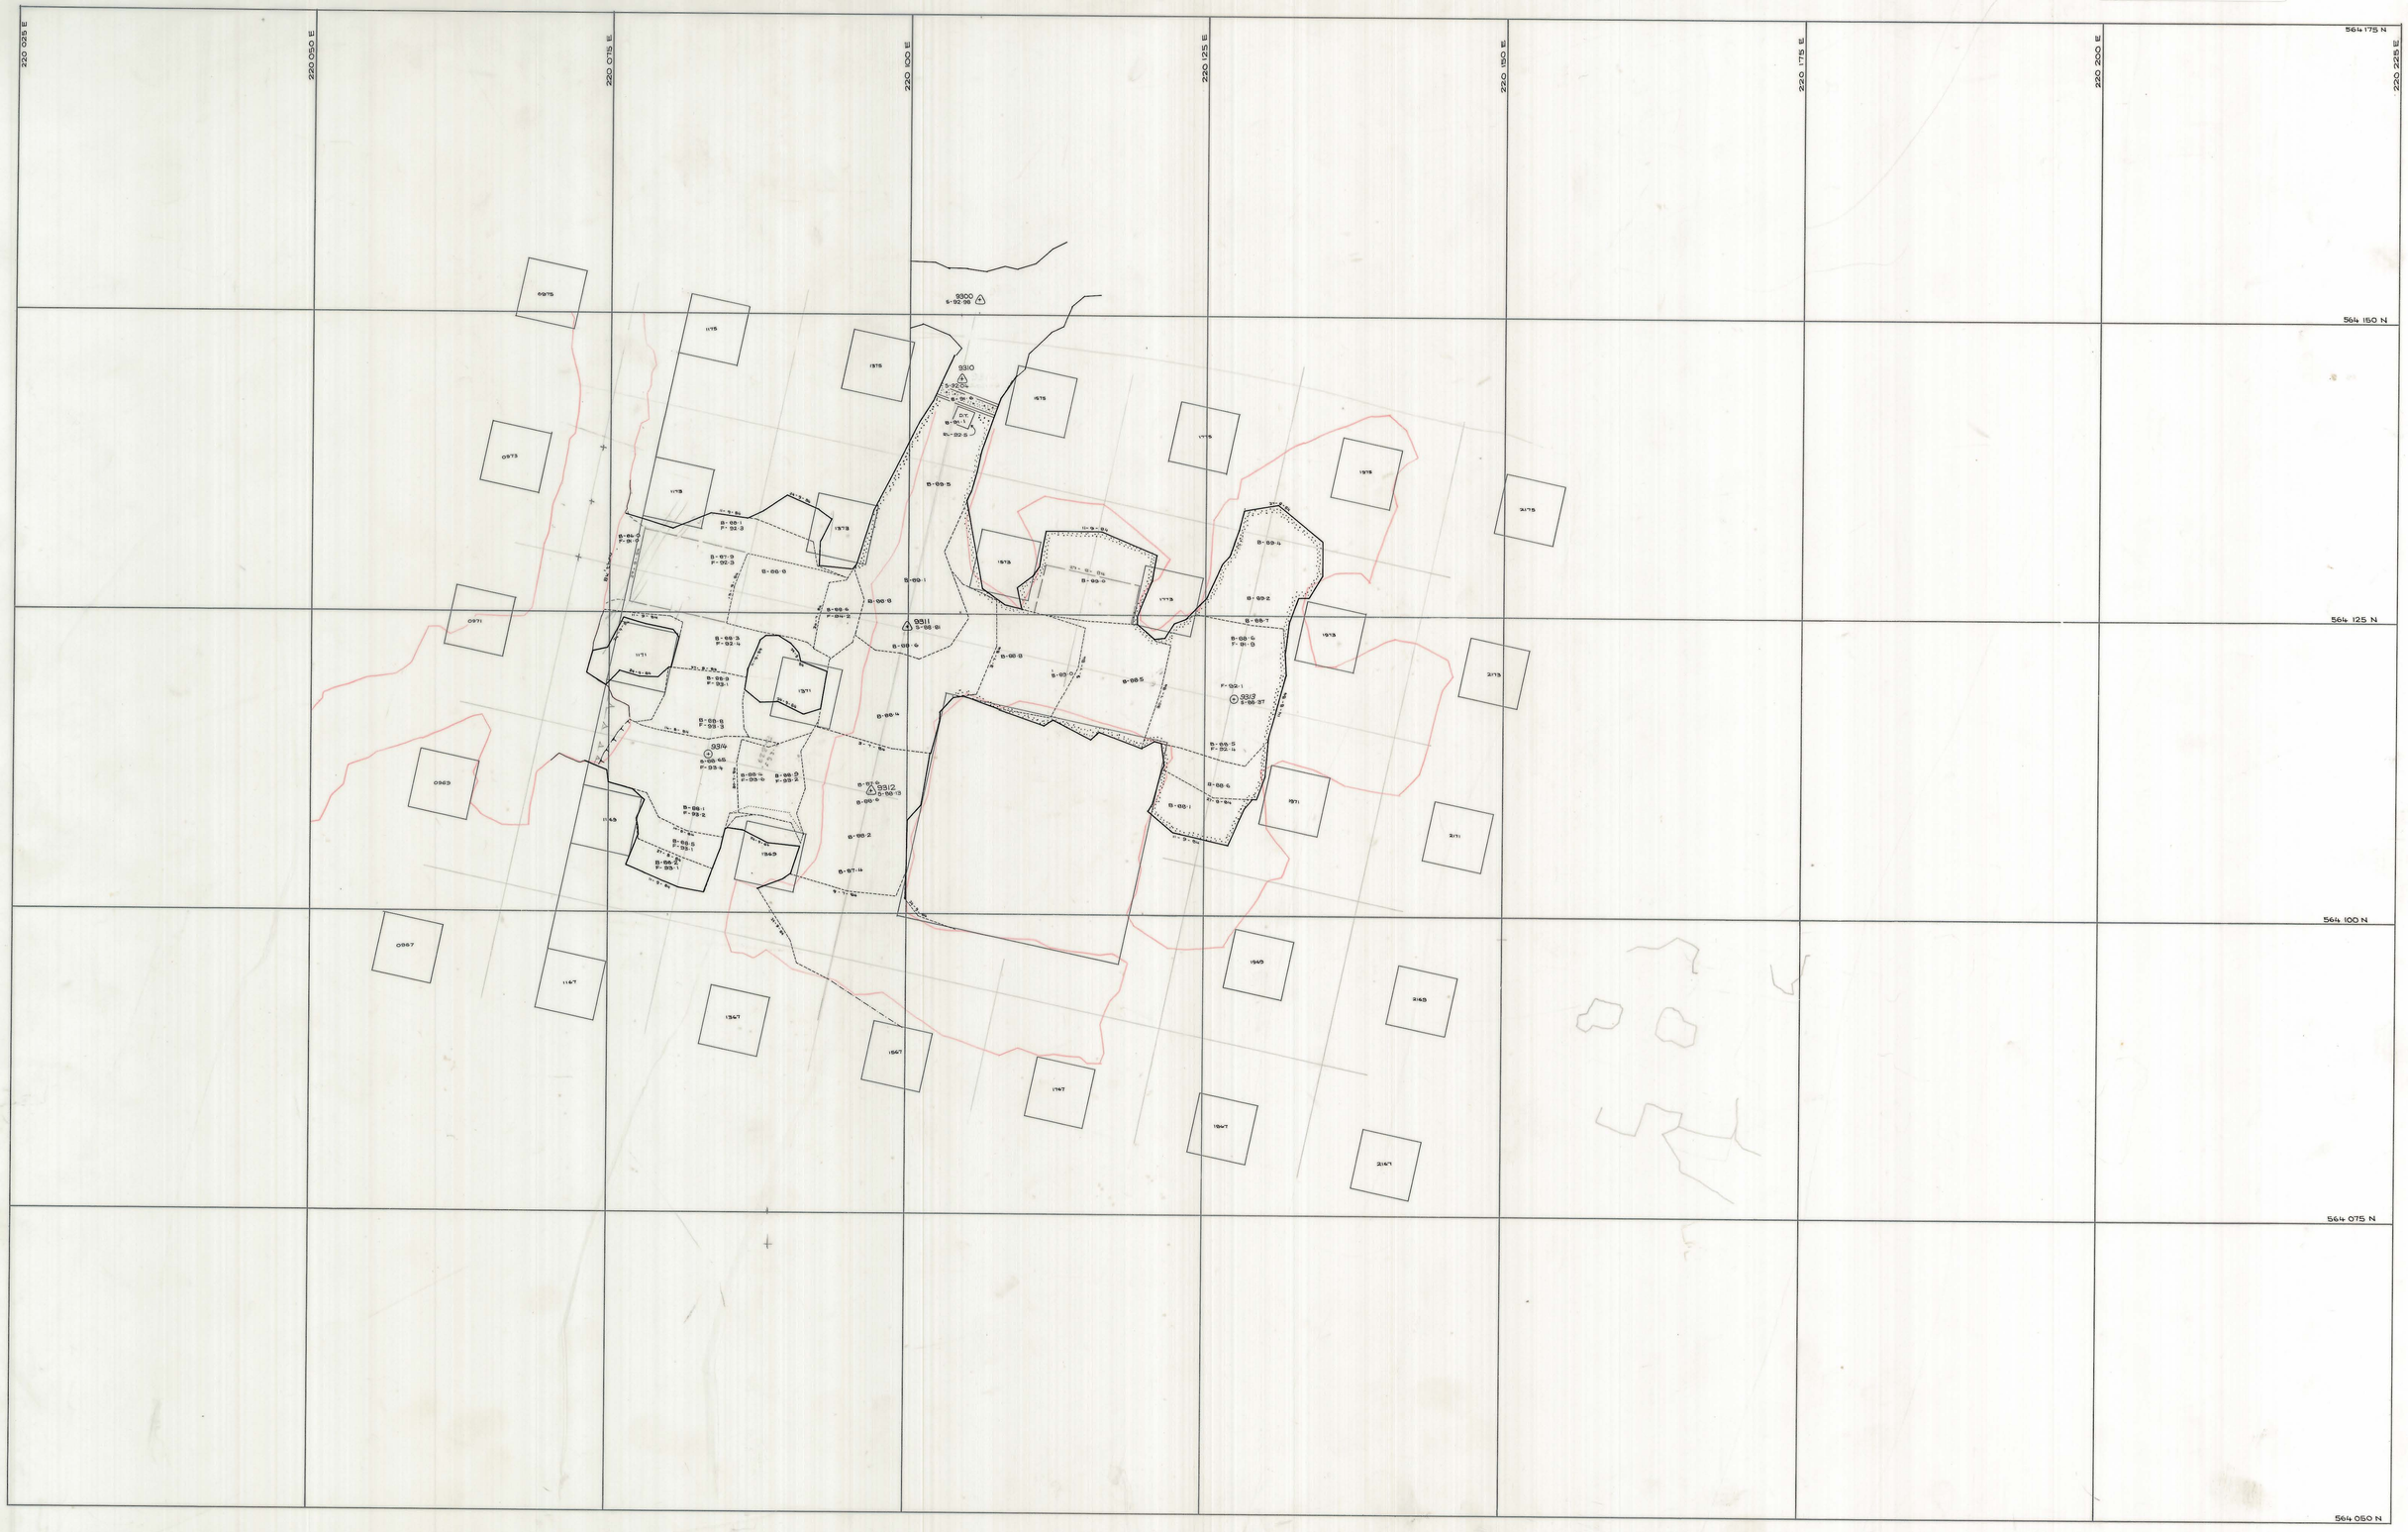

SCALE 1: 250	north	LOCATION: DOLPHIN MINE SUBJECT: C CENTRAL STOPE Lift 16	KING ISLAND SCHEELITE A DIVISION OF WARMAN INTERNATIONAL GRASSY KING ISLAND Grid MMM/YR PLAN NUMBER 04DM13 - 155 101