5 cm

0374-2136

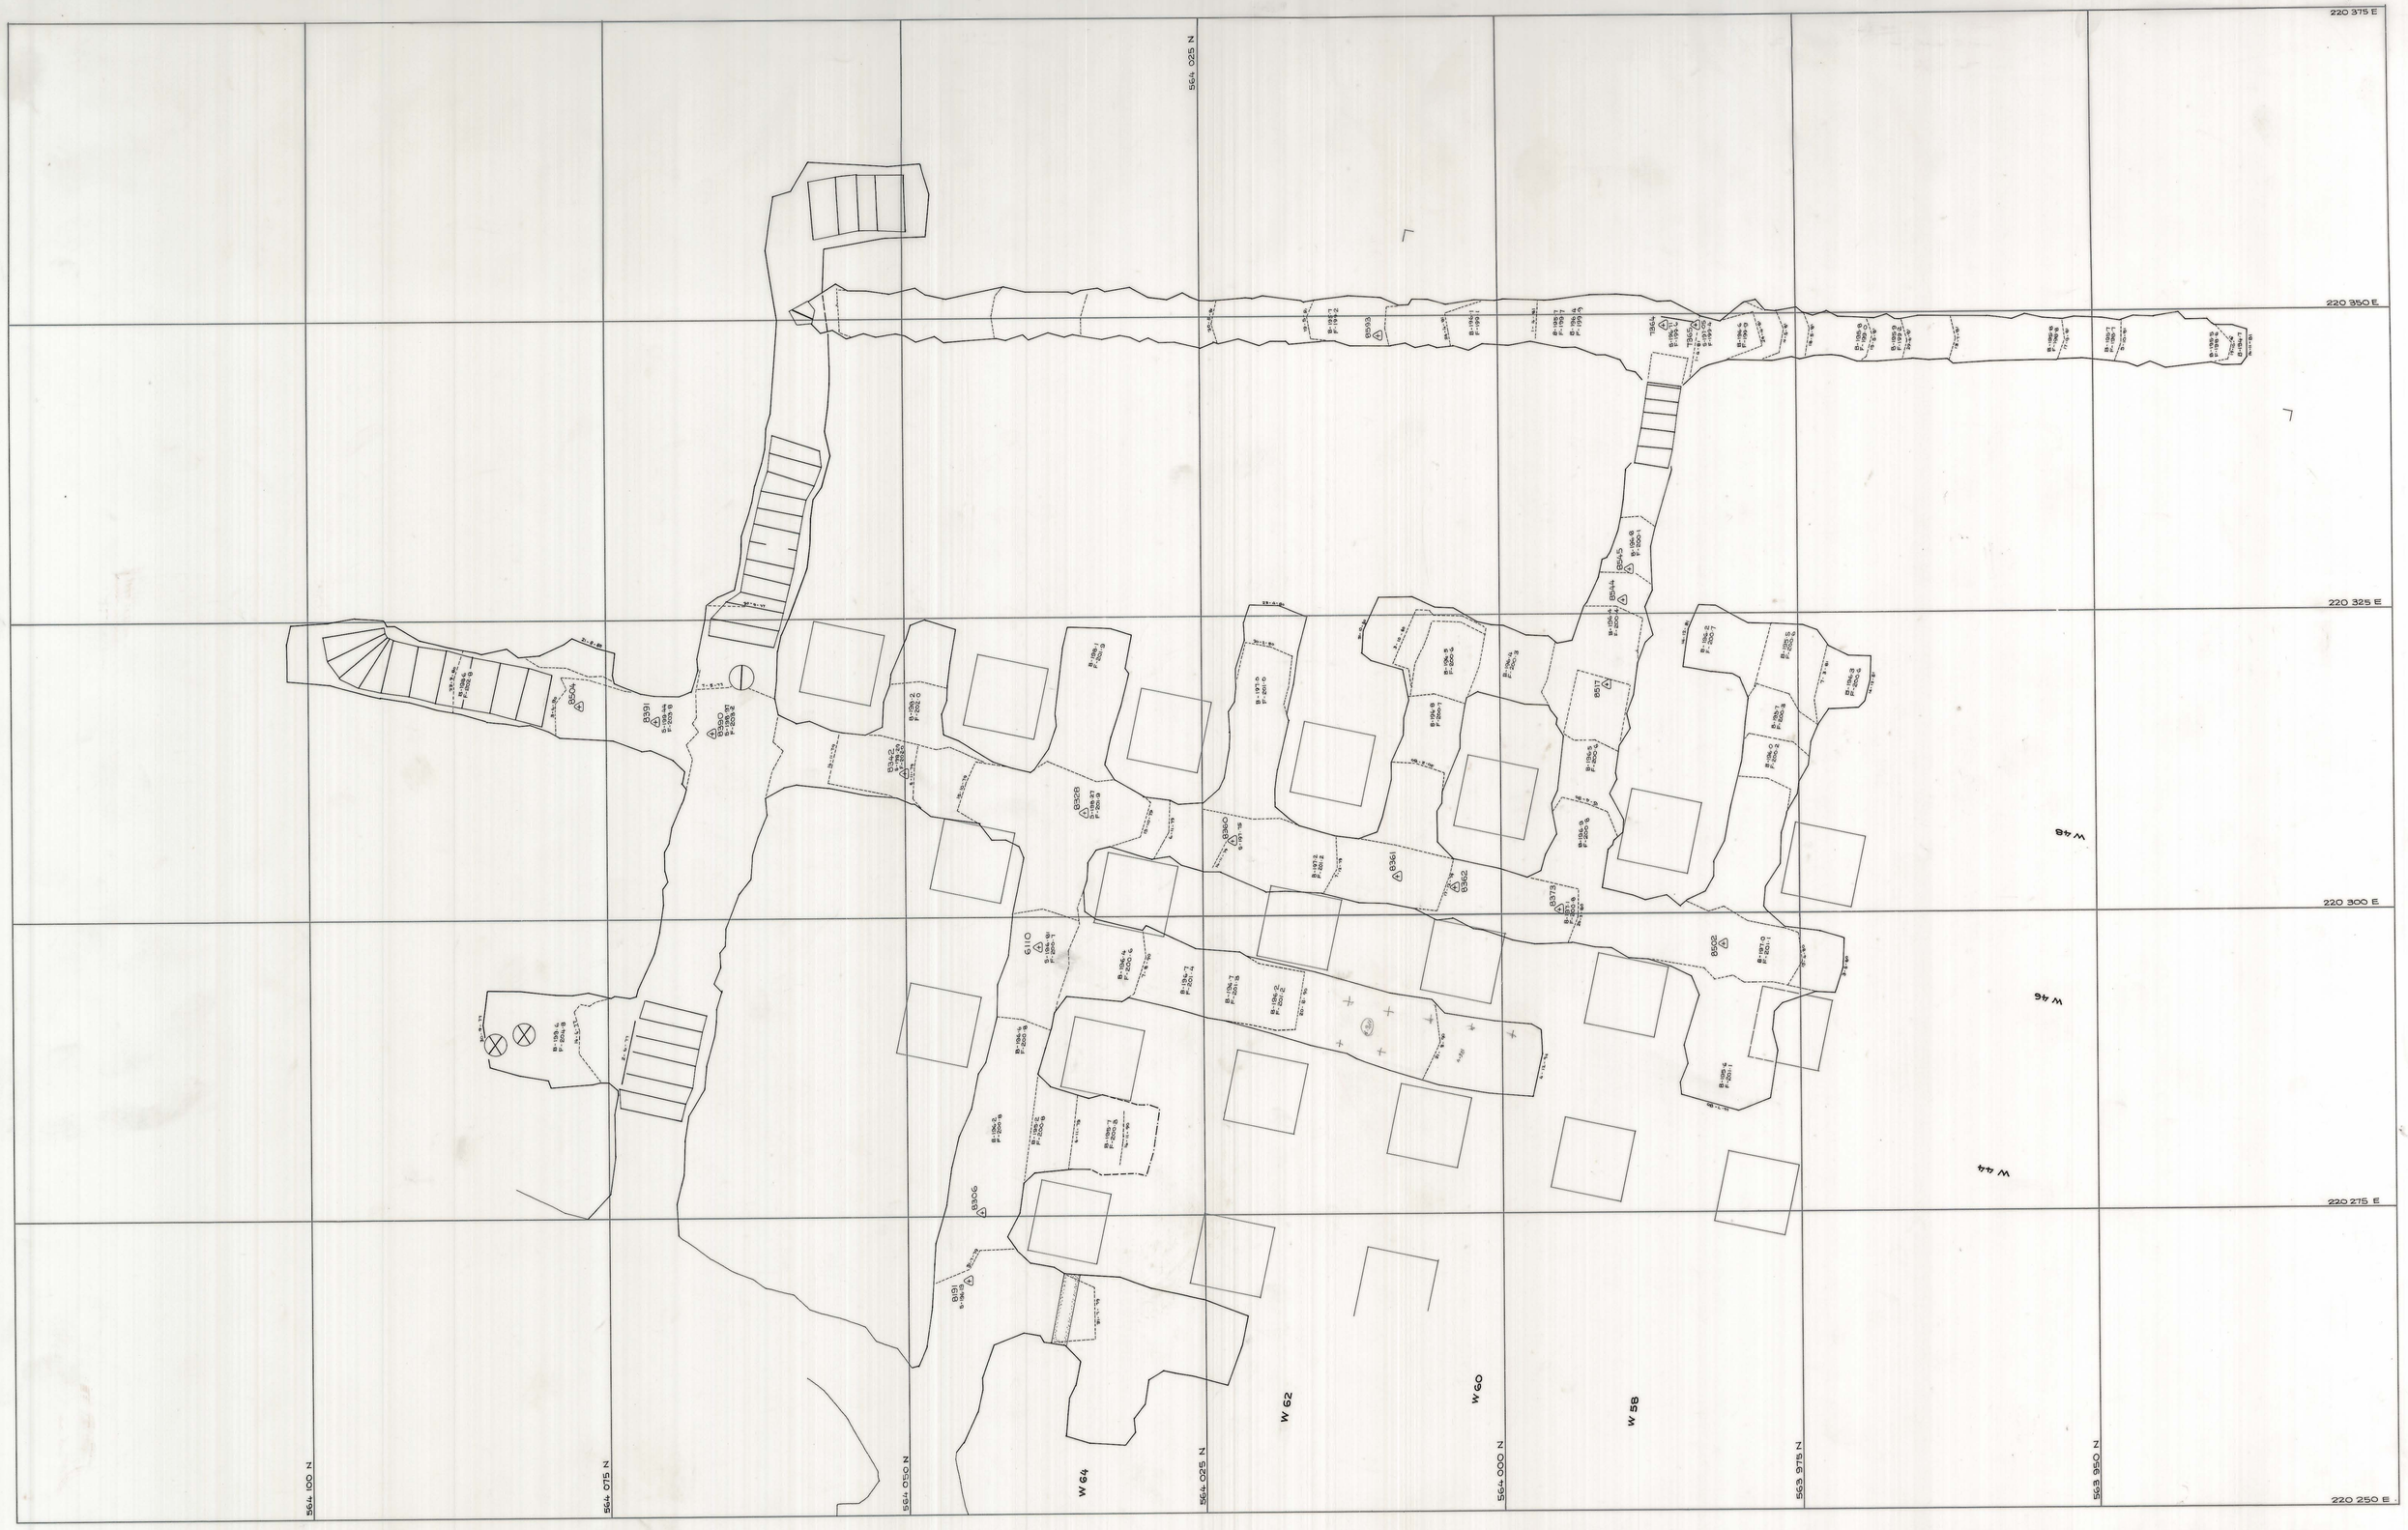

SCALE 1: 250	north	LOCATION: DOLPHIN MINE	KING ISLAND SCHEELITE — A DIVISION OF WARMAN INTERNATIONAL
		SUBJECT: -200 m LEVEL LOWER WEDGE STOPING	GRASSY / KING ISLAND
			Grid MMTH / PLAN NUMBER