5 cm

0374-2151

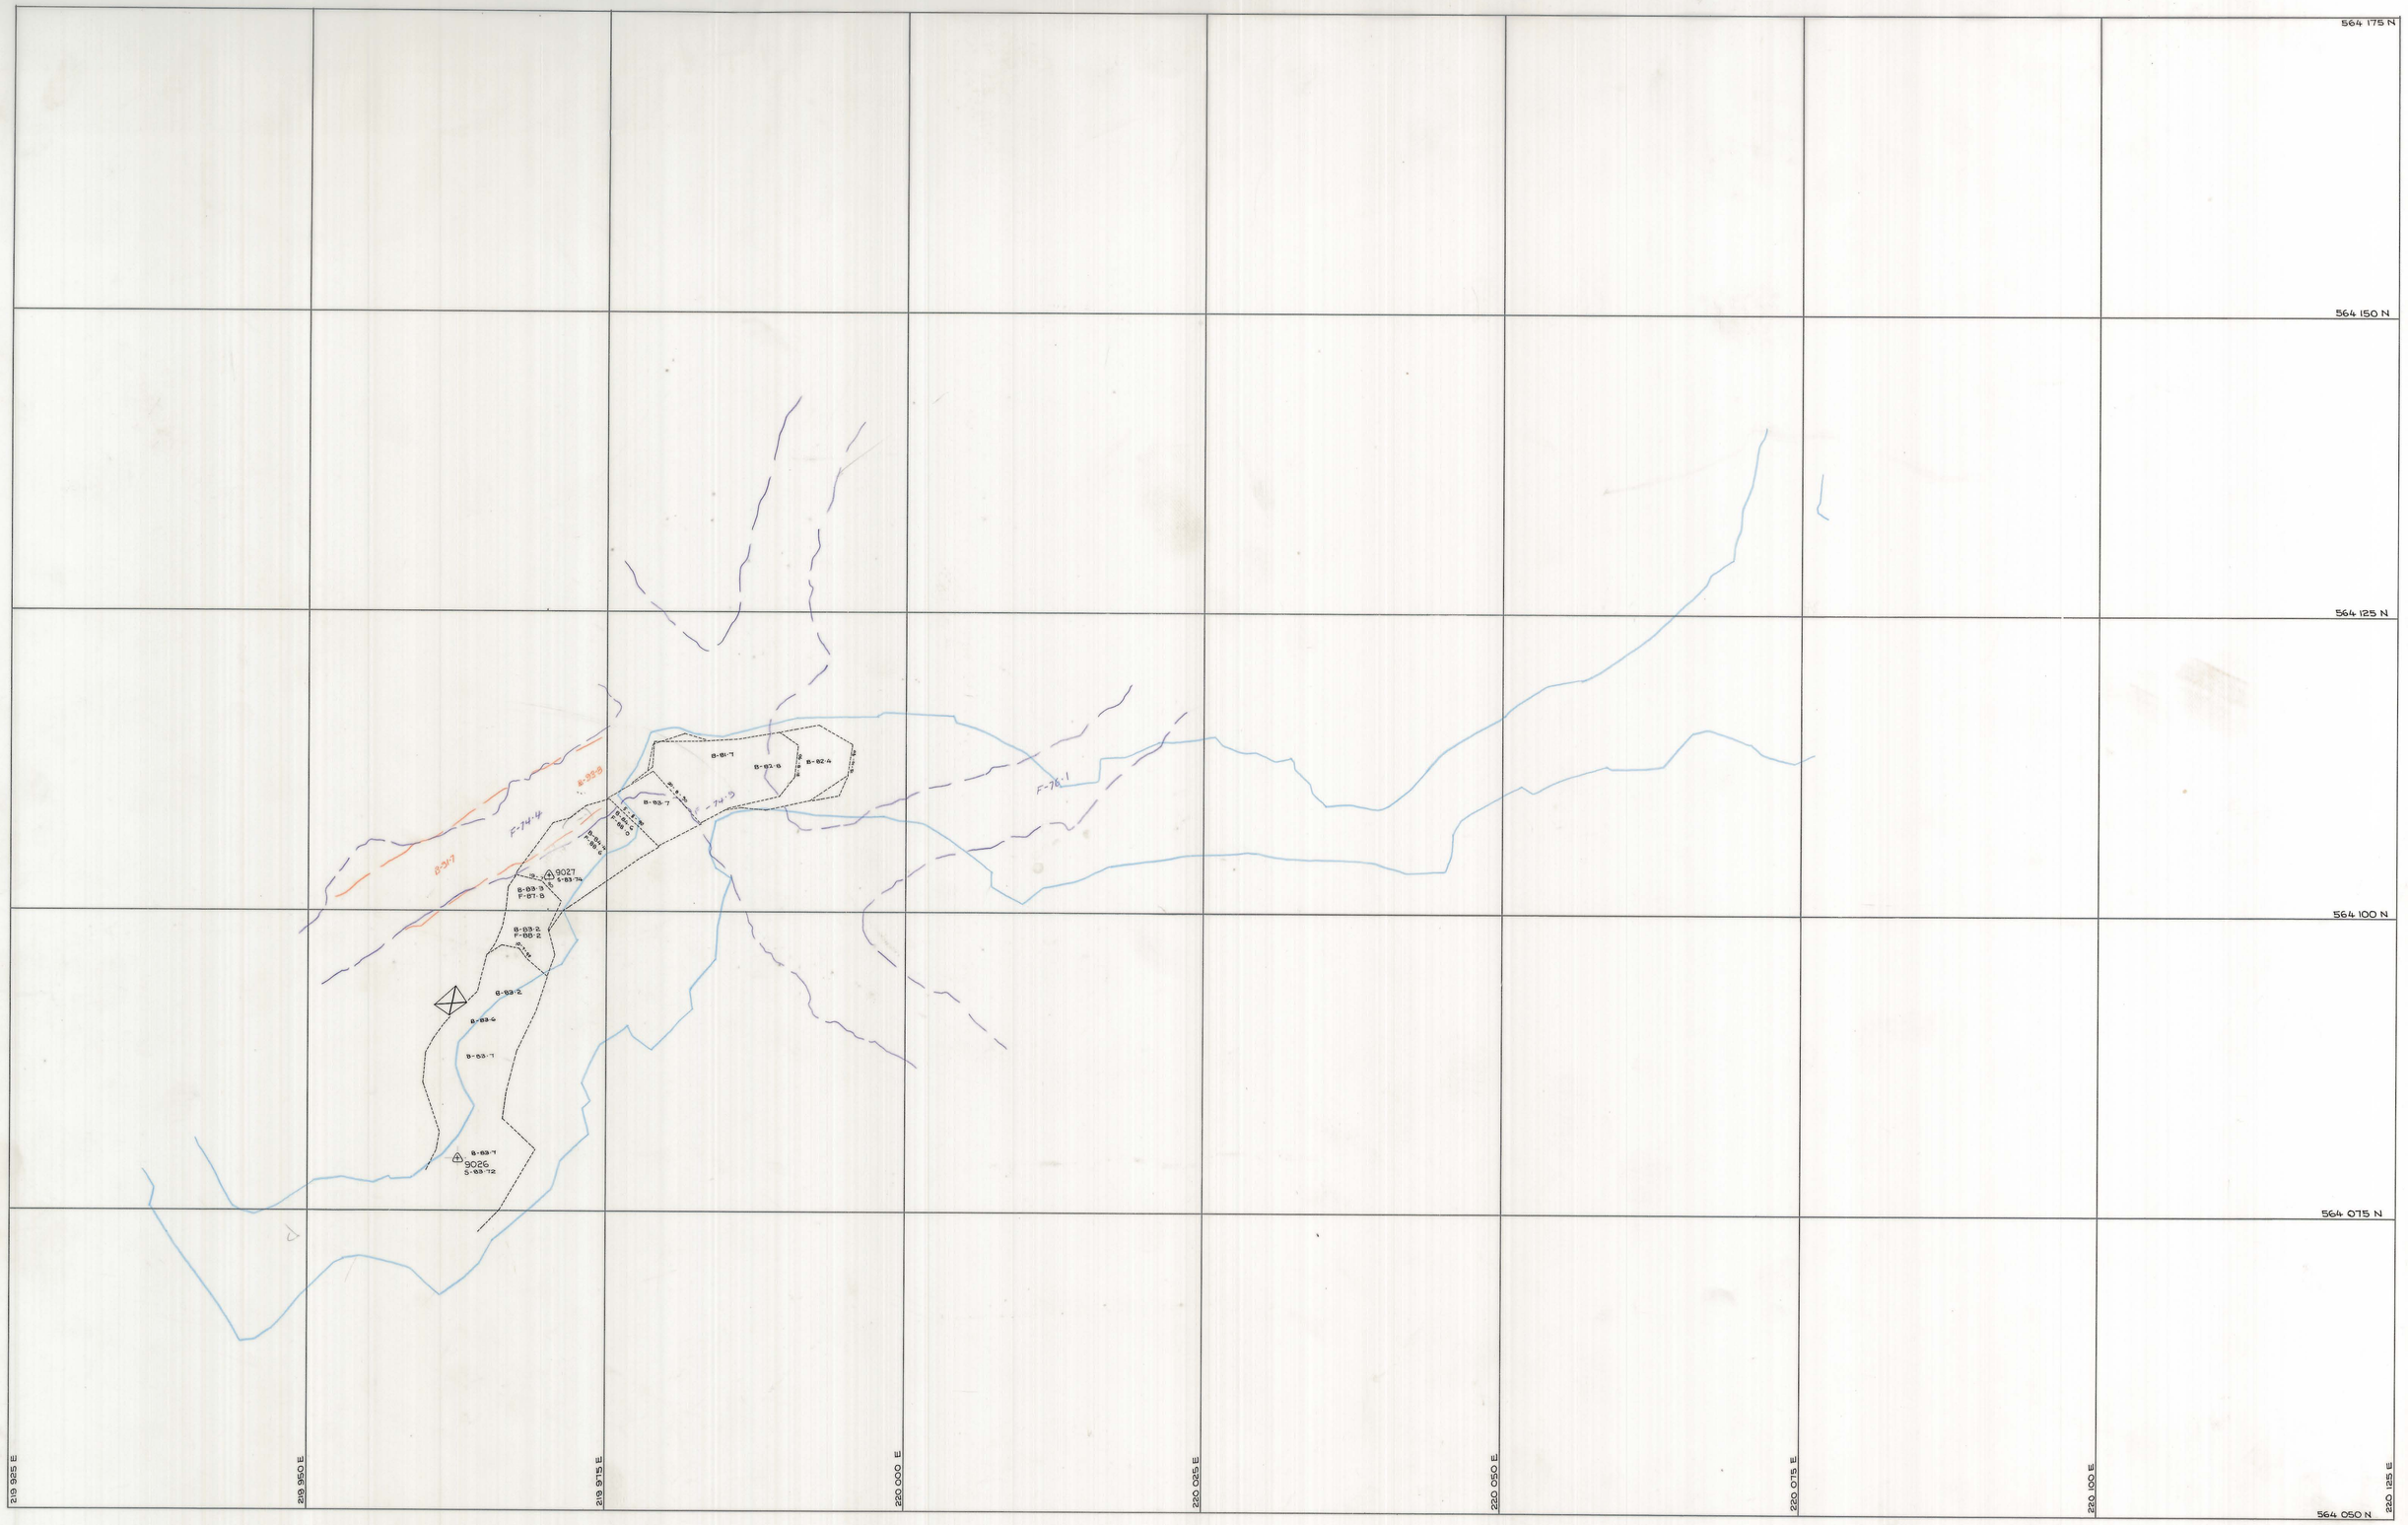

SCALE 1: 250

north

LOCATION

DOLPHIN MINE

SUBJECT

UPPER PIT STOPE - Lift Nº 19

KING ISLAND SCHEELITE
A DIVISION OF WARMAN INTERNATIONAL

GRASSY KING ISLAND

PLAN NUMBER