5 cm
27 JUN 1981
04DM12 - 156 157
MAIN DECLINE
0374_2164

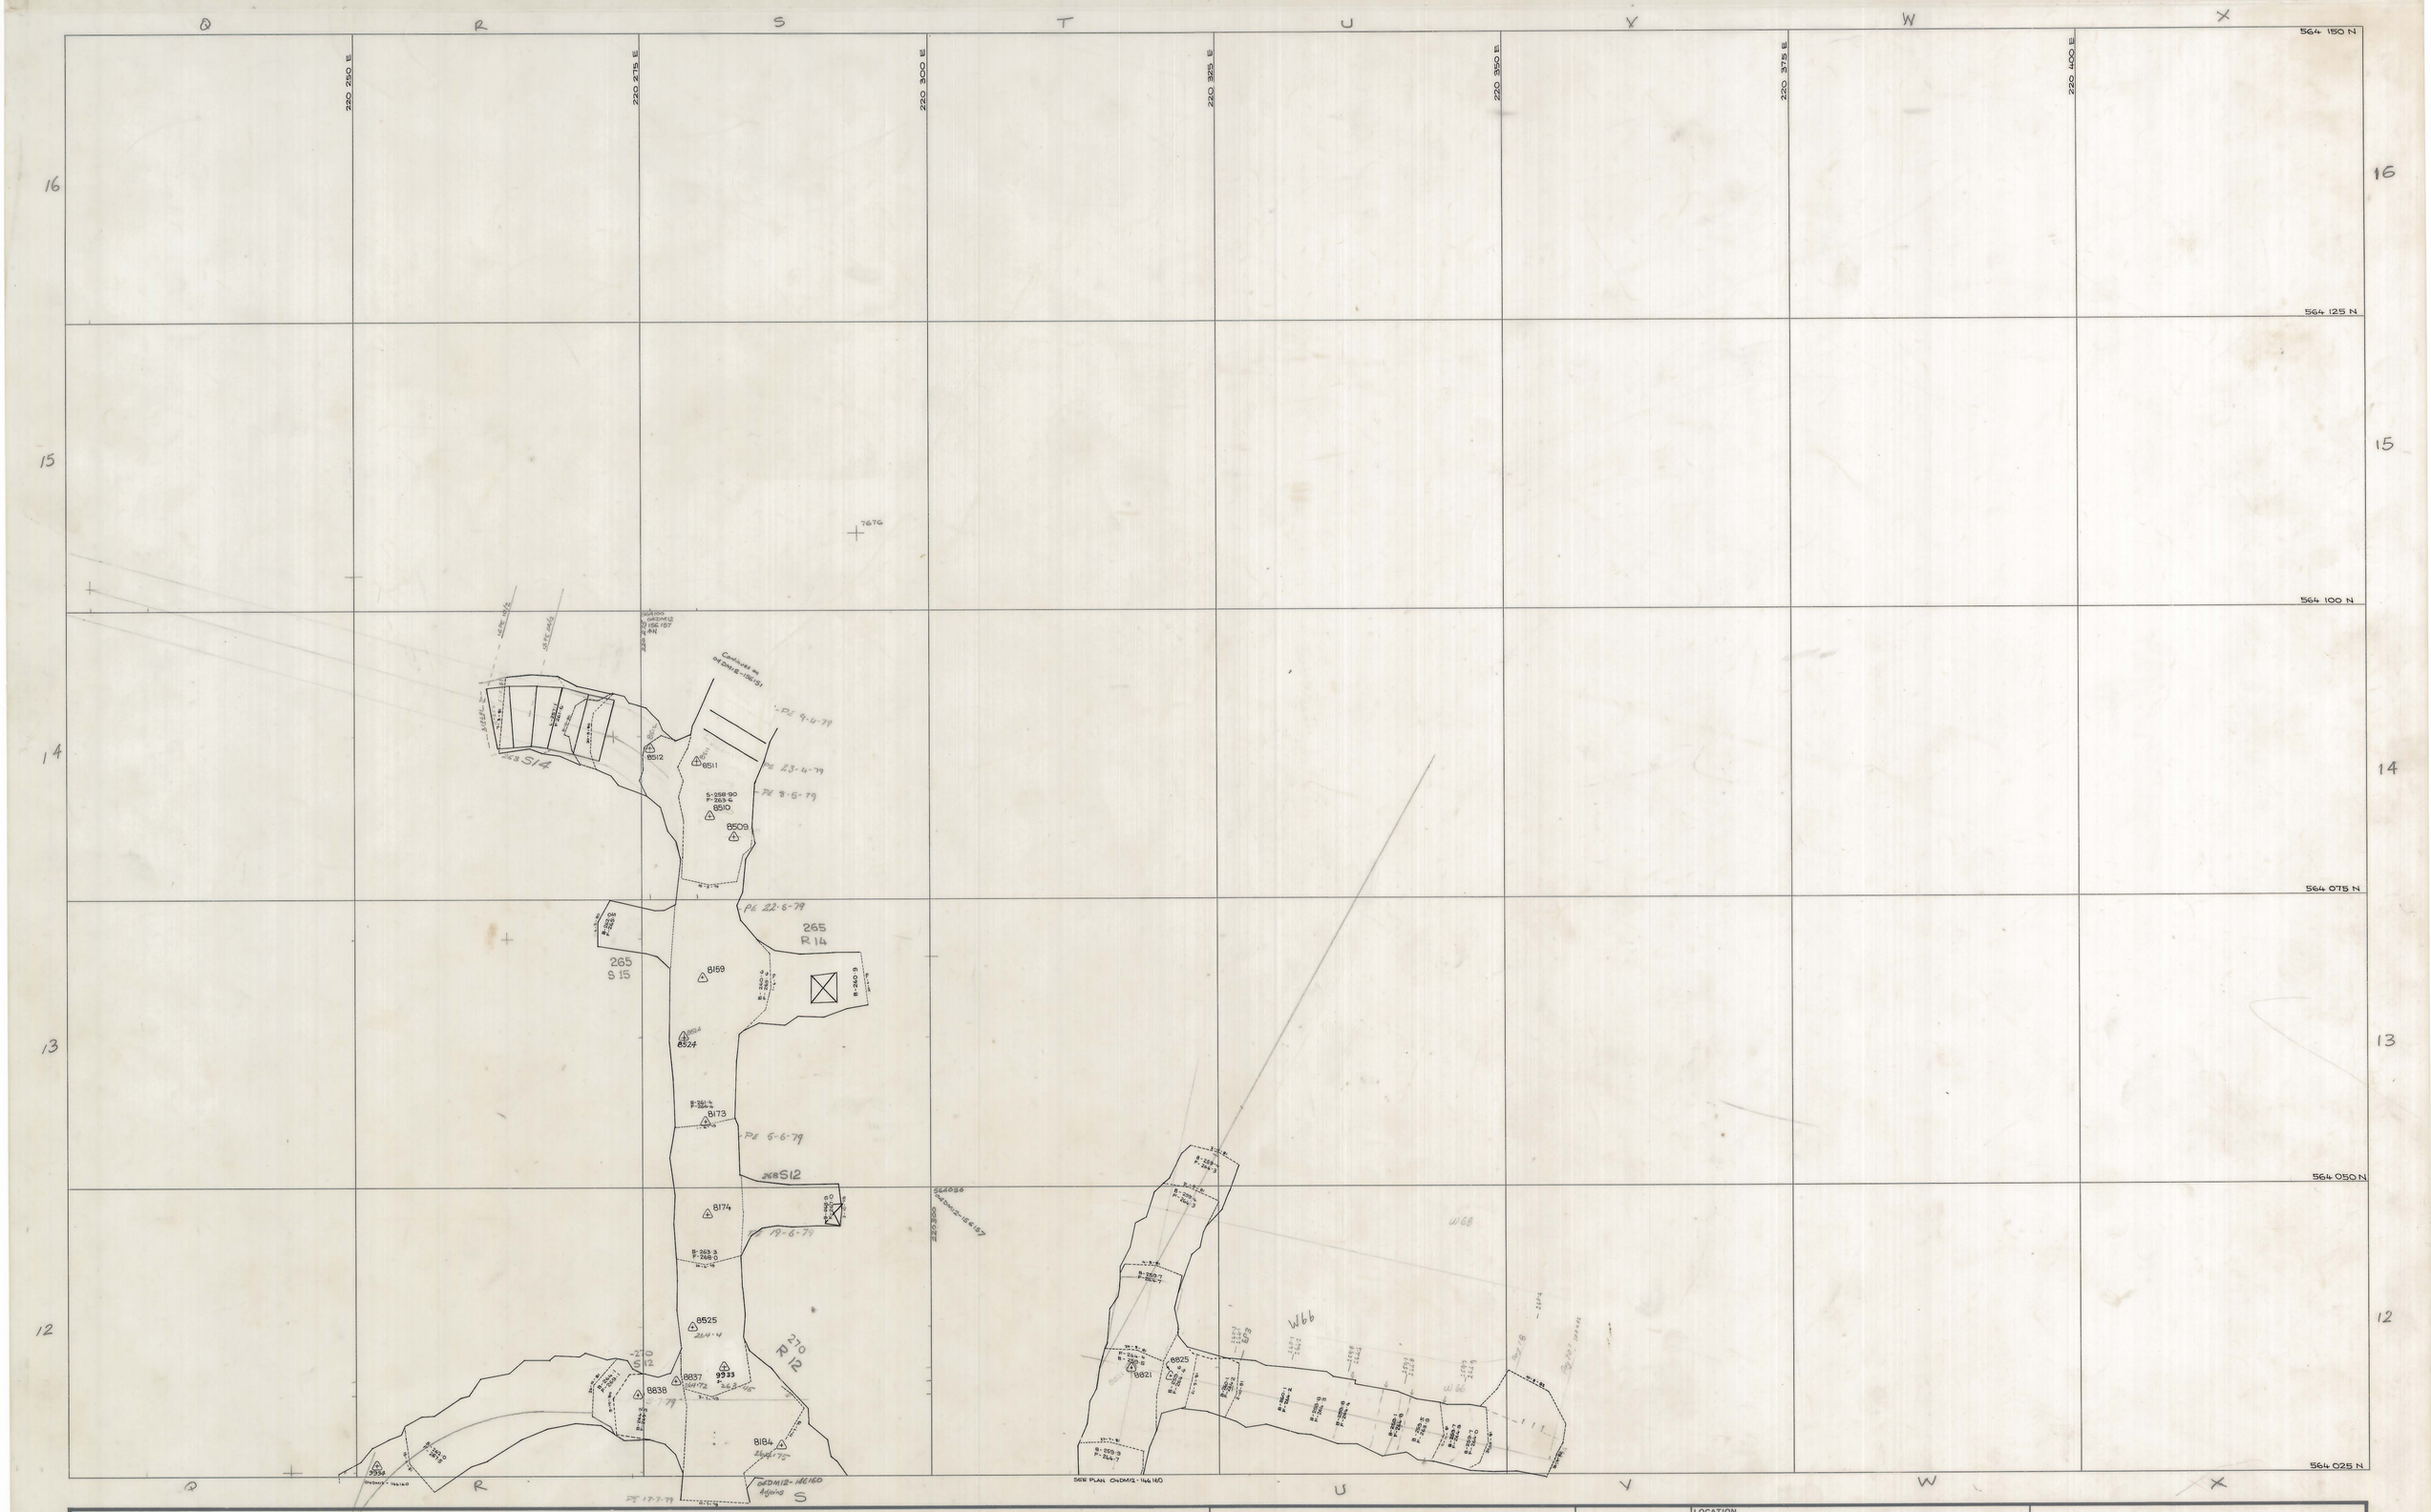

	SCALE 1:250	north	LOCATION: DOLPHIN MINE SUBJECT: MAIN DECLINE

KING ISLAND SCHEELITE
A DIVISION OF WARMAN INTERNATIONAL
GRASSY KING ISLAND
PLAN NUMBER 04DM12 - 156 157