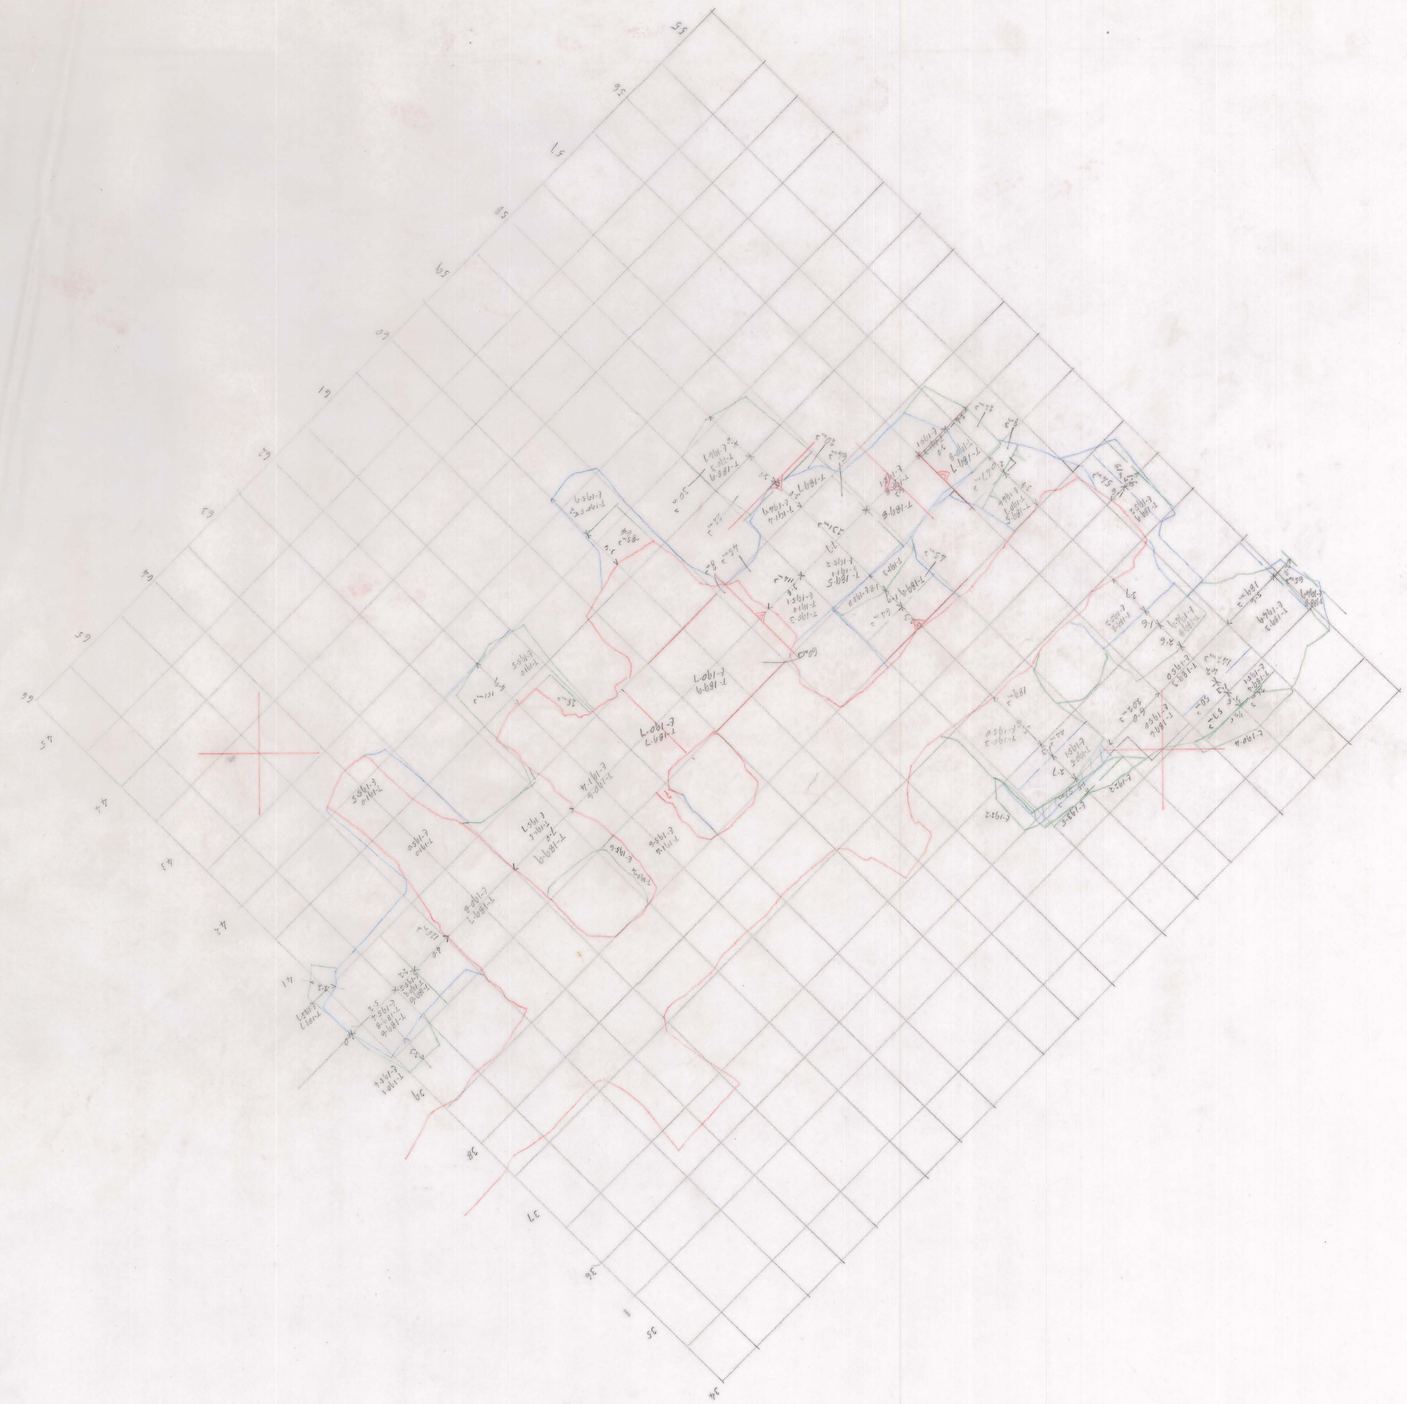

5 cm

0374_8198

OLDM 19 - 145 1345

Sumn
of 030
6.-193