5 cm

-113 C WEDGE
PAY PLAN

0374_2207

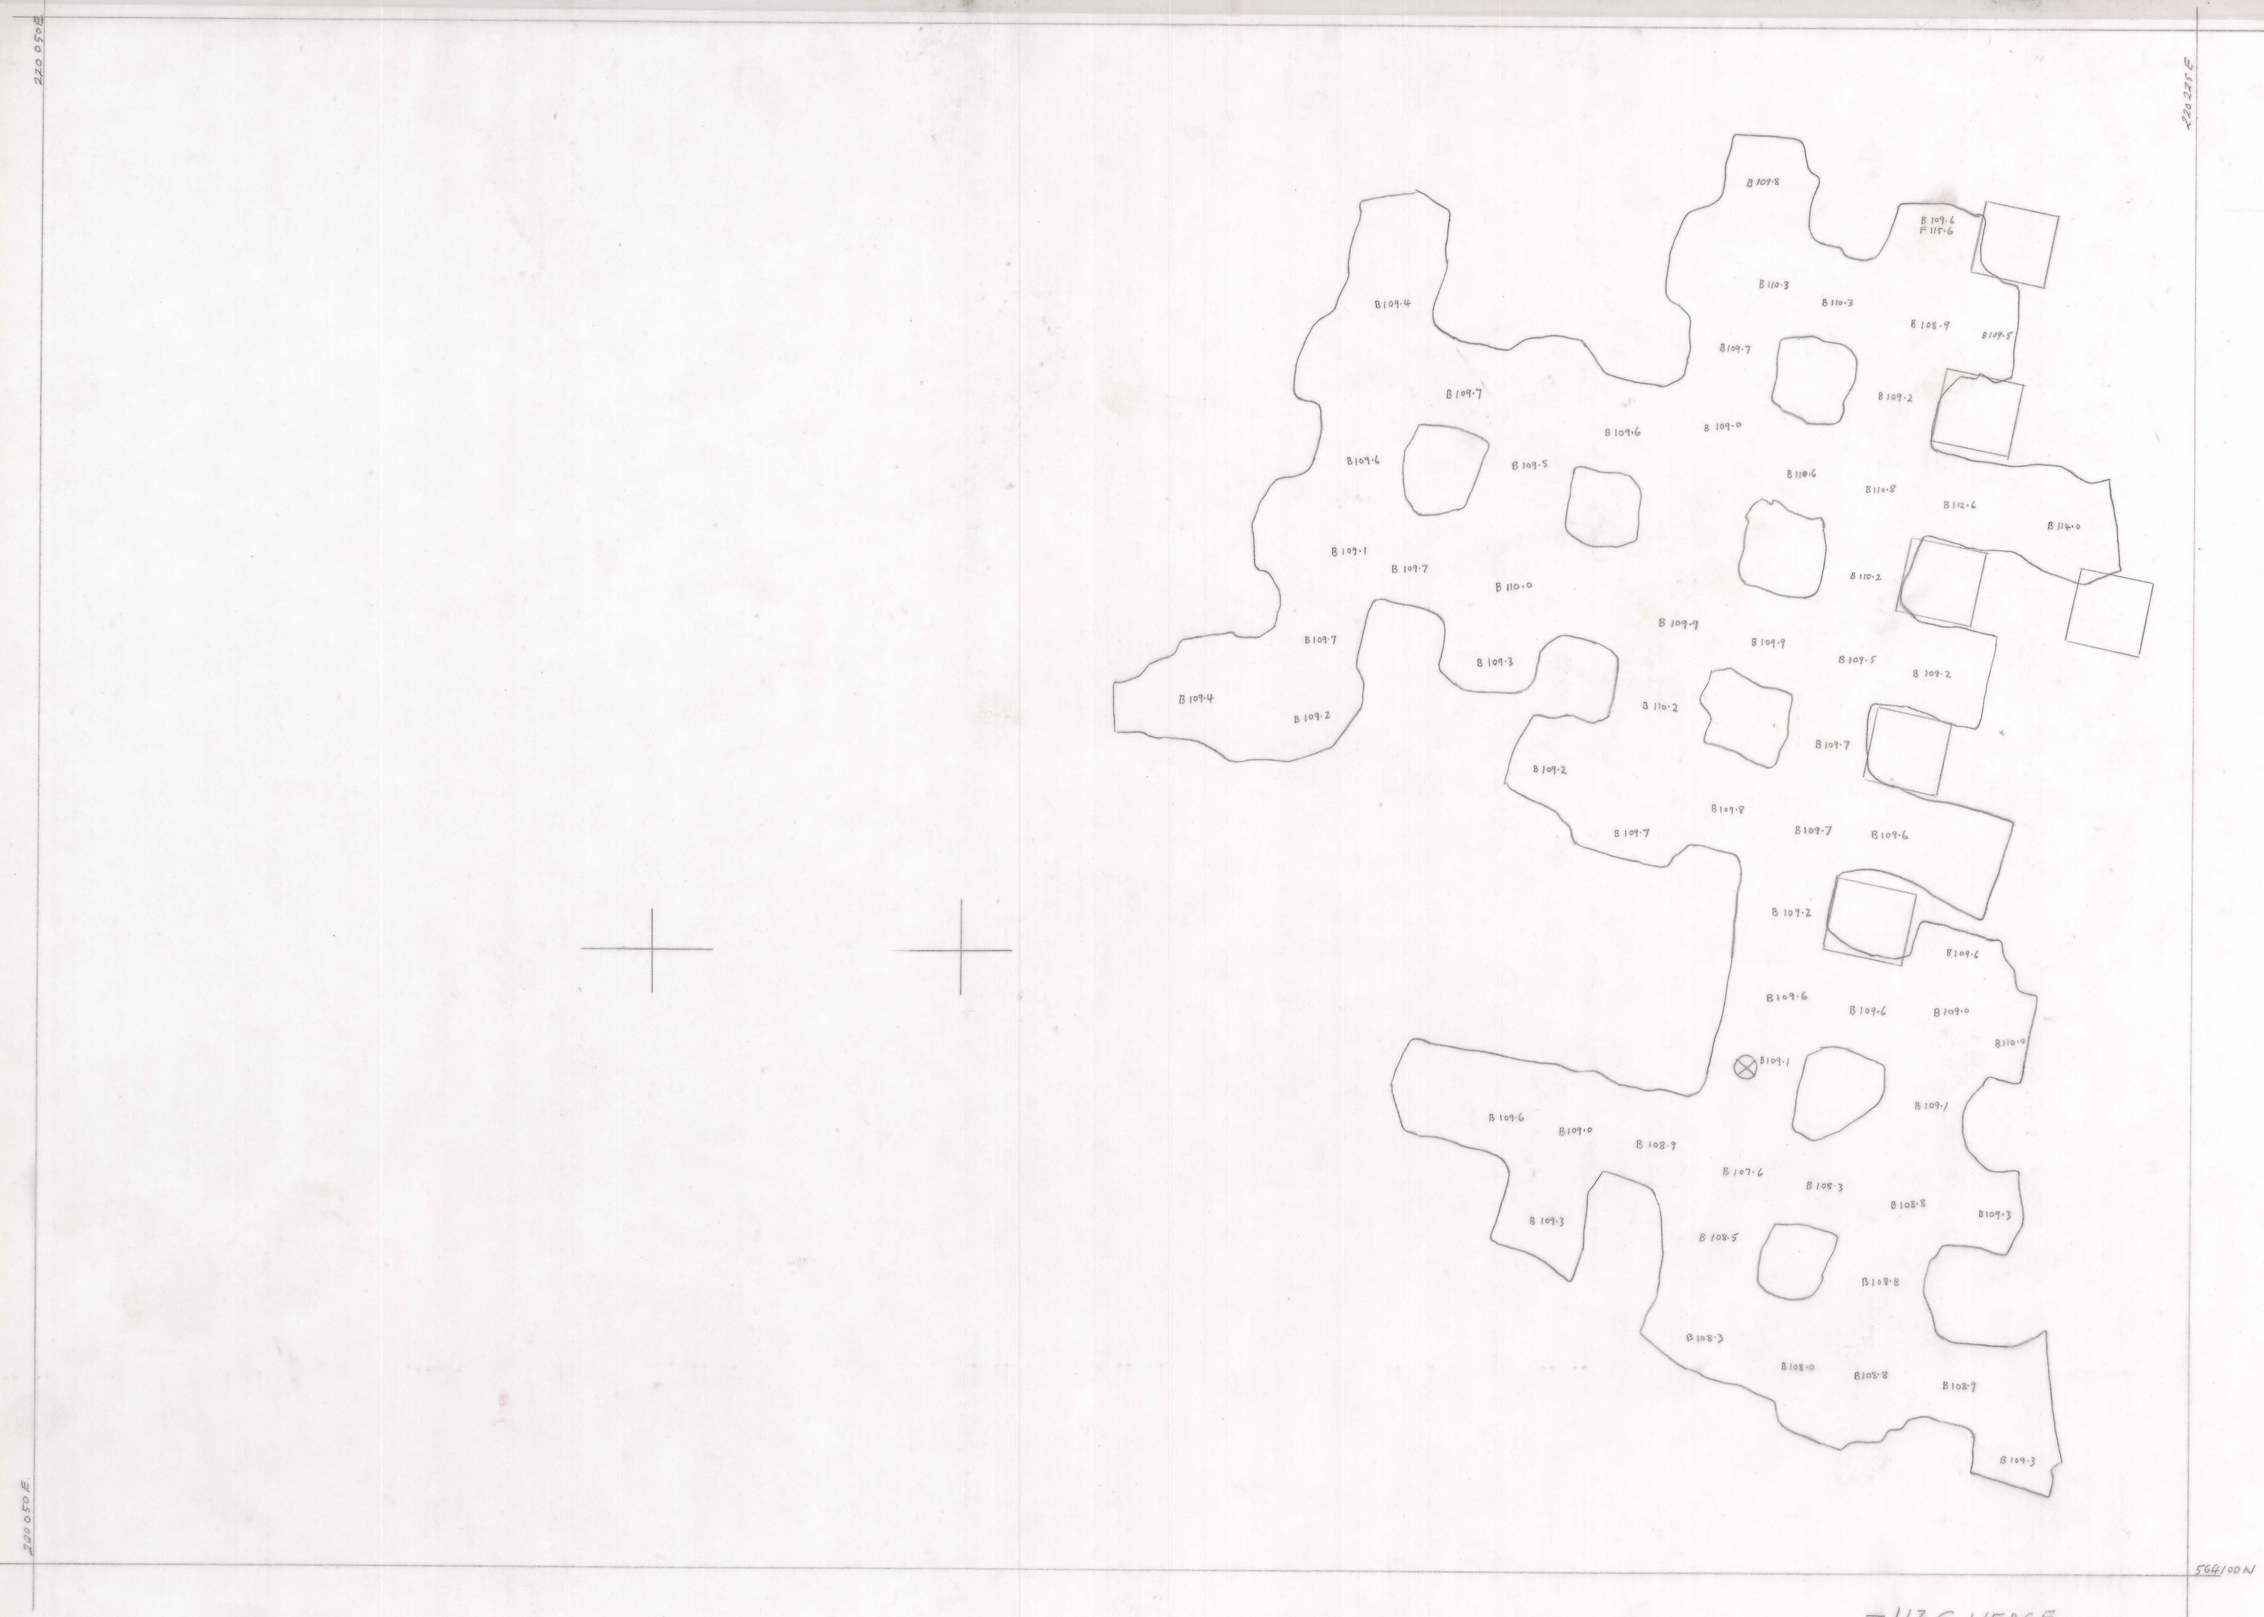

-113 C WEDGE
PAY PLAN.