


0374_2215



135 C. CENTRAL
040813 - 155115

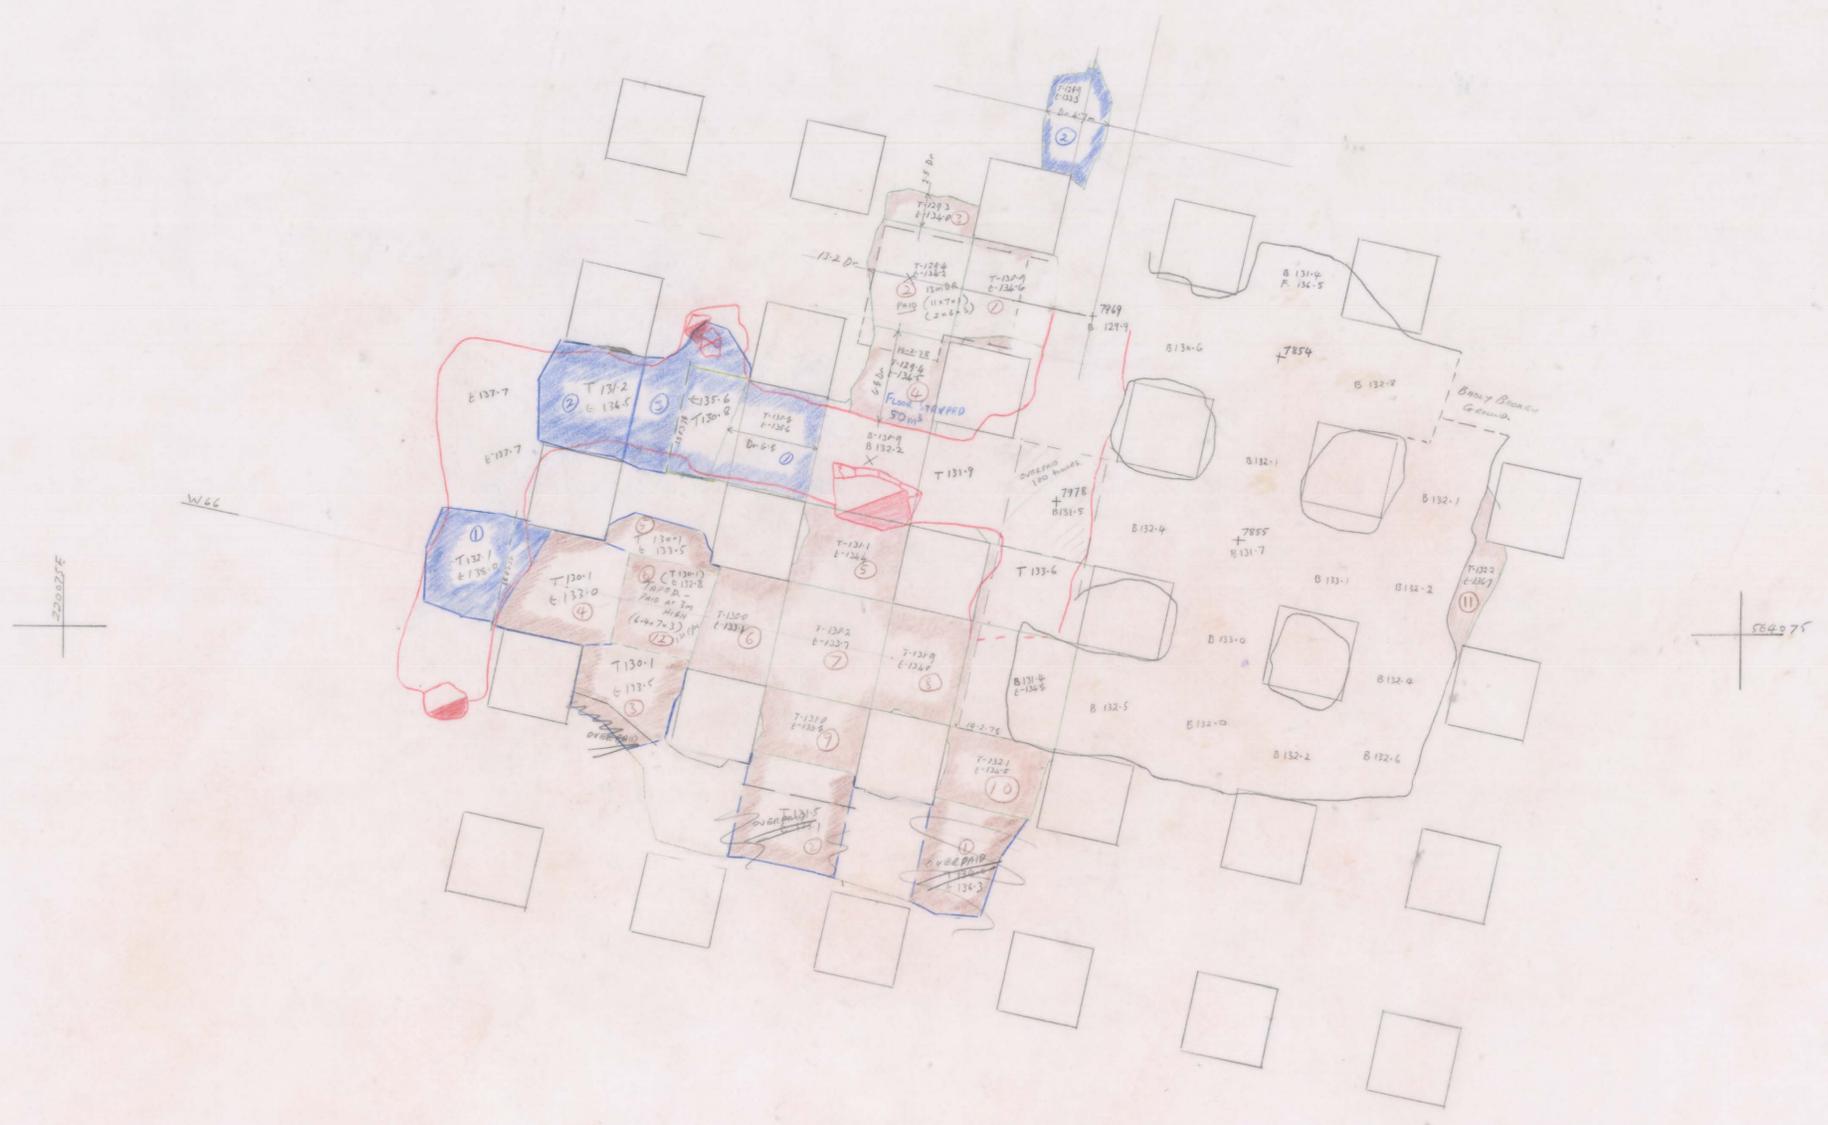

220 025 E

560 025 N

135 C. CENTRAL.
PAY PLAN.