
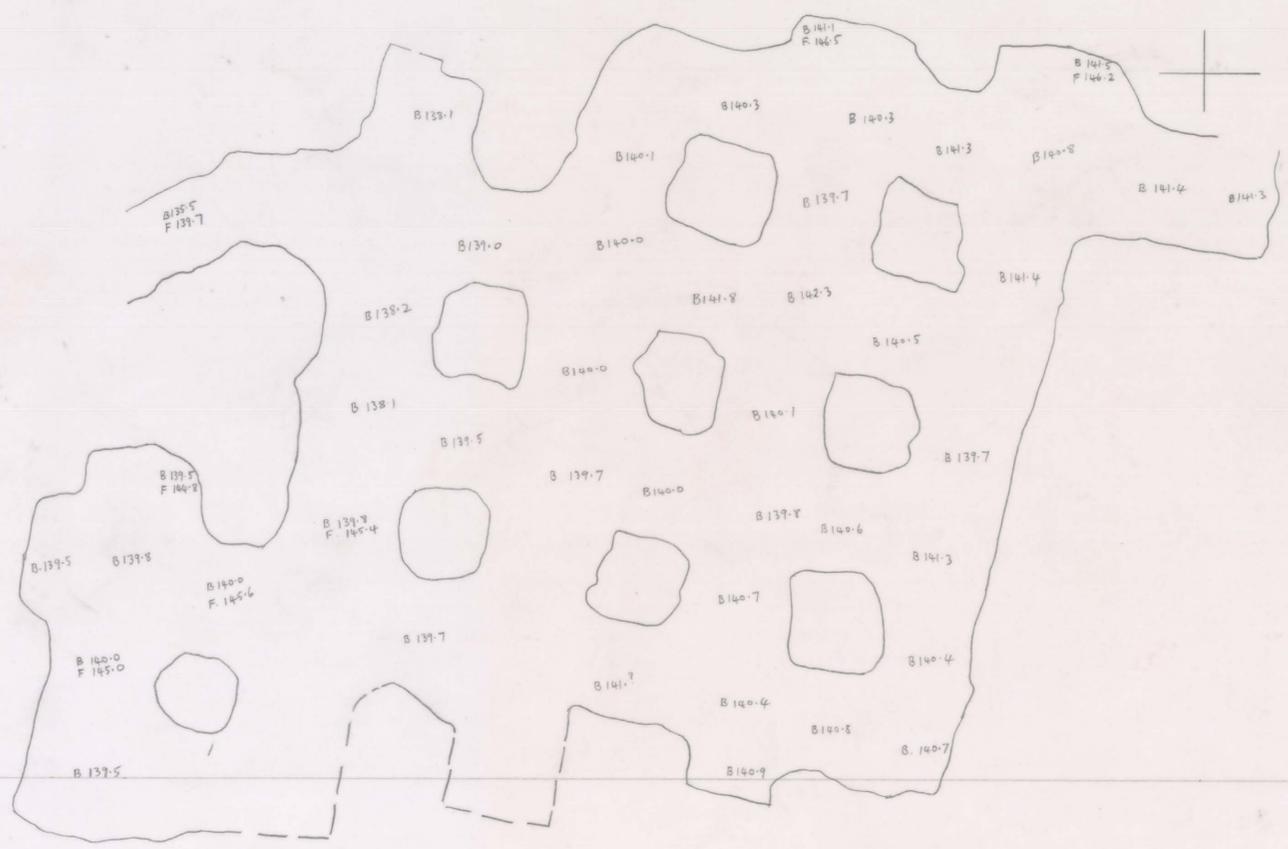


564125 N

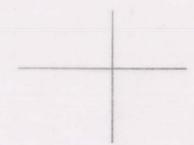

217750 E

564025 N