

0374_2233

04DM19-1078

DM
C Wedge
-122+127-5 1976
1:150

See 04DM11-1390

220 240 E


564 200 N

190

564 170 N

220 240 E

See 04DM11-1101

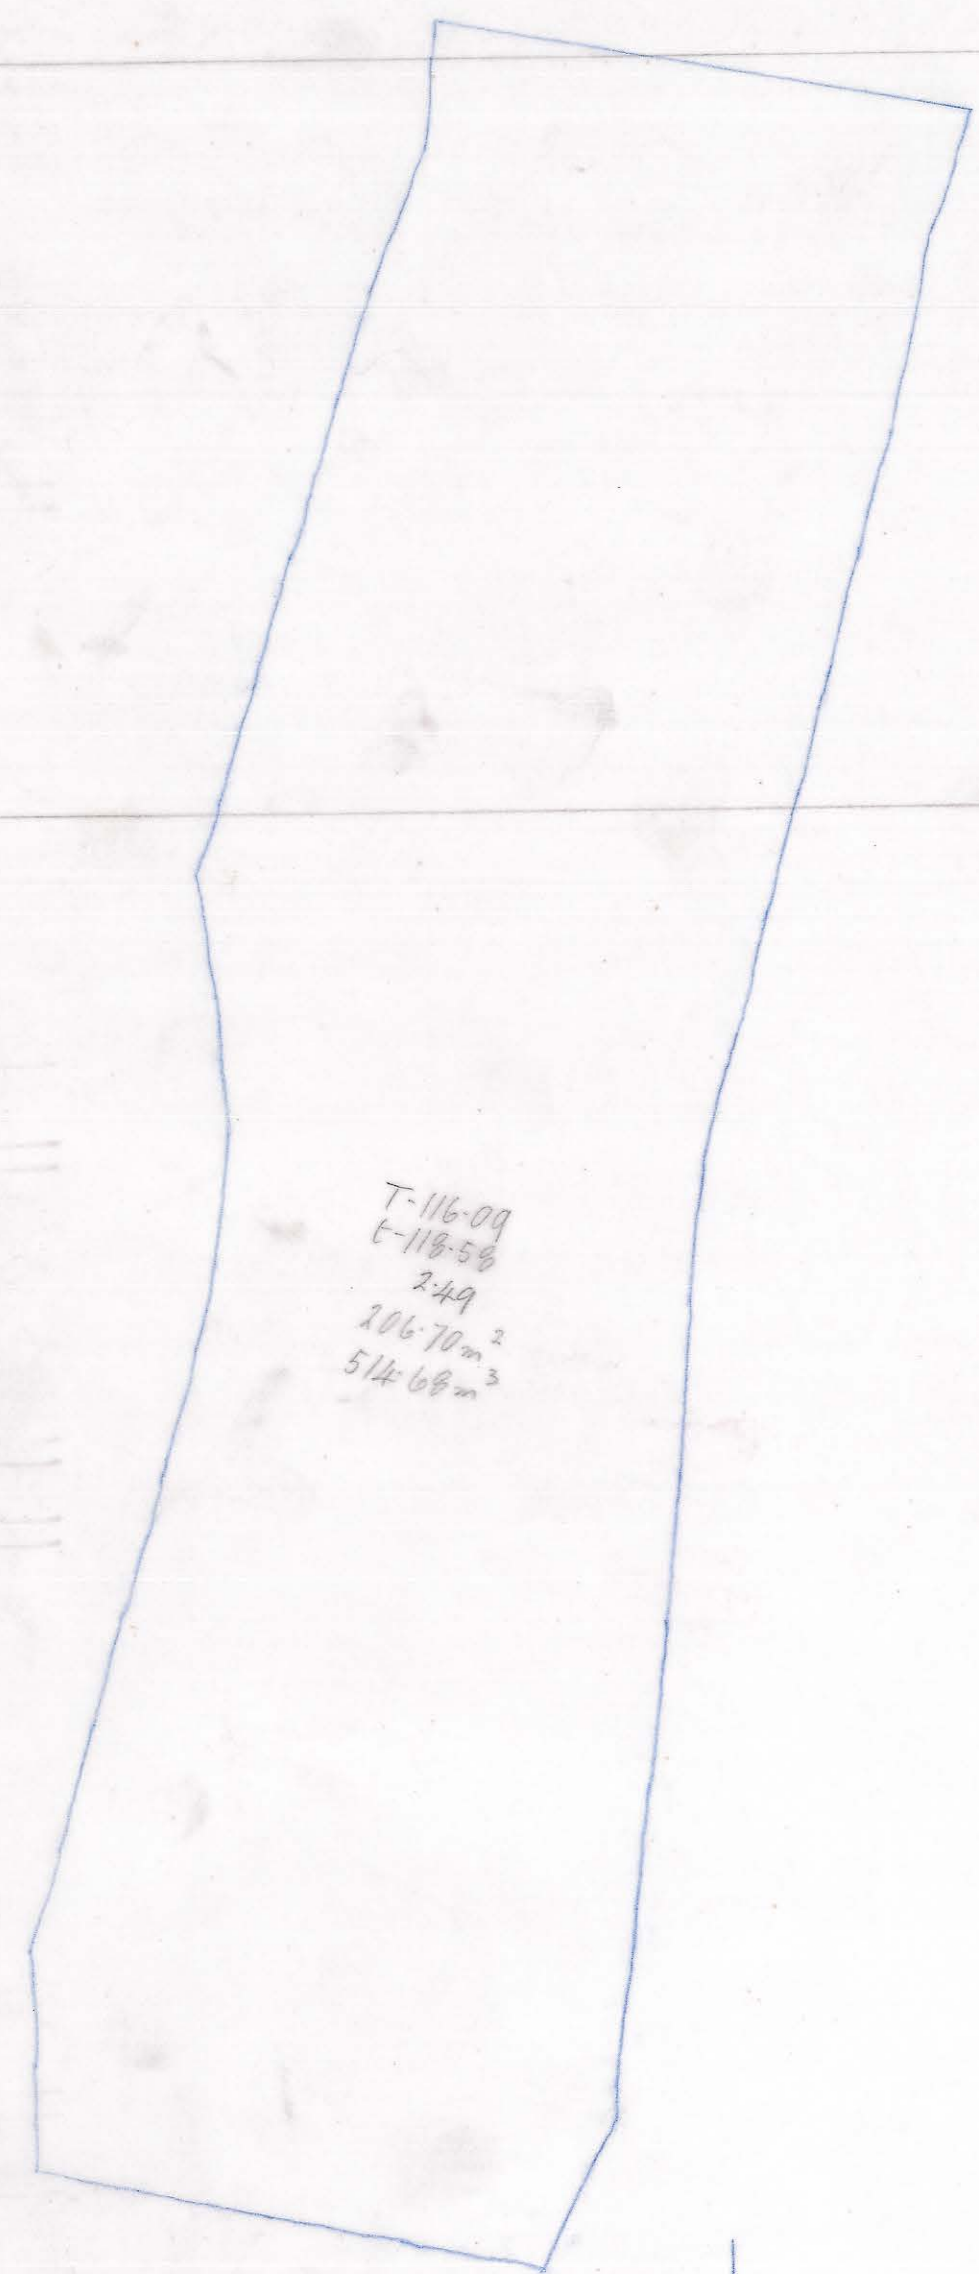

564 120
220 220