
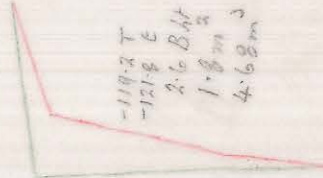


5 cm

0374_2257

04DM19-1073

DM
C Wedge
130/122
1-100
1976

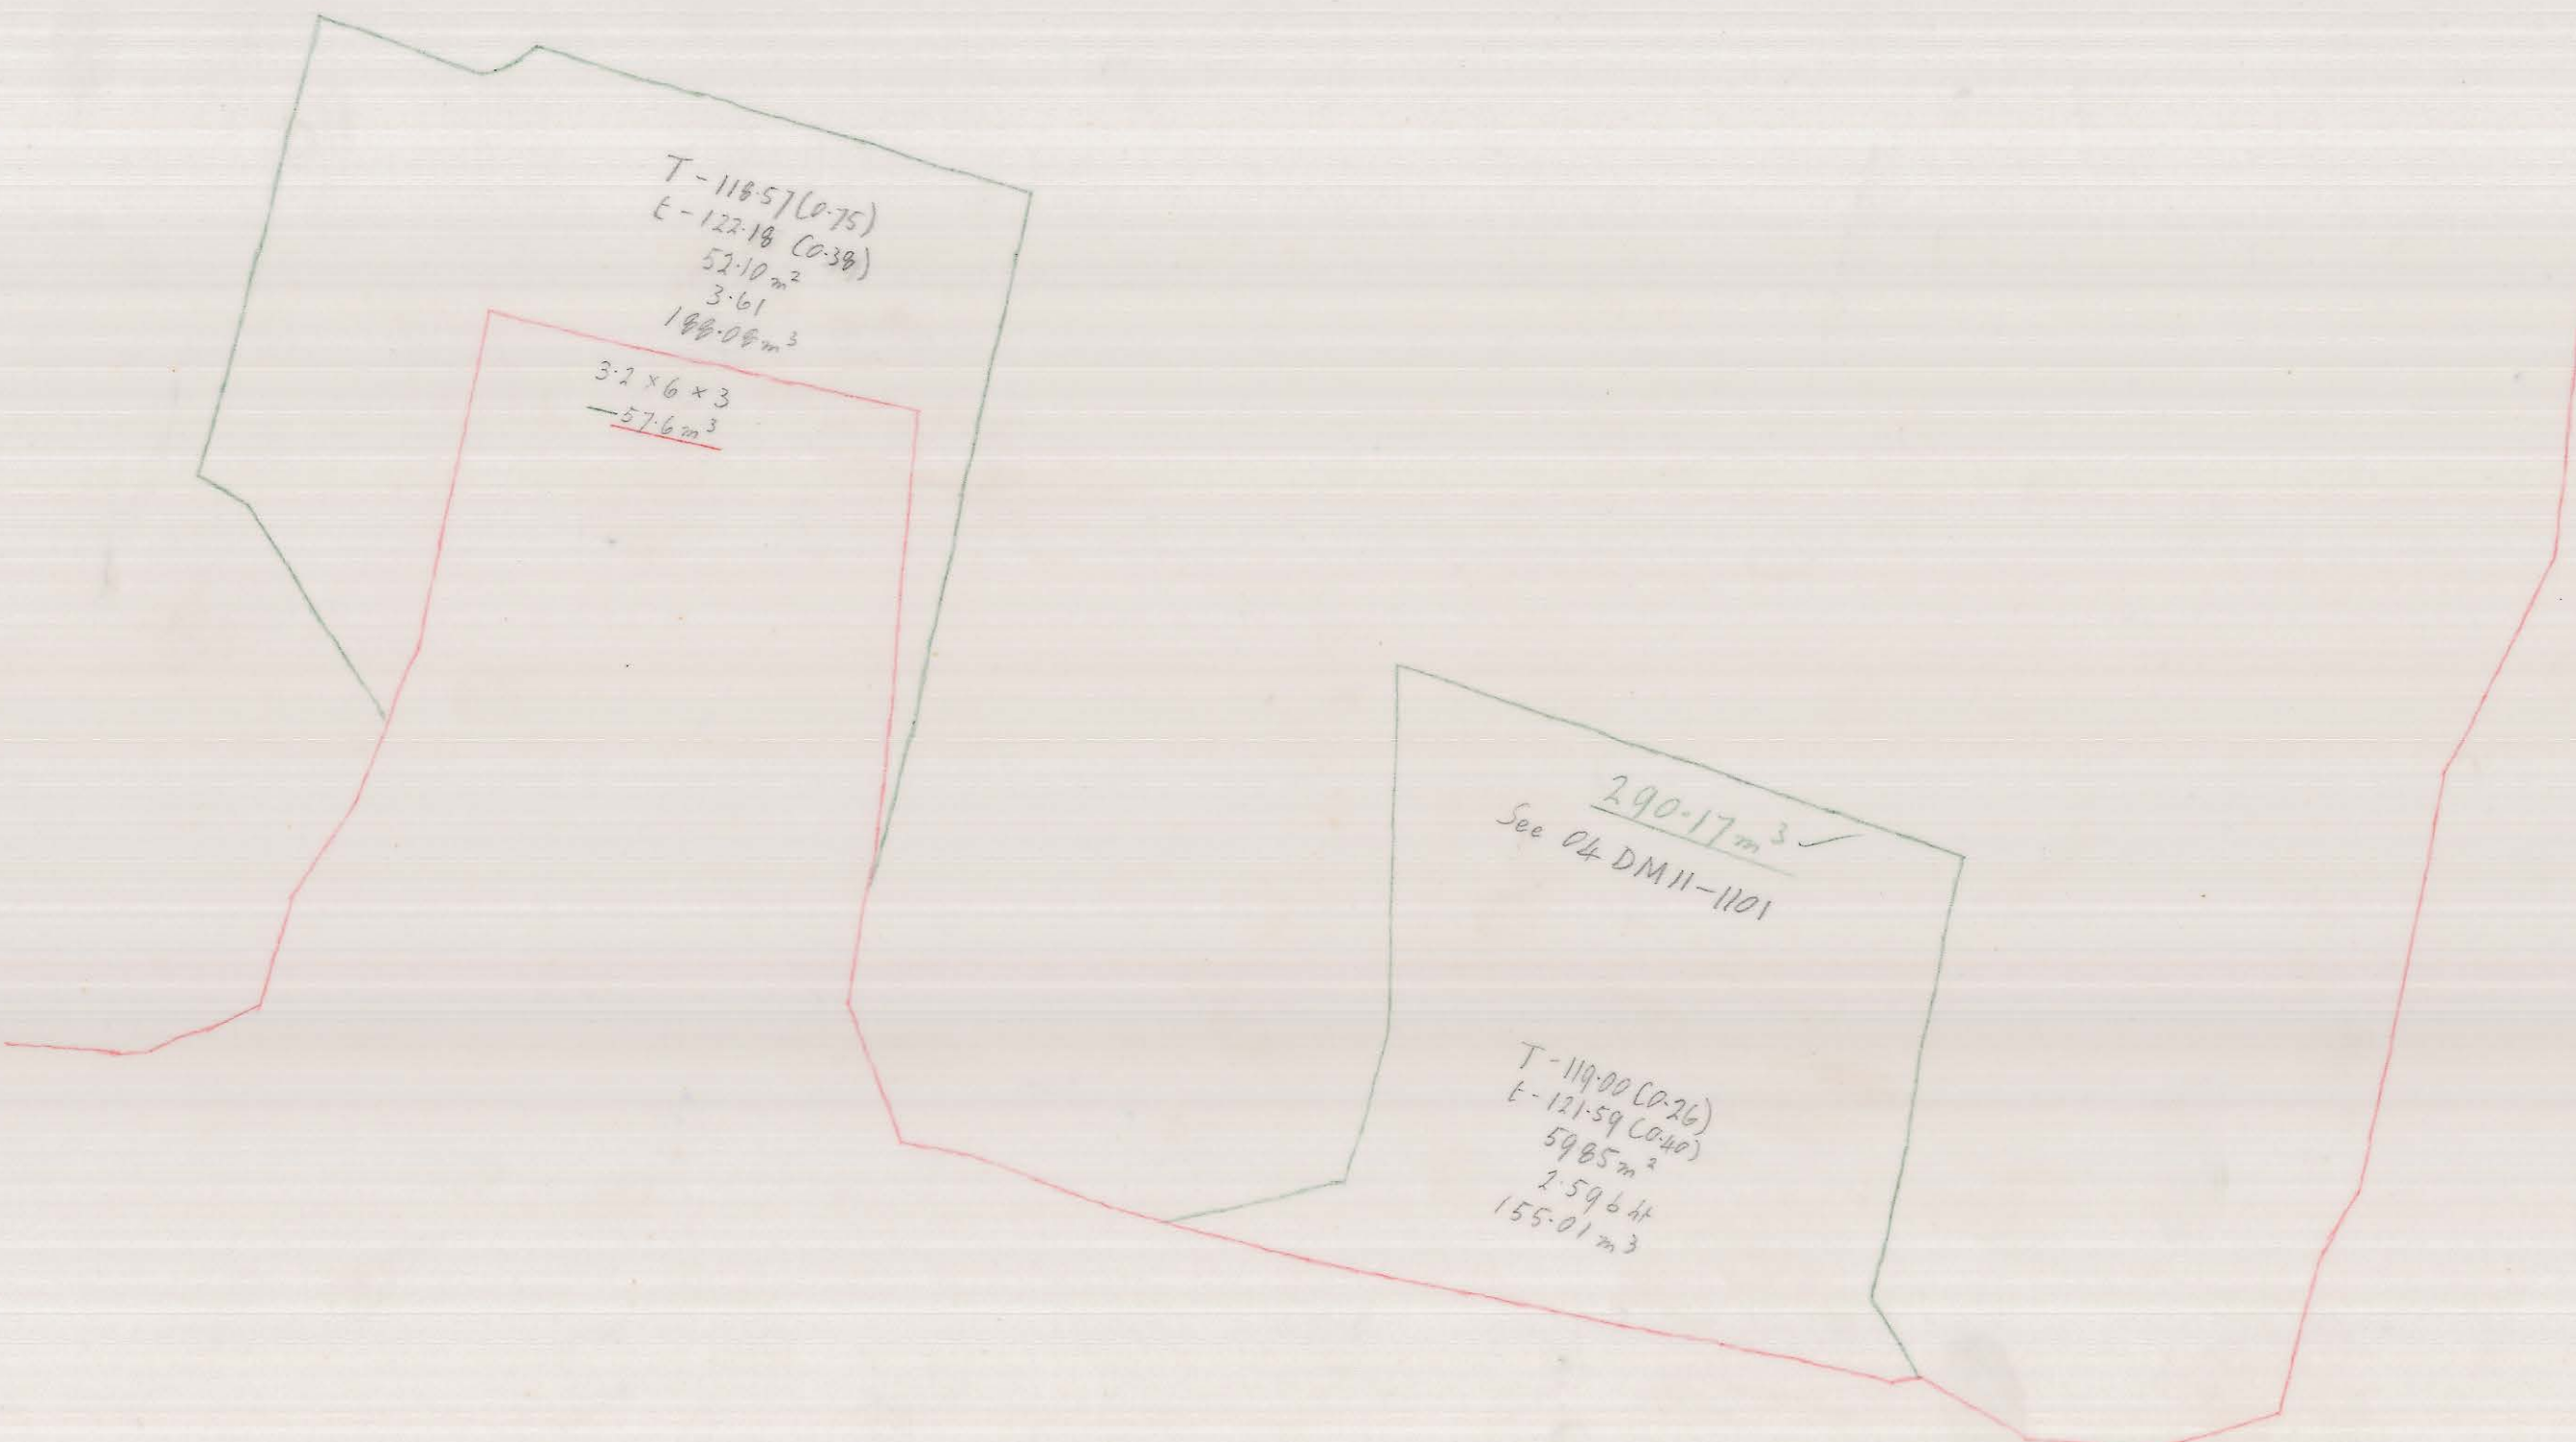

564 200N
220 240E

564 150N

230 100E

230 100E