070/190
F-137-0

5 cm

0LDM 19-145 116

DM
C. Central
E-138-5
1:100

0374_2287

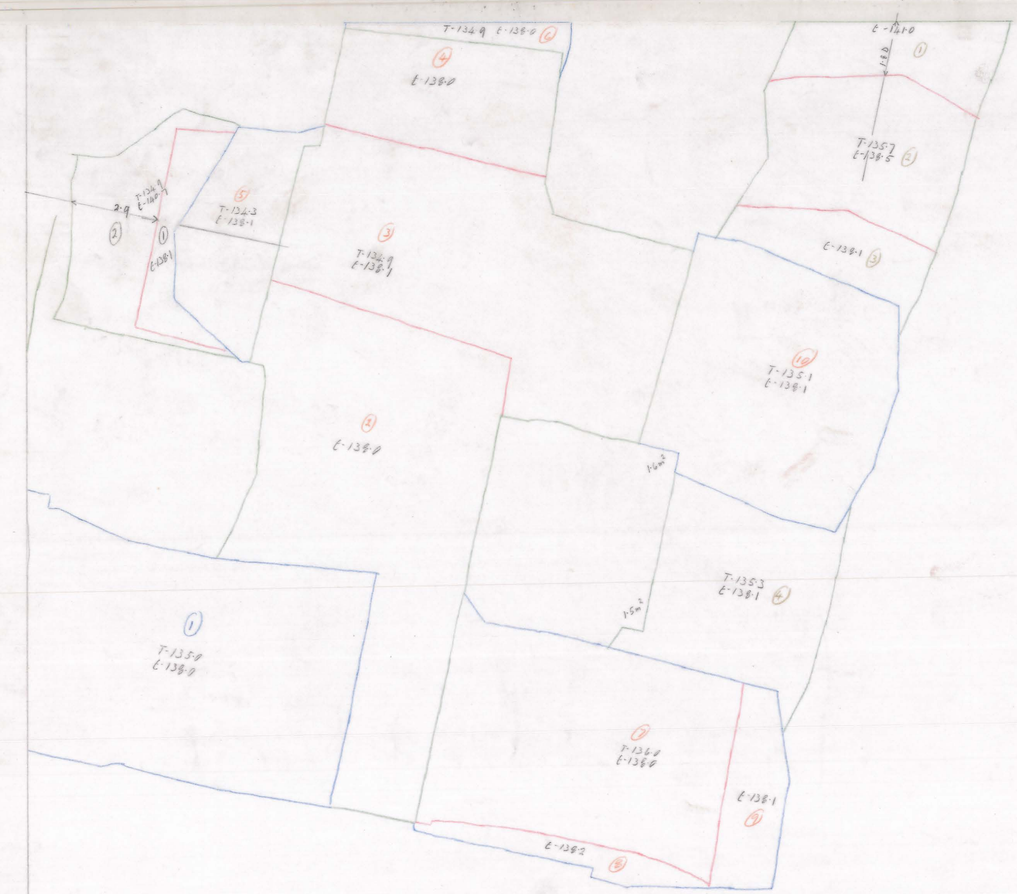

222 152 E
222 232 E
566 040 N