27 JUN 1981

0374 - 229

04BH14 - 1003
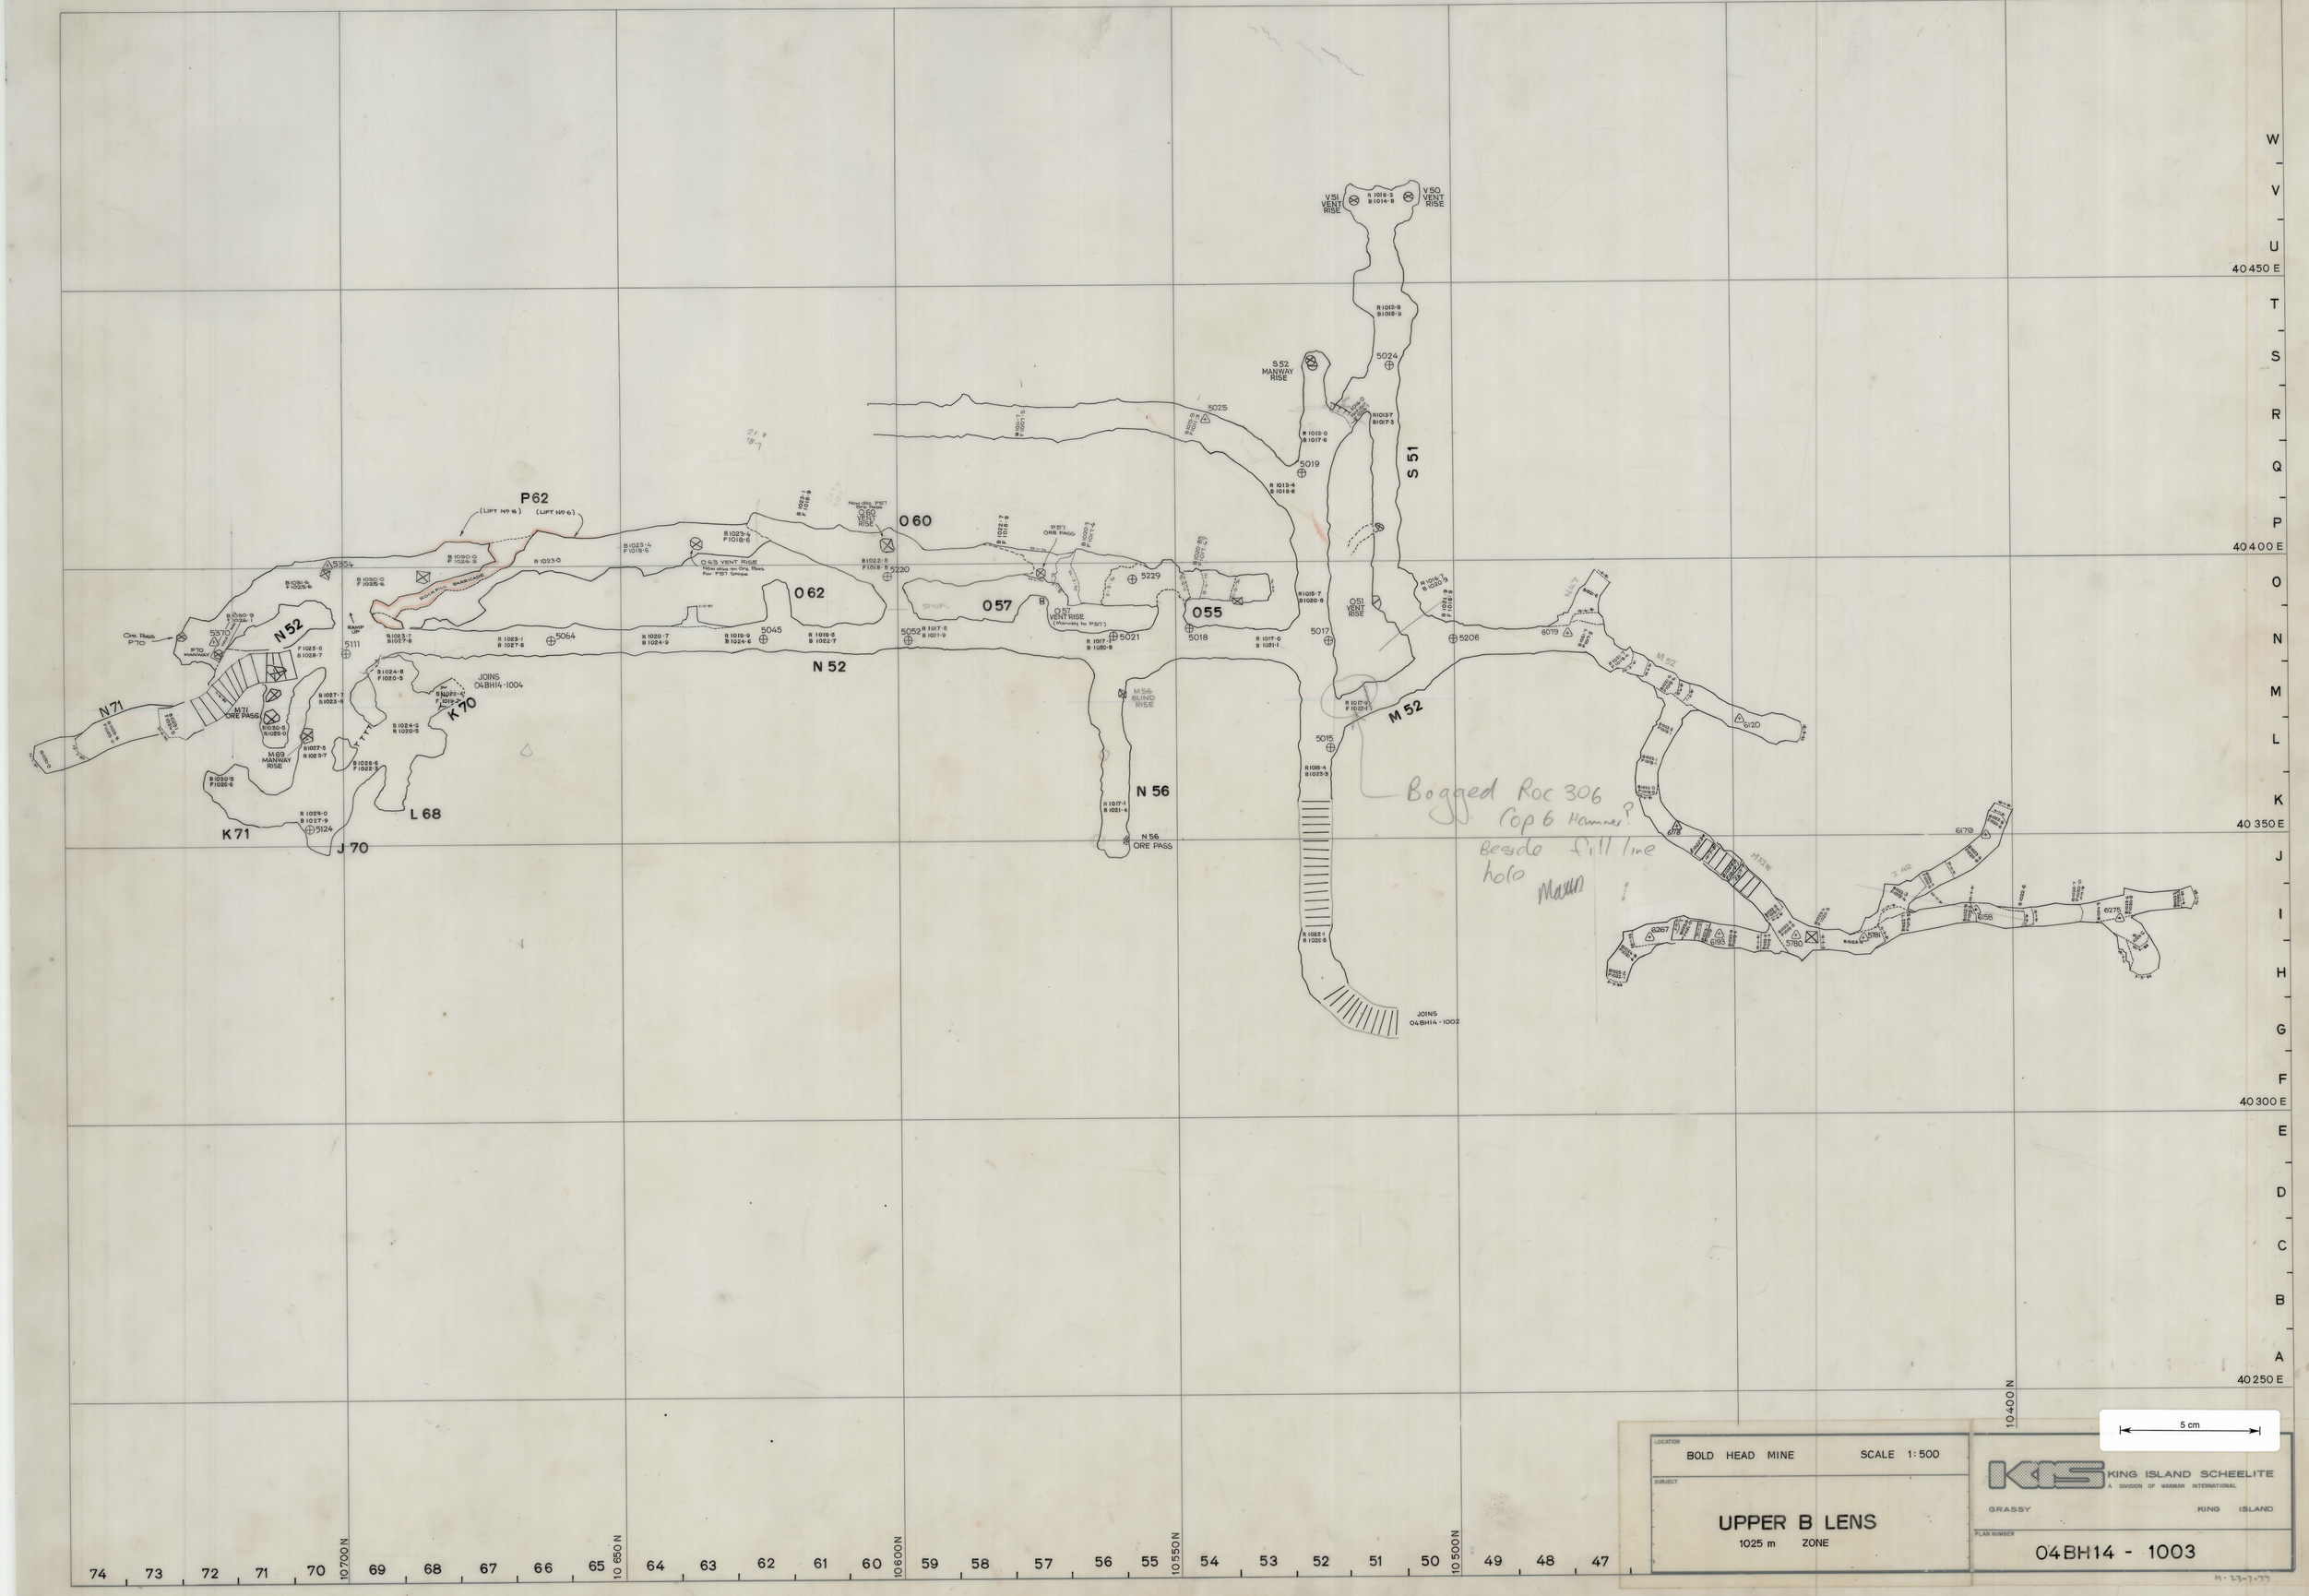
1:500
Bold Head Mine
Upper B Lens
1-5 - 106