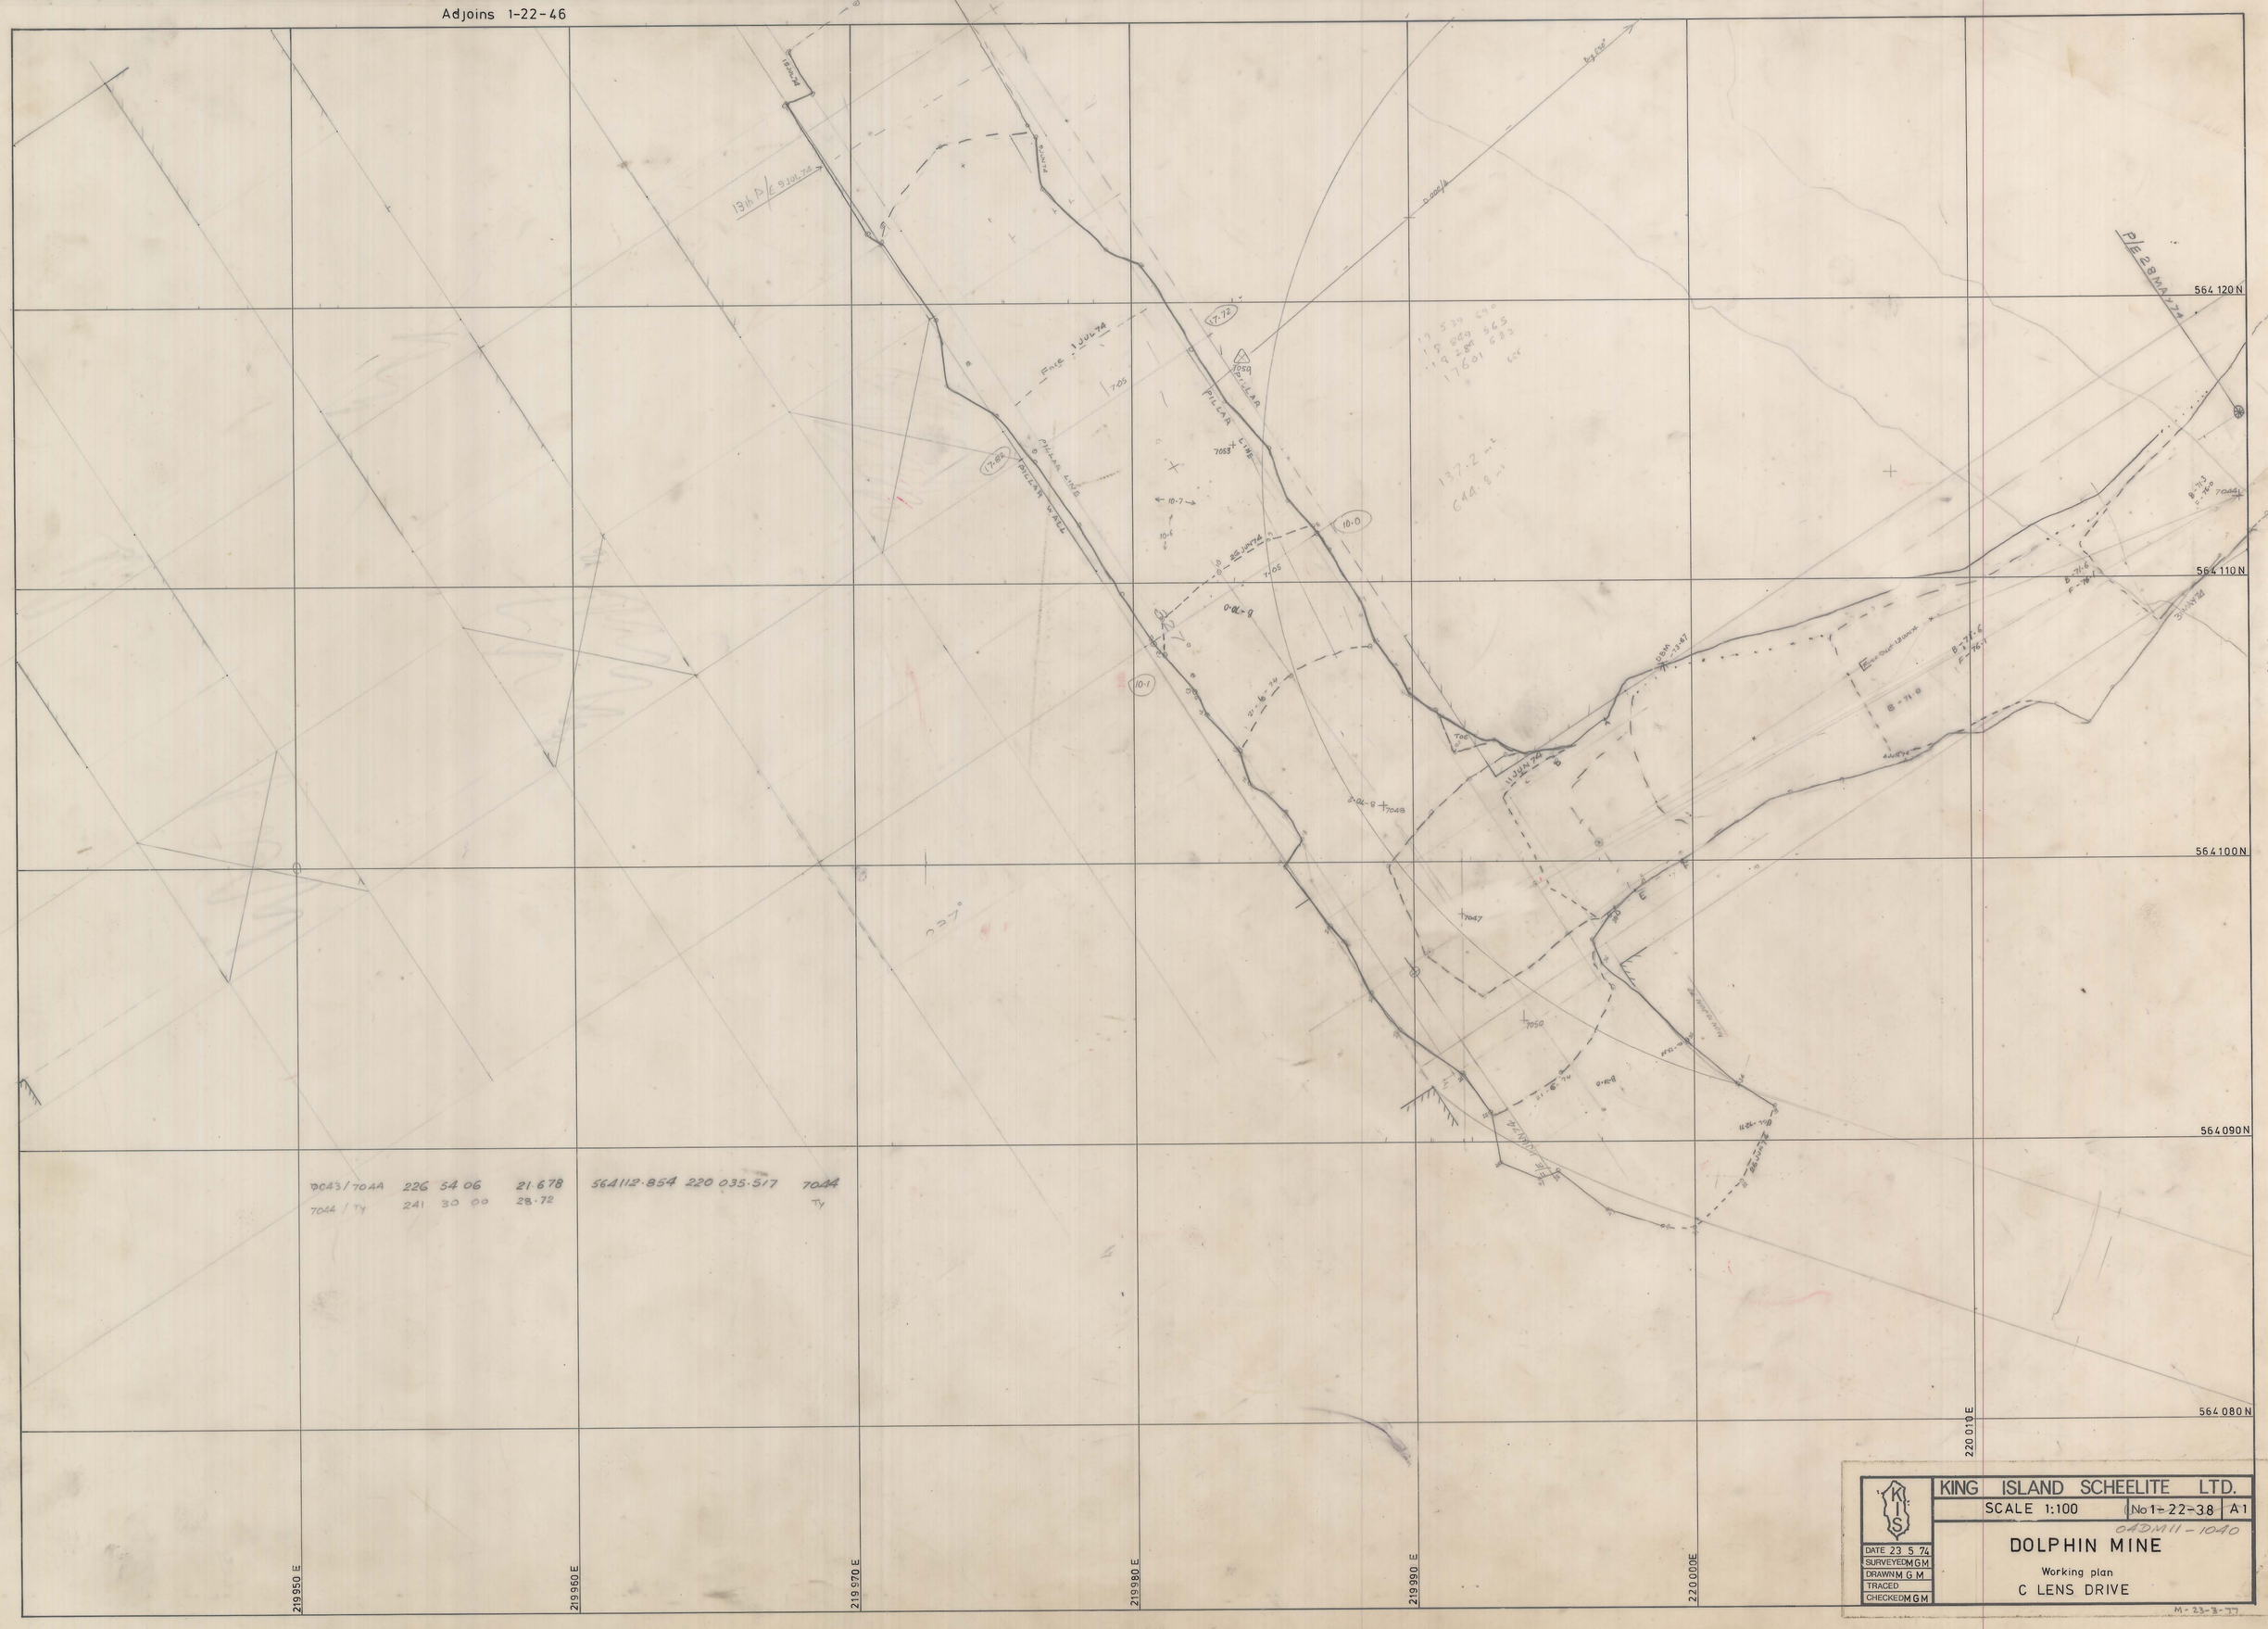5 cm
0374_2295
04DM11-1040
DOLPHIN MINE
EAST END C LENS DRIVE
1-22-38
04DM11-1040