5 cm

0374_2301

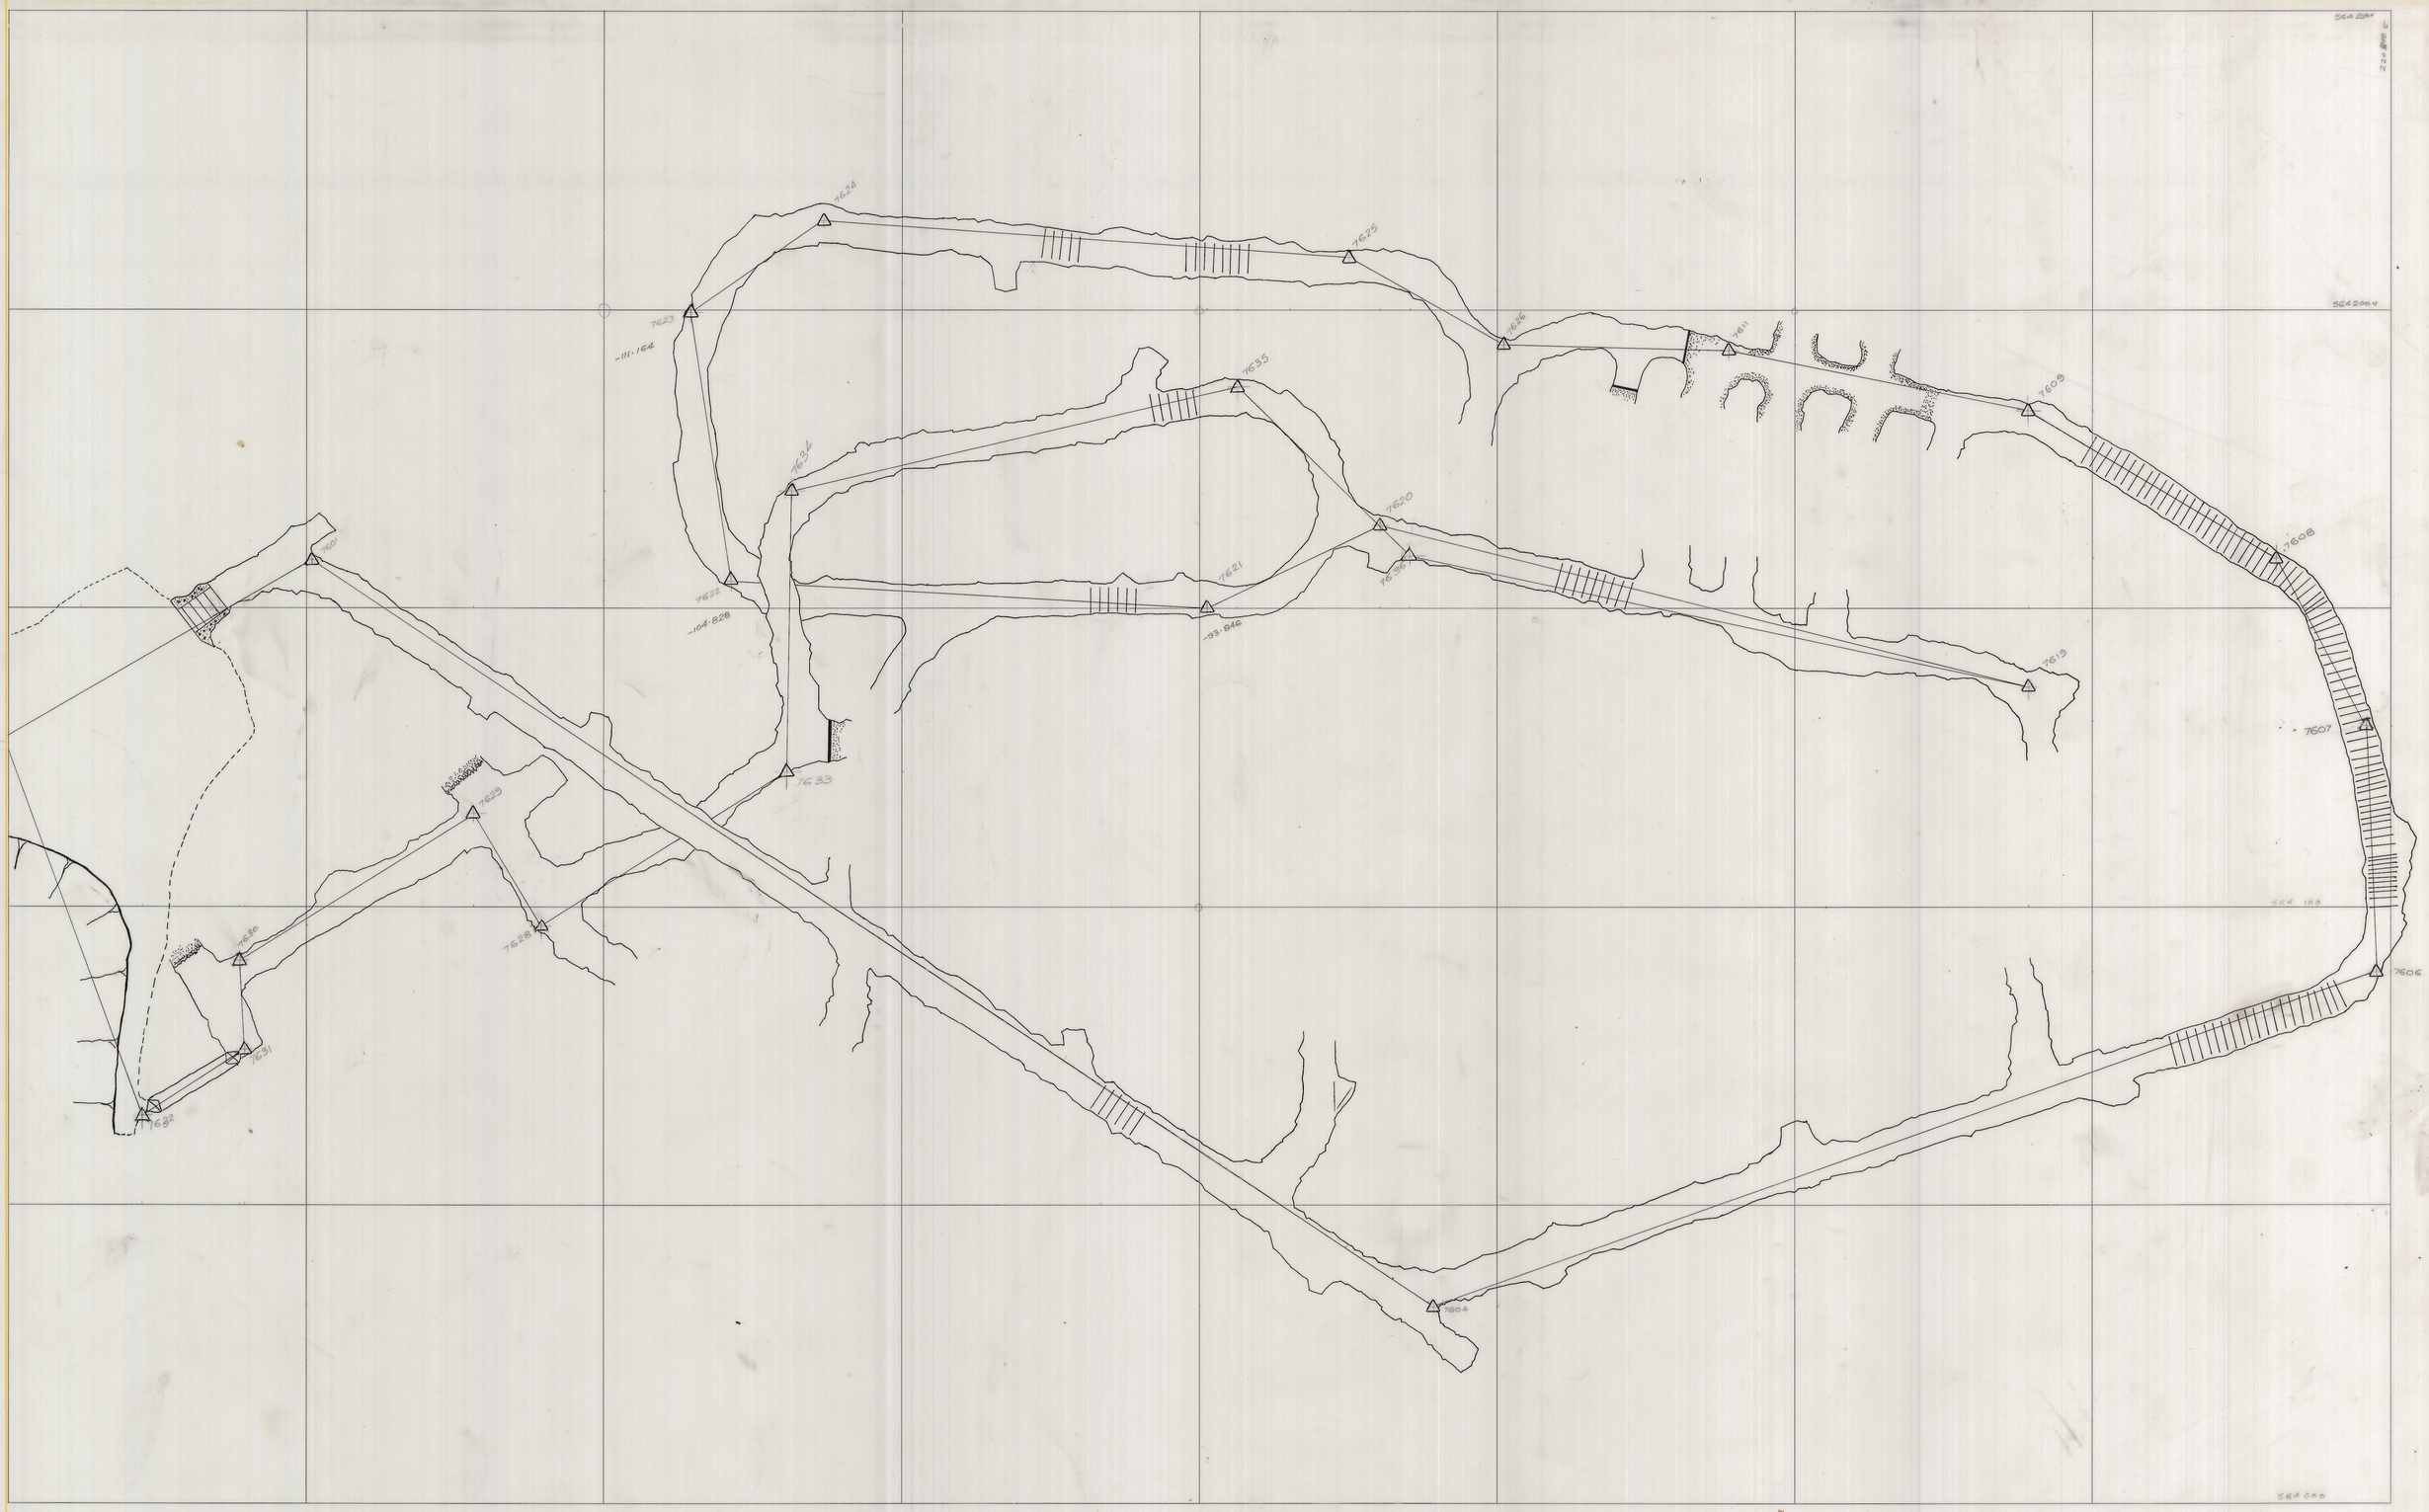

	SCALE 1	north	LOCATION DOLPHIN MINE SUBJECT
			KING ISLAND SCHEELITE A DIVISION OF WARMAN INTERNATIONAL GRASSY KING ISLAND PLAN NUMBER