5 cm
0374_2303
04DM11-1030
DOLPHIN. 100 scale G14 RAMP 1-22-45

1-22-38 Adjoins
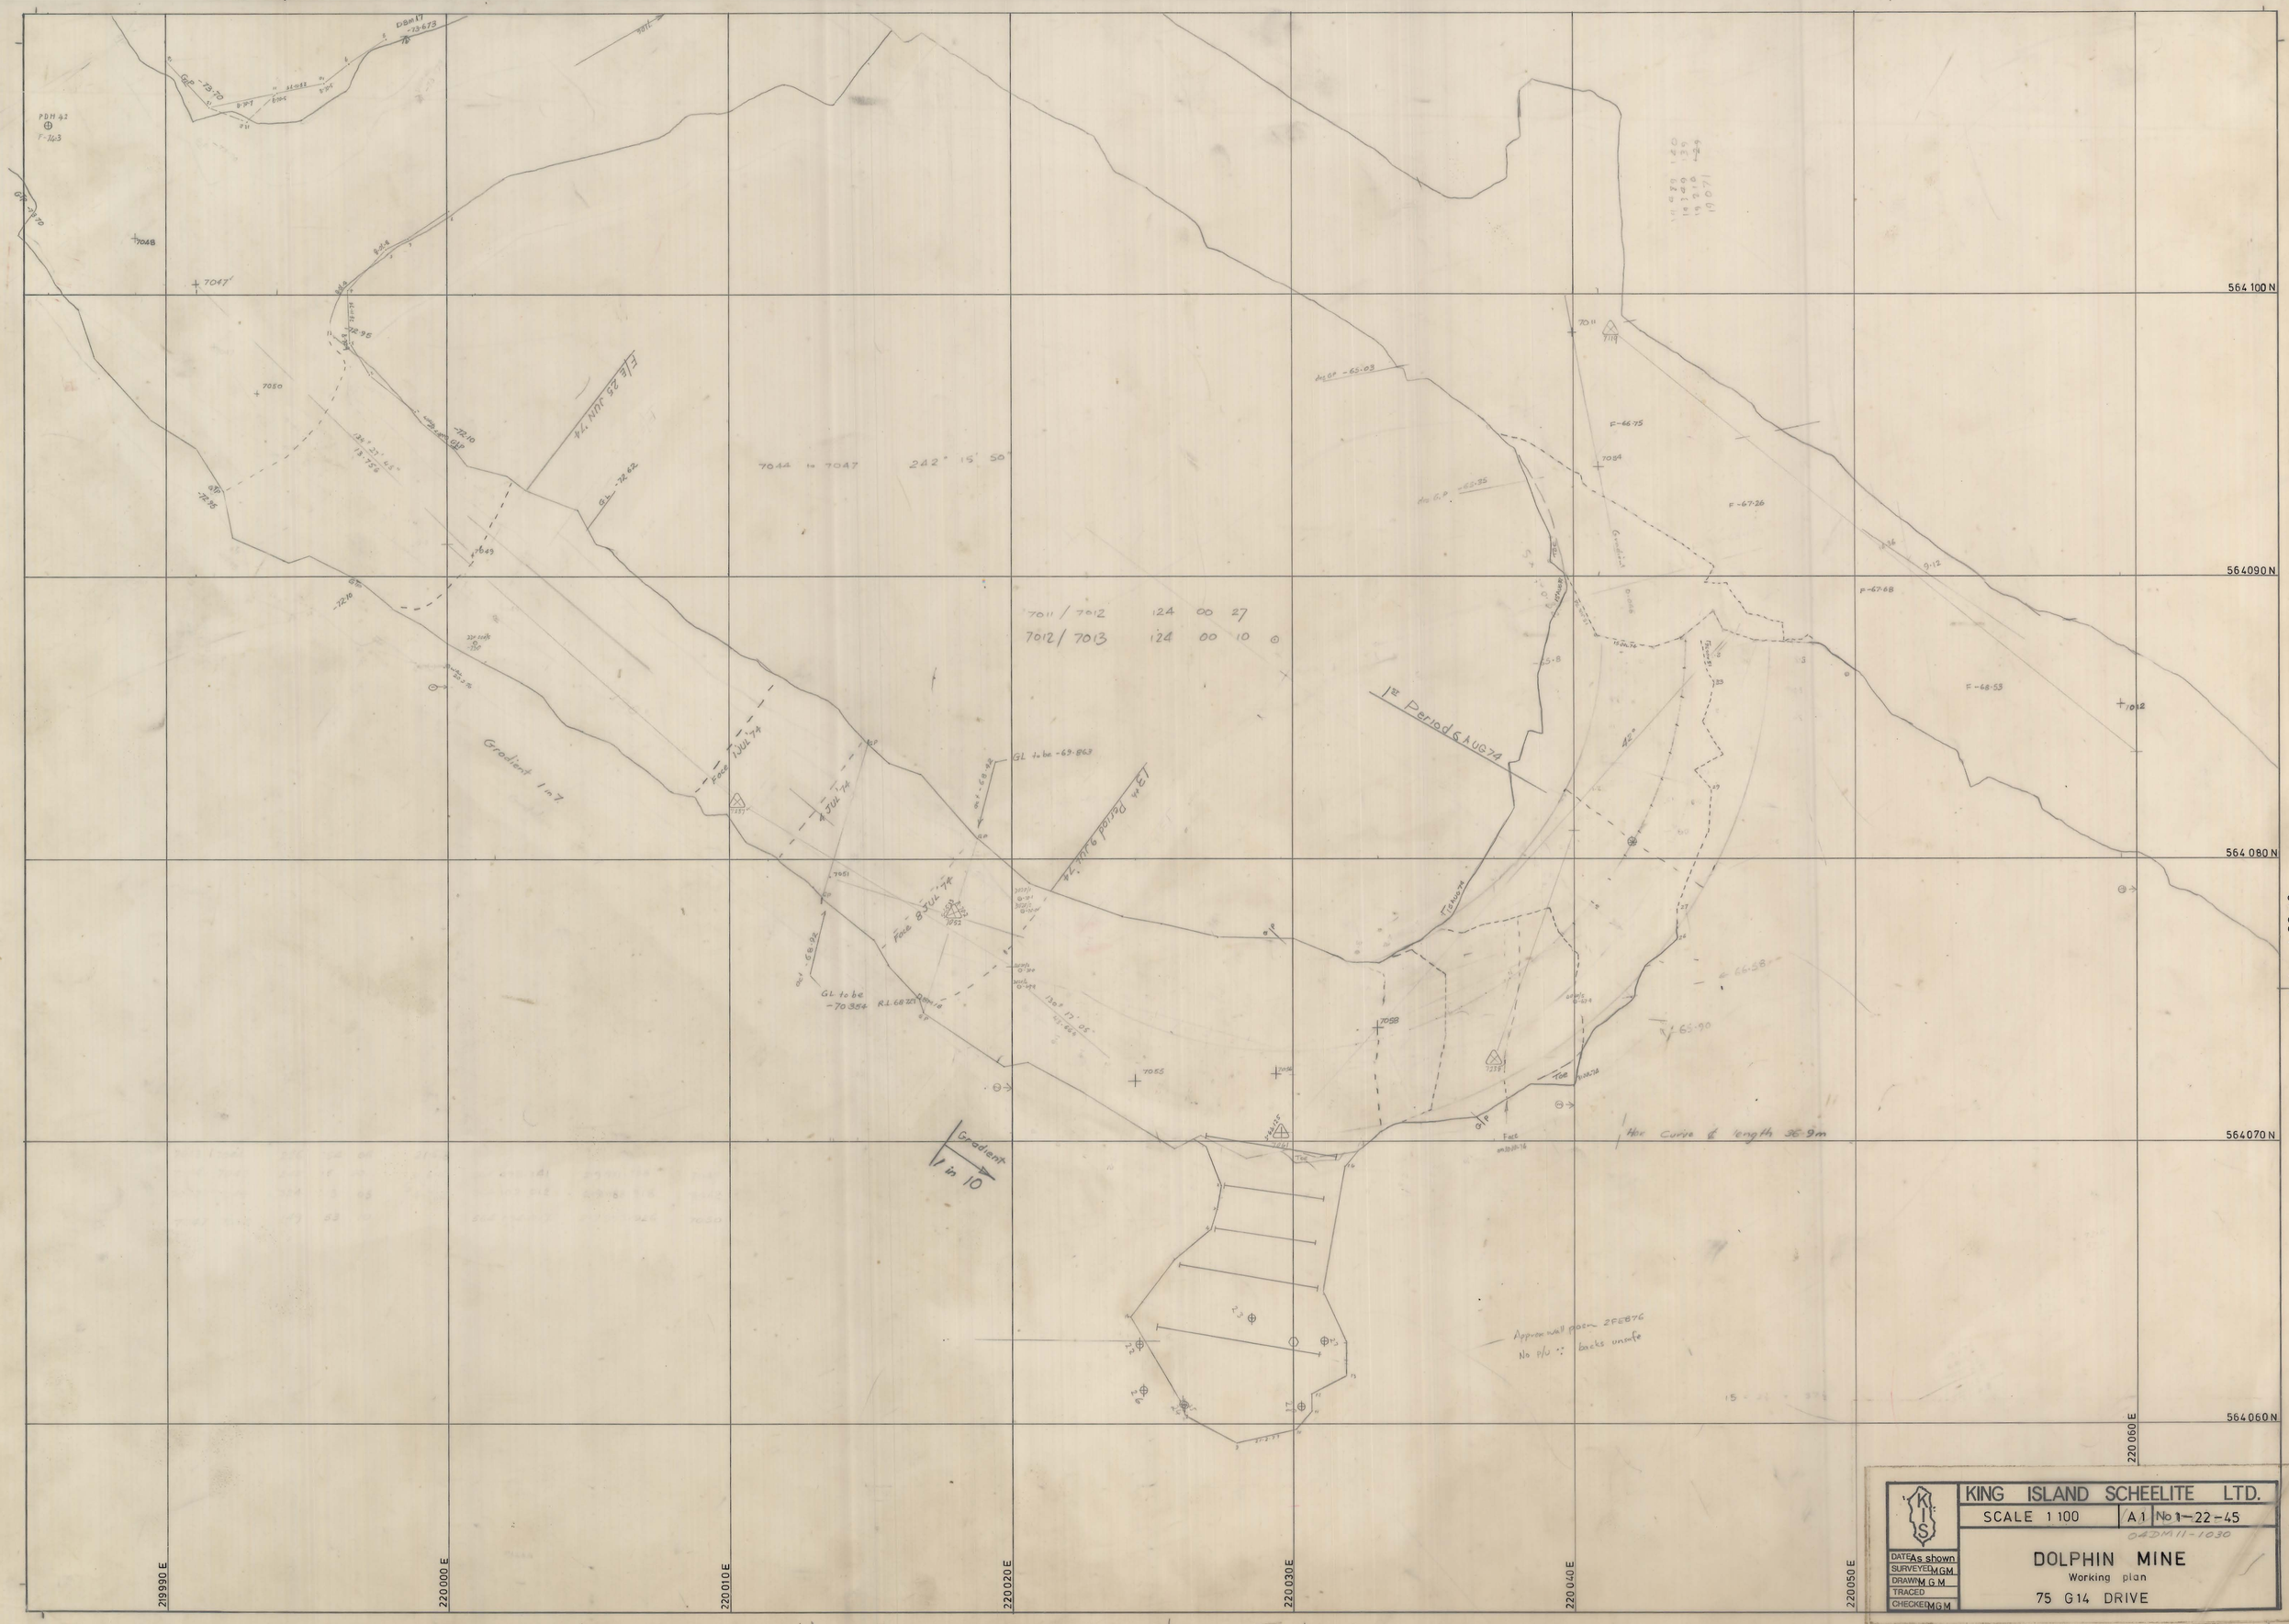
04DM11-1030