0374_2304

04DM11-1006

DOLPHIN 1:100 MAIN DECLINE S14 1-22-30

1-22-25 Adjoins

04DM11-1006

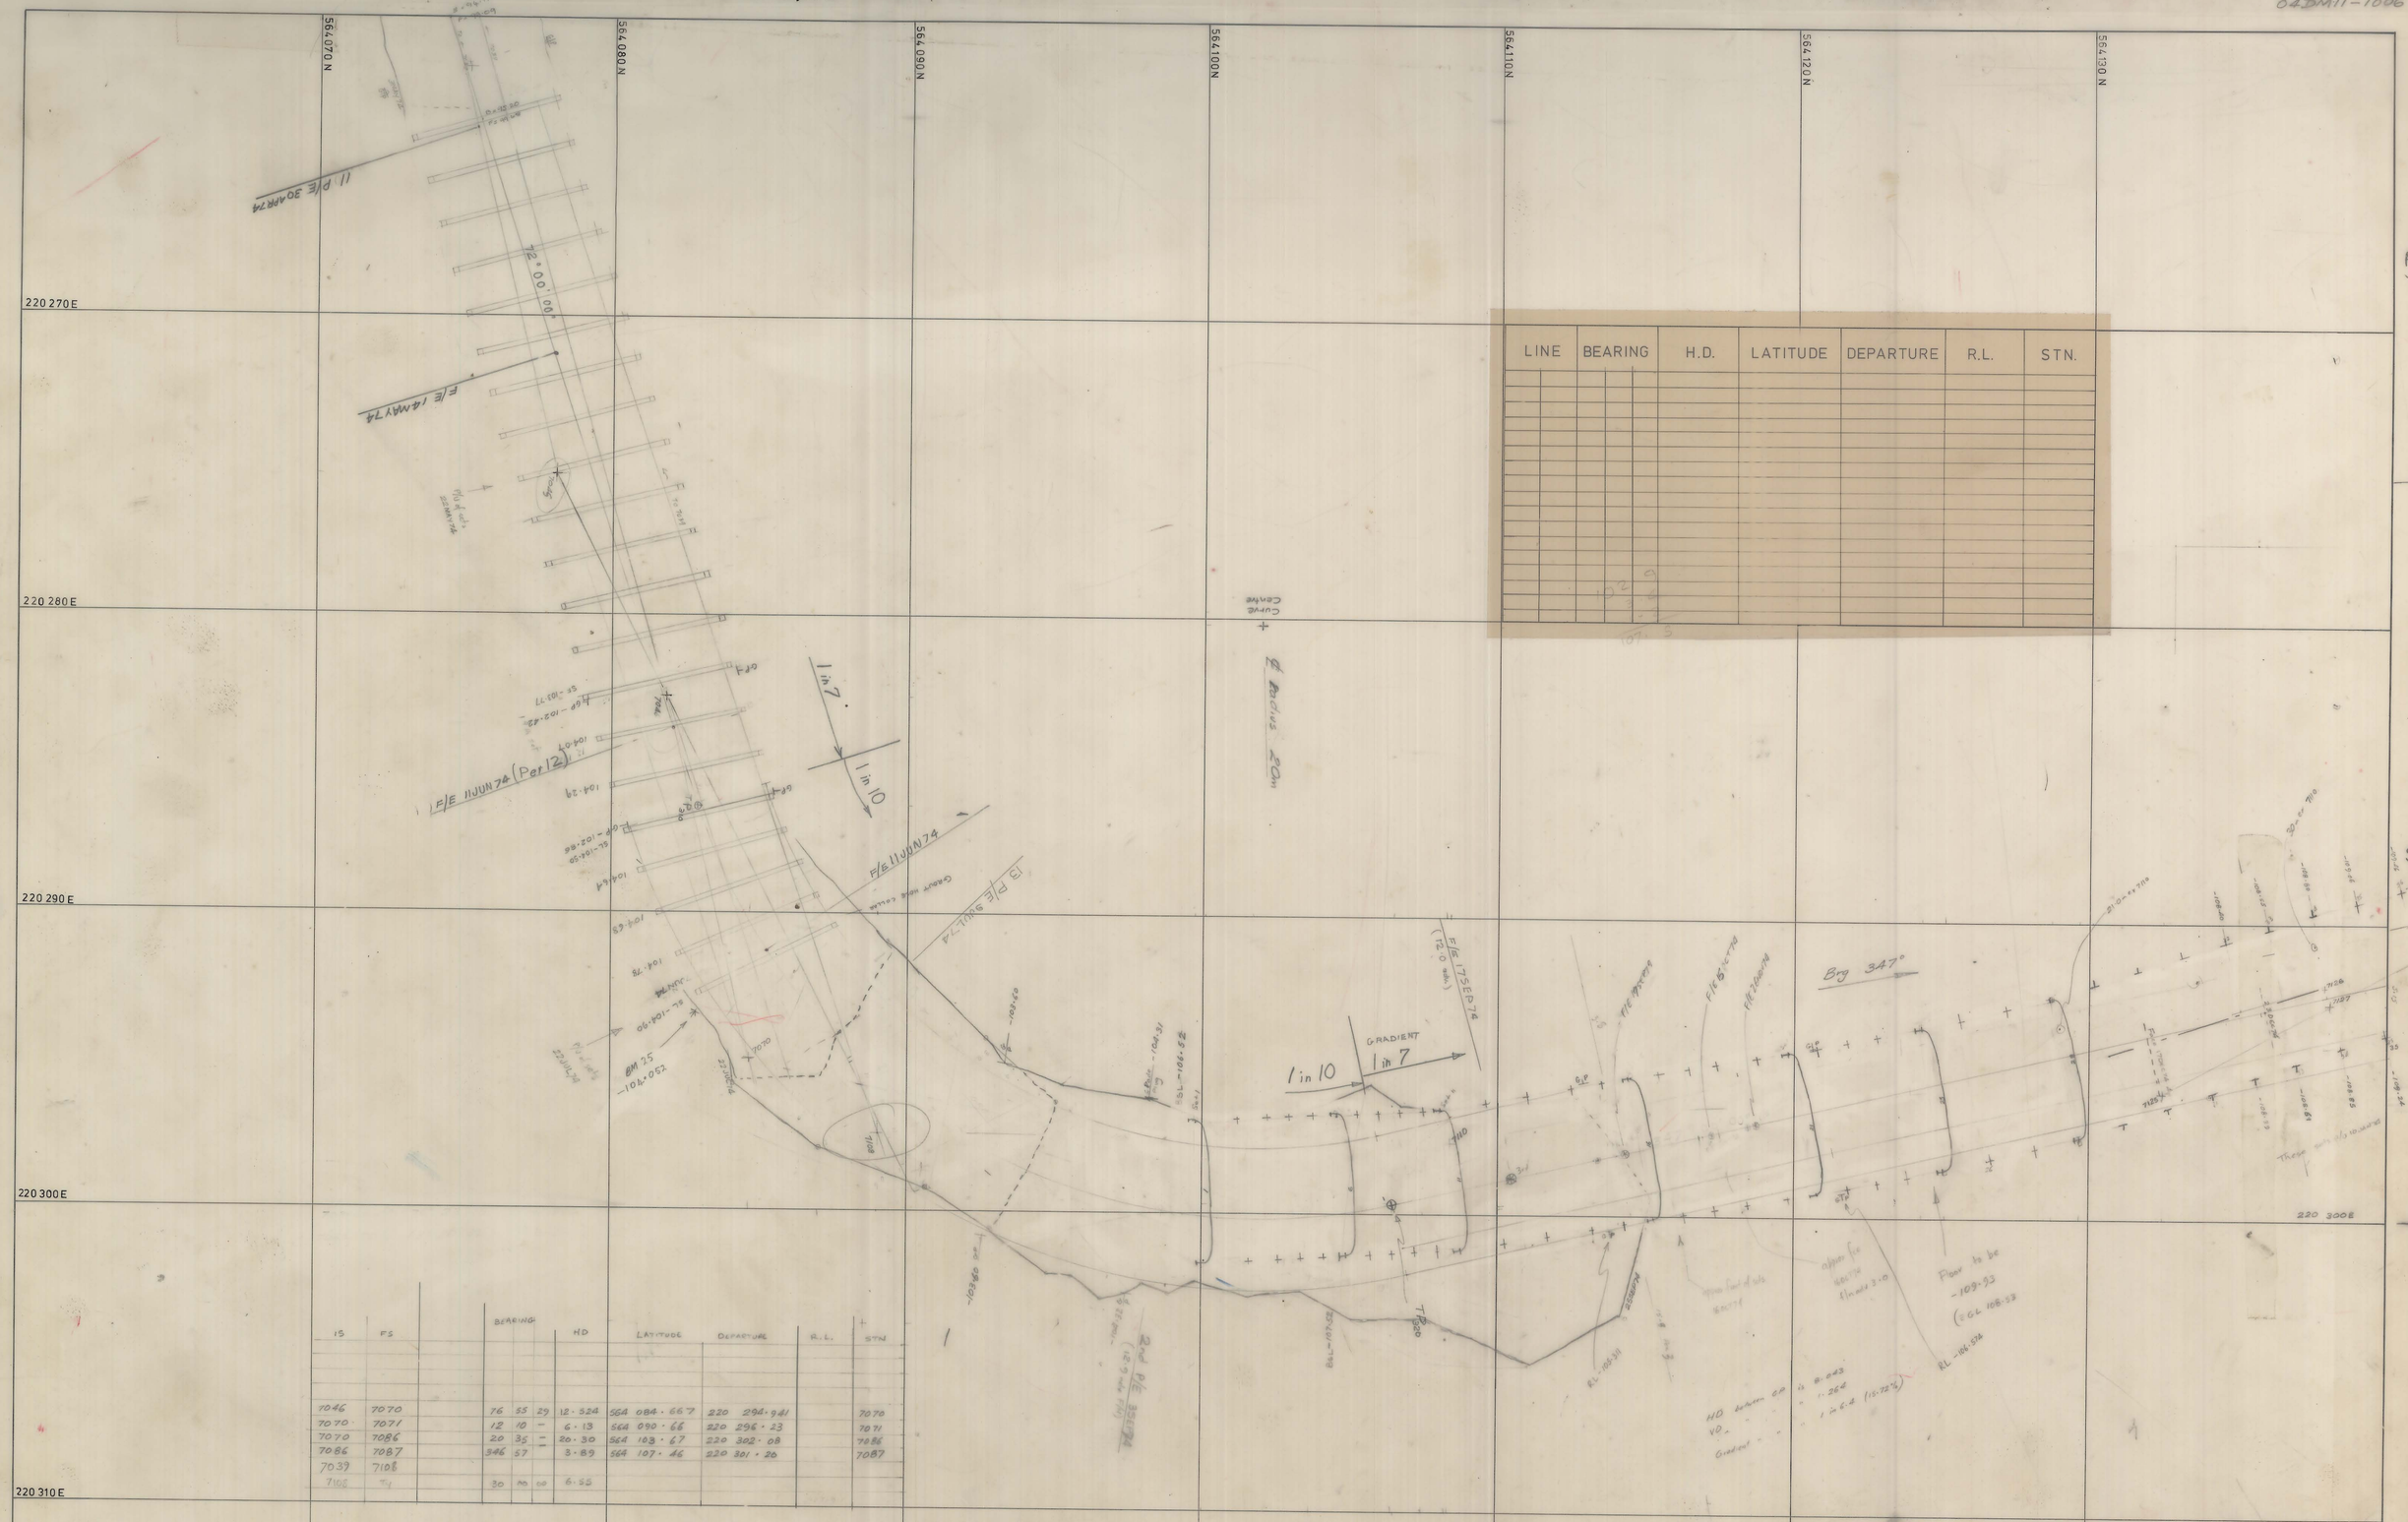

LINE	BEARING	H.D.	LATITUDE	DEPARTURE	R.L.	STN.

IS	FS		BEARING	HD	LATITUDE	DEPARTURE	R.L.	STN
7046	7070		76 55 29	12·524	564 084·667	220 294·941		7070
7070	7071		12 10 —	6·13	564 090·66	220 296·23		7071
7070	7086		20 35 —	20·30	564 103·67	220 302·08		7086
7086	7087		346 57 —	3·89	564 107·46	220 301·20		7087
7039	7108							
7108	TU		30 00 00	6·55				

KING ISLAND SCHEELITE LTD.

SCALE 1:100 | A1

04 DM 11-1006

DOLPHIN MINE

Working plan

MAIN DECLINE S14

DATE As shown
SURVEYED M.G.M.
DRAWN M.G.M.
TRACED
CHECKED M.G.M.

M-23-3-74