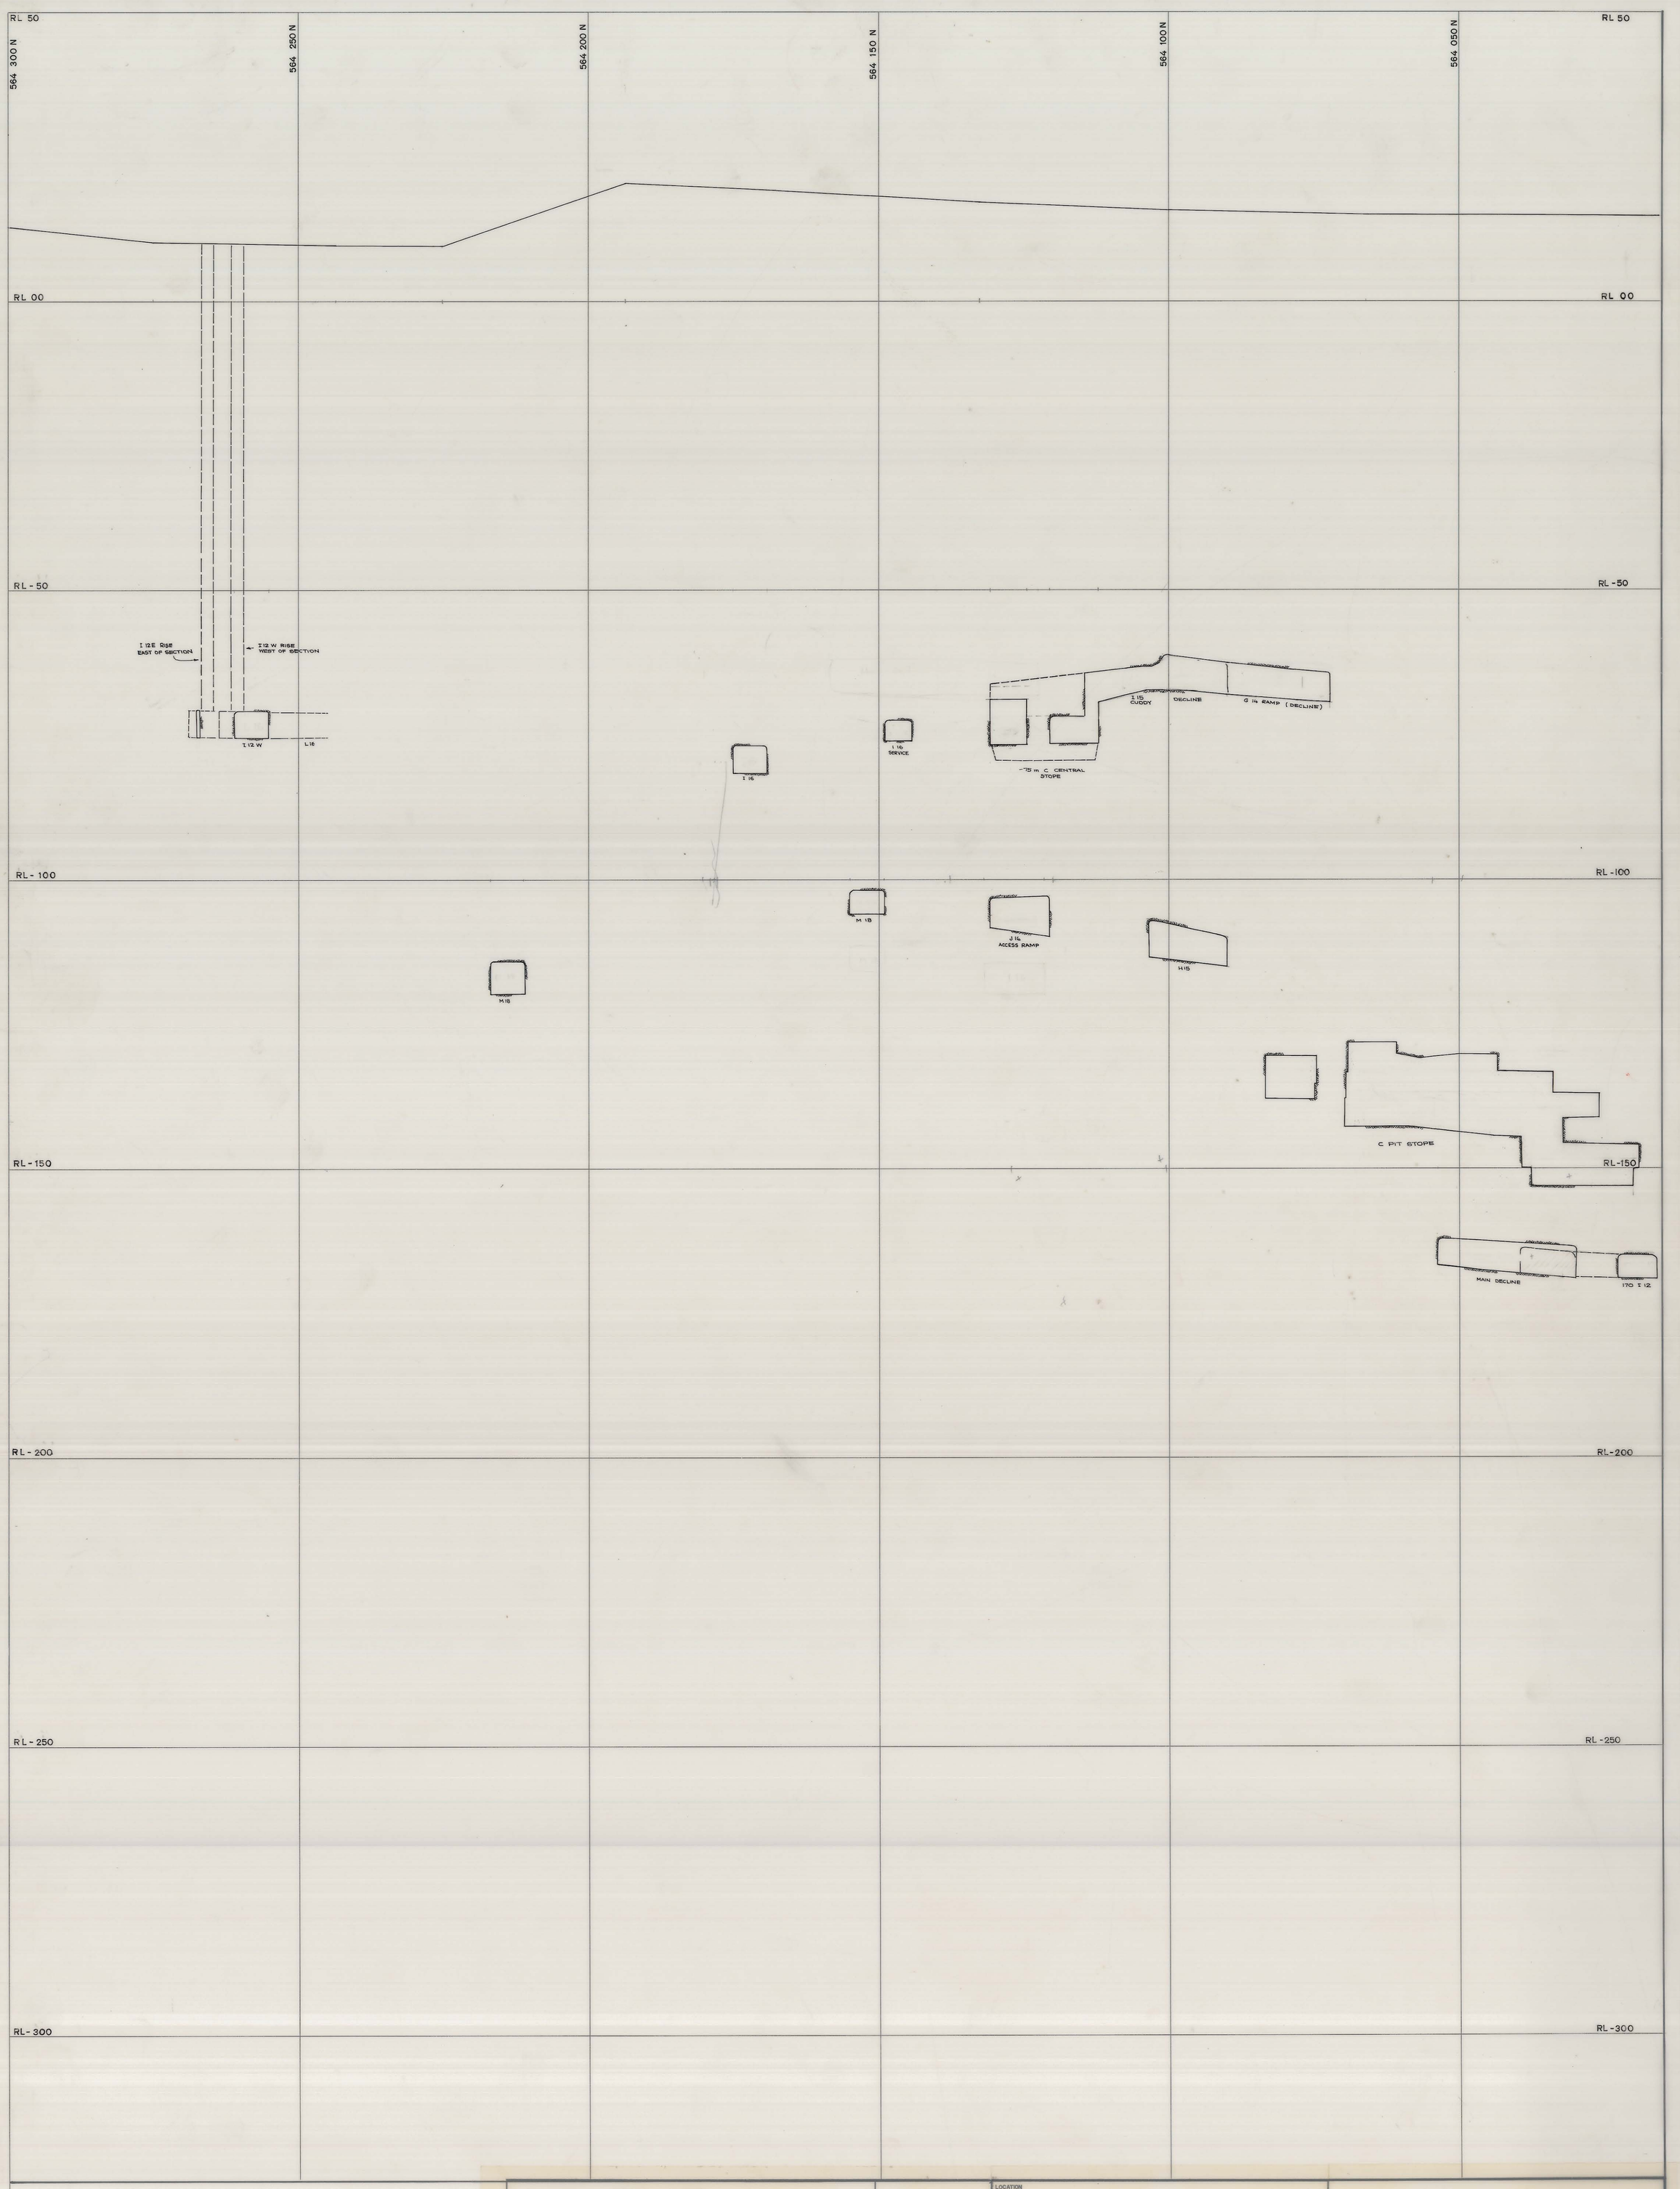

SCALE 1:500

looking east

LOCATION
DOLPHIN MINE

SUBJECT
CROSSECTION
220 040 E

KING ISLAND SCHEELITE
A DIVISION OF WARMAN INTERNATIONAL

GRASSY KING ISLAND

PLAN NUMBER
04DM22 - 1017

M-23-3-77

27 JUN 1981
5 cm
0374_2326
04DM22-1017