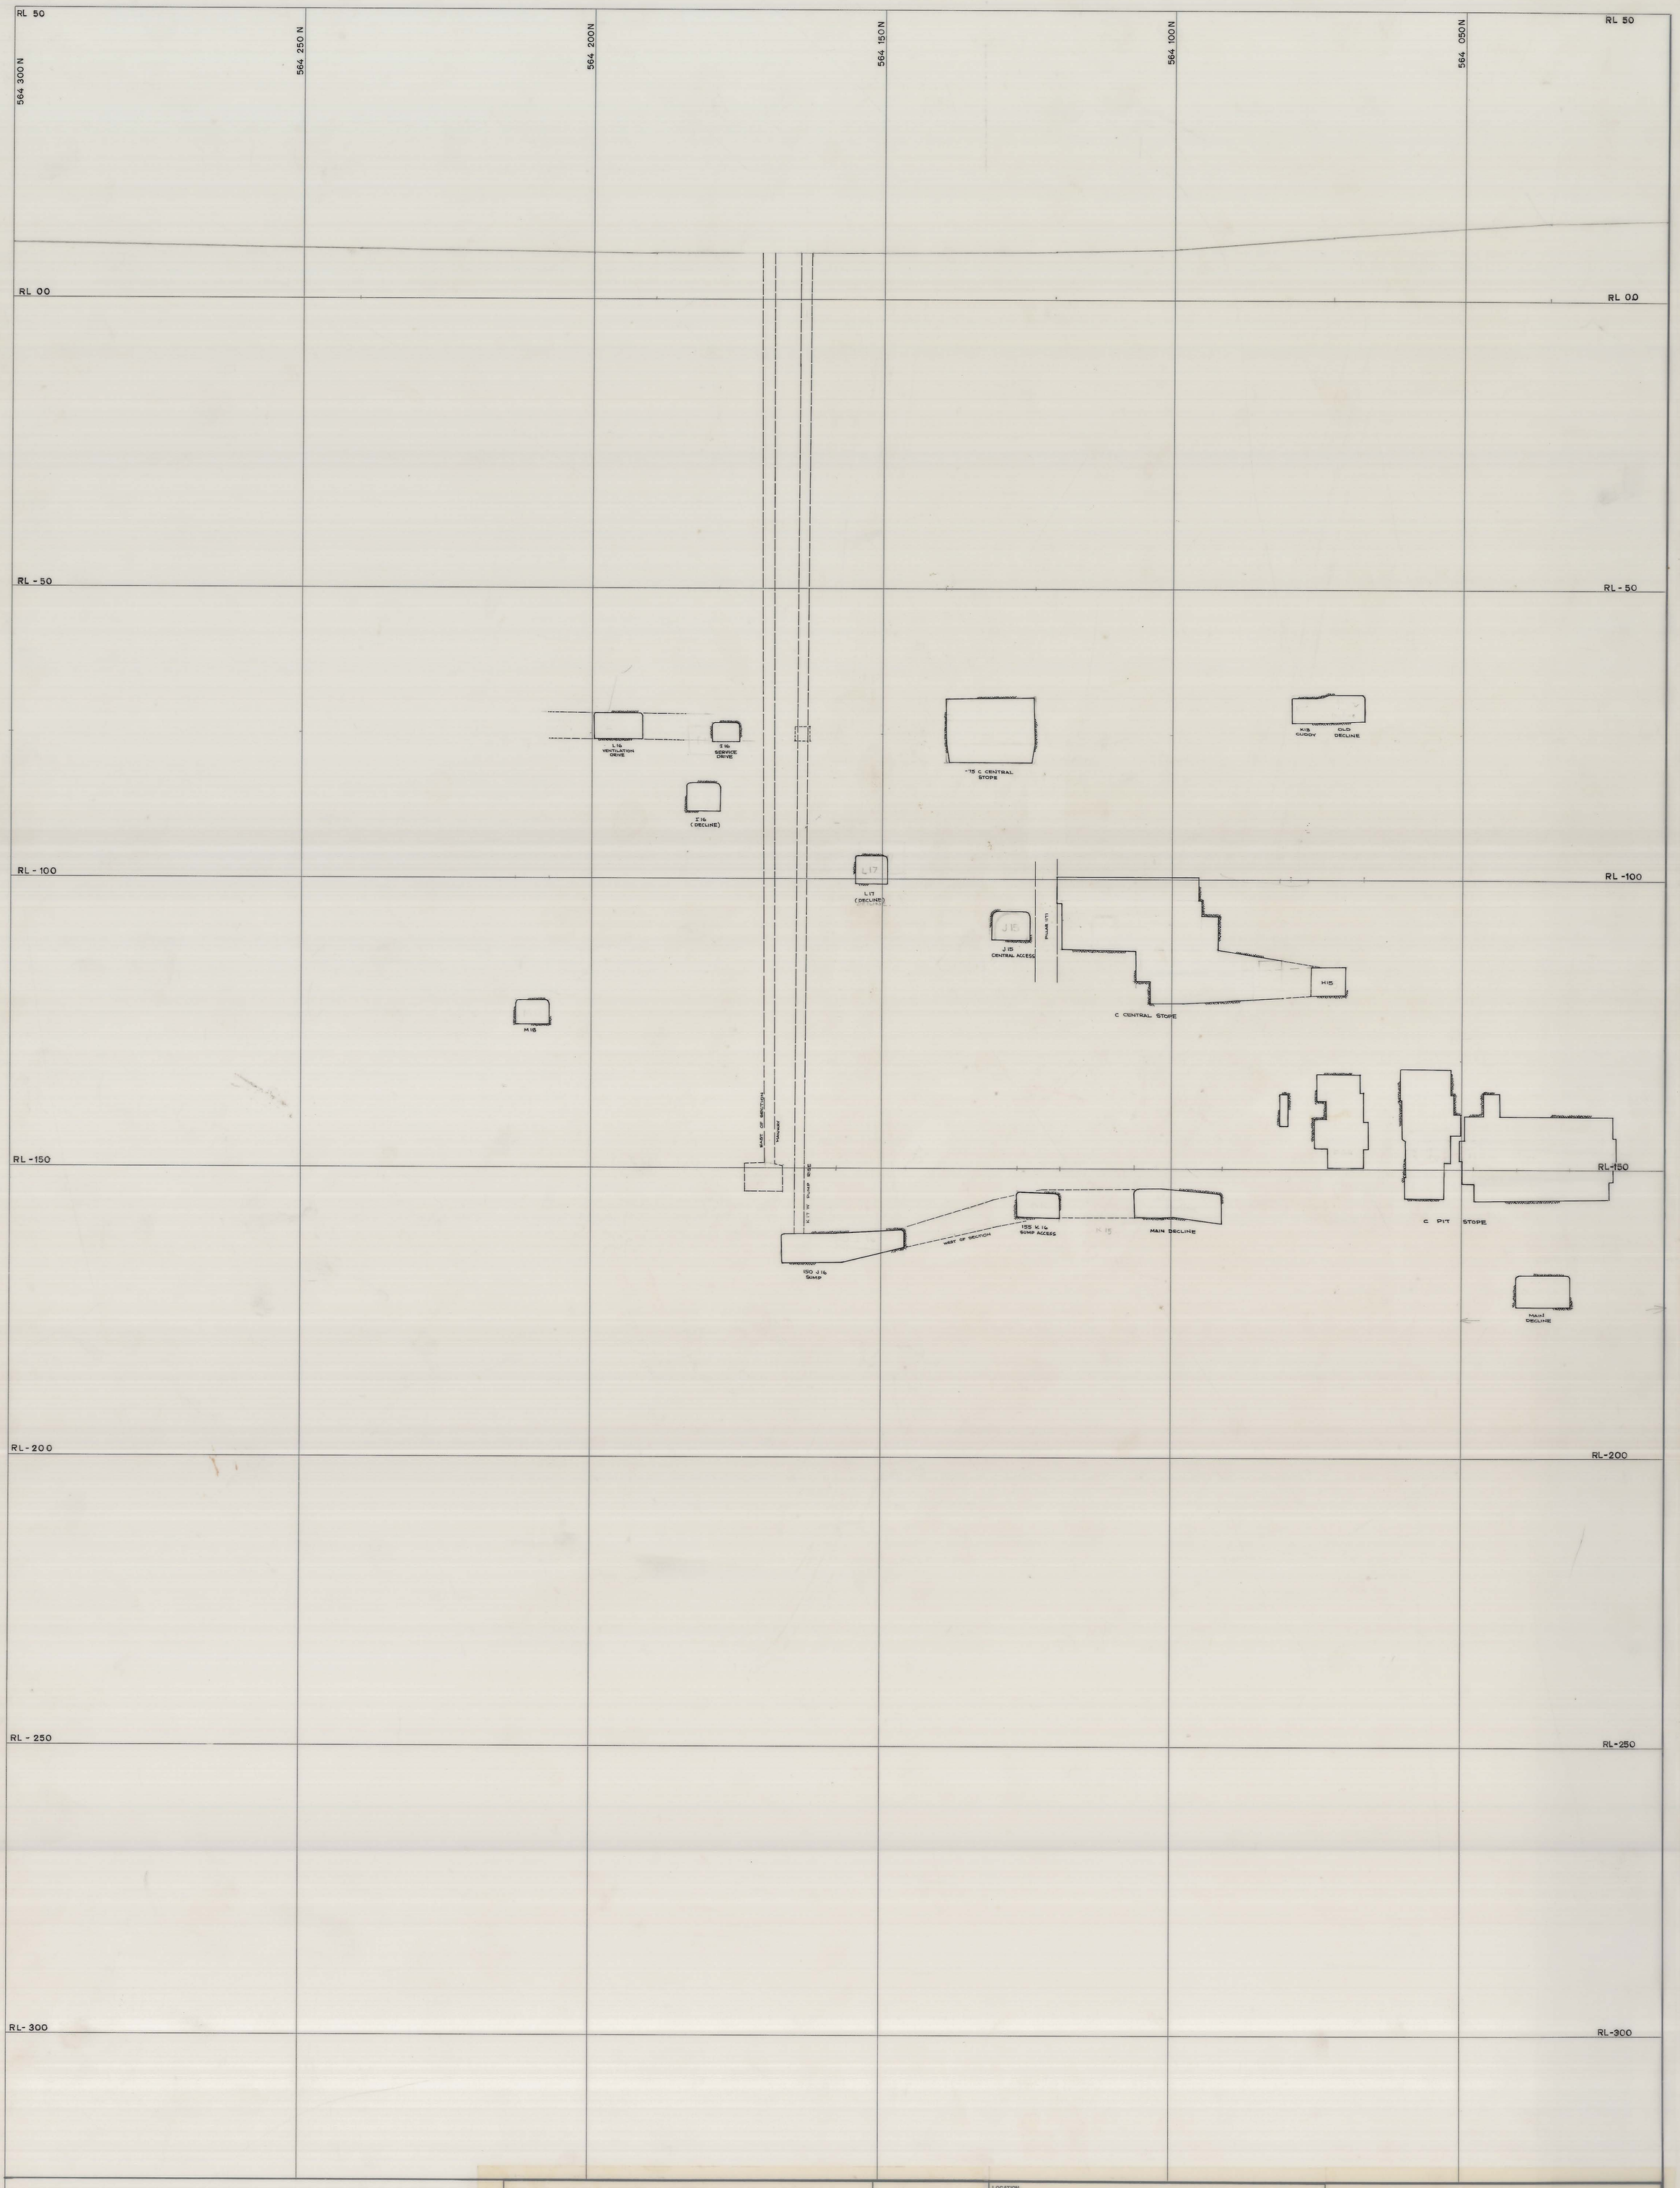

SCALE 1:500

looking east

LOCATION: DOLPHIN MINE

SUBJECT: CROSSECTION 220 080 E

KING ISLAND SCHEELITE
A DIVISION OF WARMAN INTERNATIONAL

GRASSY KING ISLAND

PLAN NUMBER: 04DM22 - 1019

M-23-3-77
1019

27 JUN 1981
5 cm
0374_2328
04DM22-1019