5 cm

0374_2384

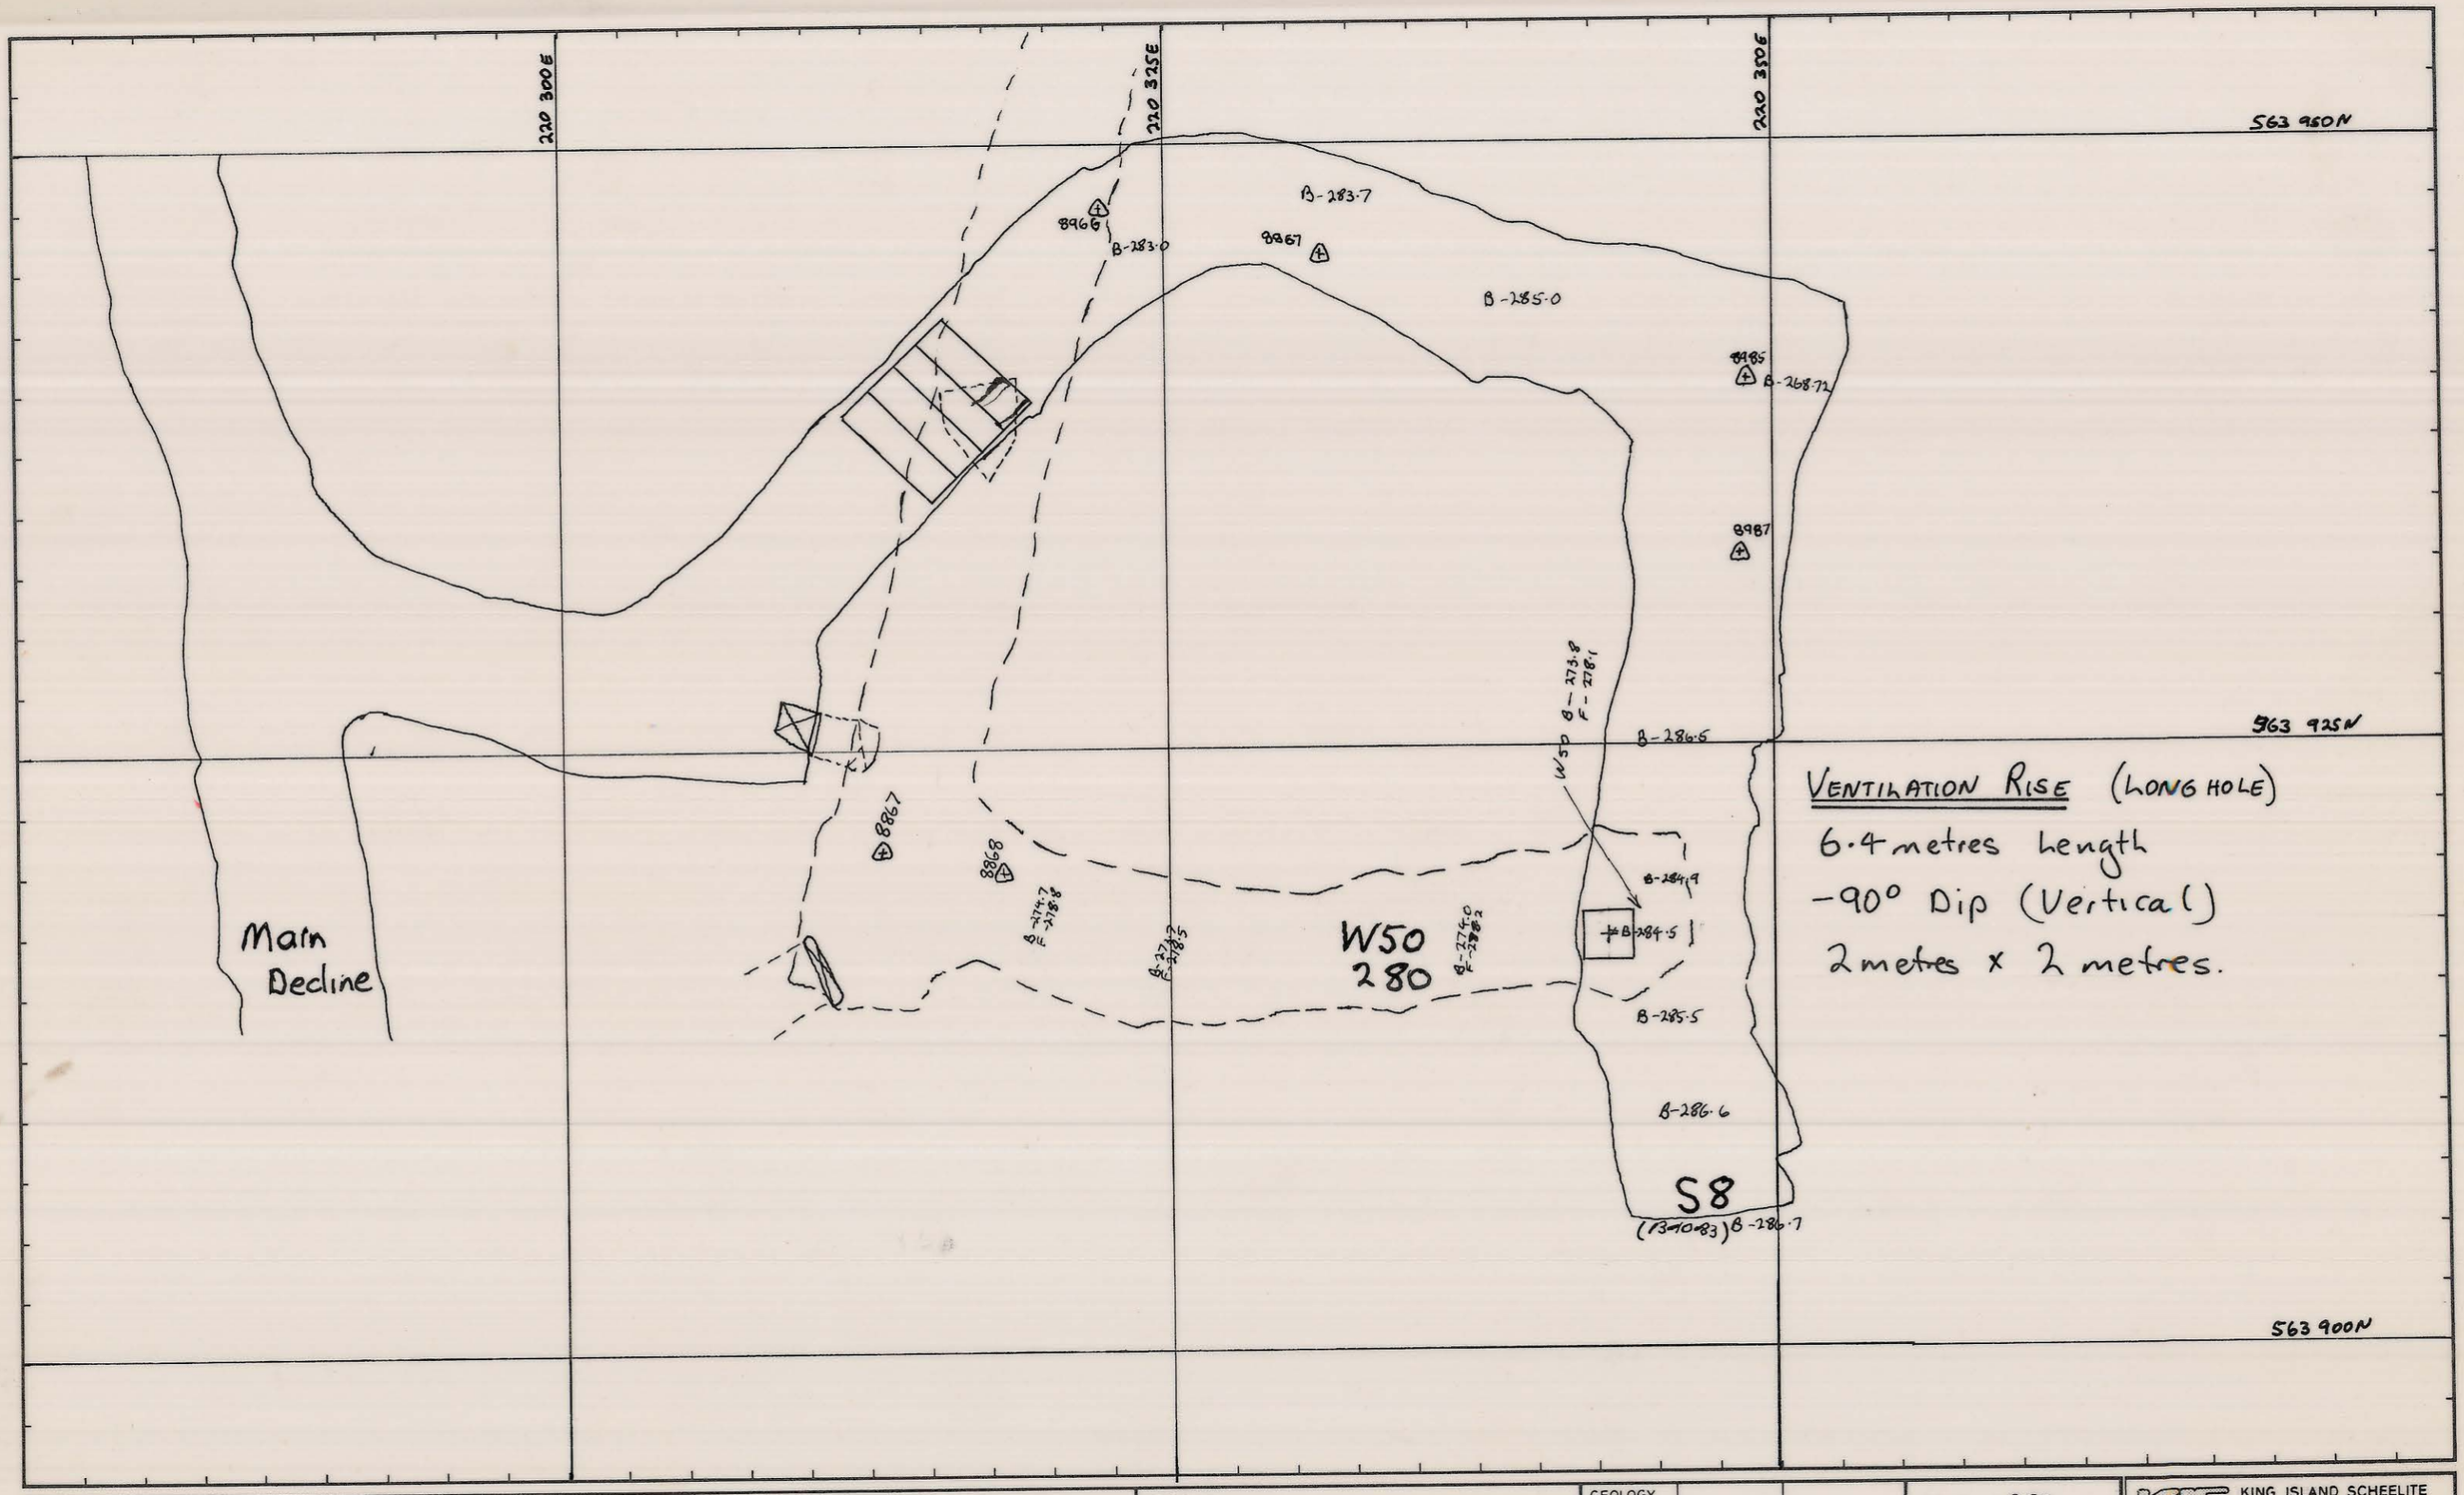

REF. PLAN	GEOLOGY		
	SURVEY		
	PLANNING	MaxH0 28/10/83.	
	ROCK MEC.		
	GRADE CON.		
	DRAFTING		
	T.S.S.		

SCALE 1:250

KIS KING ISLAND SCHEELITE GRASSY KING ISLAND

Ventilation Rise (Longhole)
S8 to W50-280 mRL

DRAWING NUMBER