0374_2389

5 cm

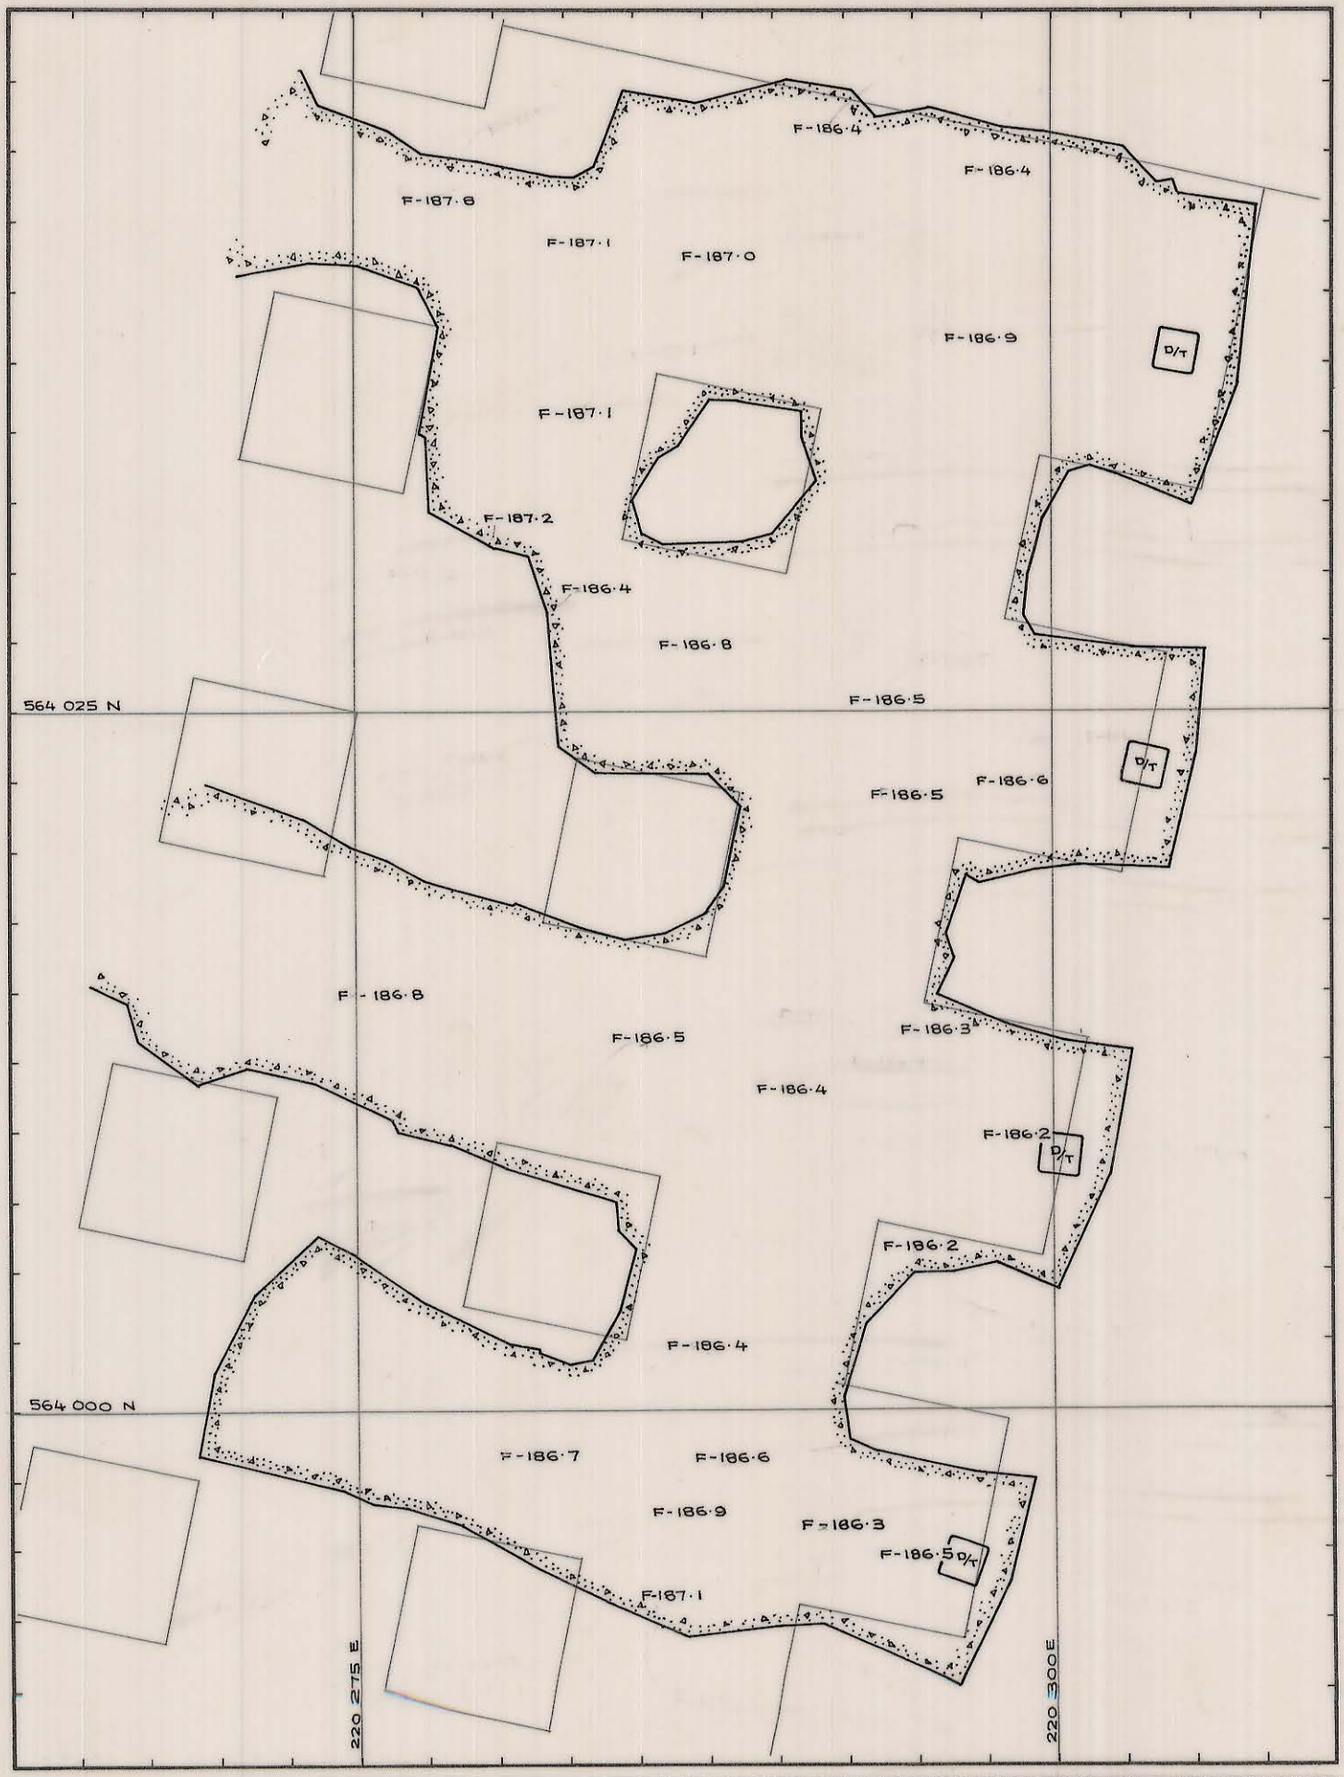

REF. PLAN	GEOLOGY			1 : 250 SCALE	KIS KING ISLAND SCHEELITE GRASSY KING ISLAND
NOTES R.L (AVERAGE) OF CEMENT FILL AT TOP -185·5 AVERAGE DEPTH OF CEMENT FILL 0·7 m	SURVEY				DOLPHIN MINE MID WEDGE STOPE CEMENT FILL REDUCED LEVELS
	PLANNING				
	ROCK.MEC.				
	GRADE CON.				
	DRAFTING				DRAWING NUMBER
	T.S.S.				