5 cm

0374_2390

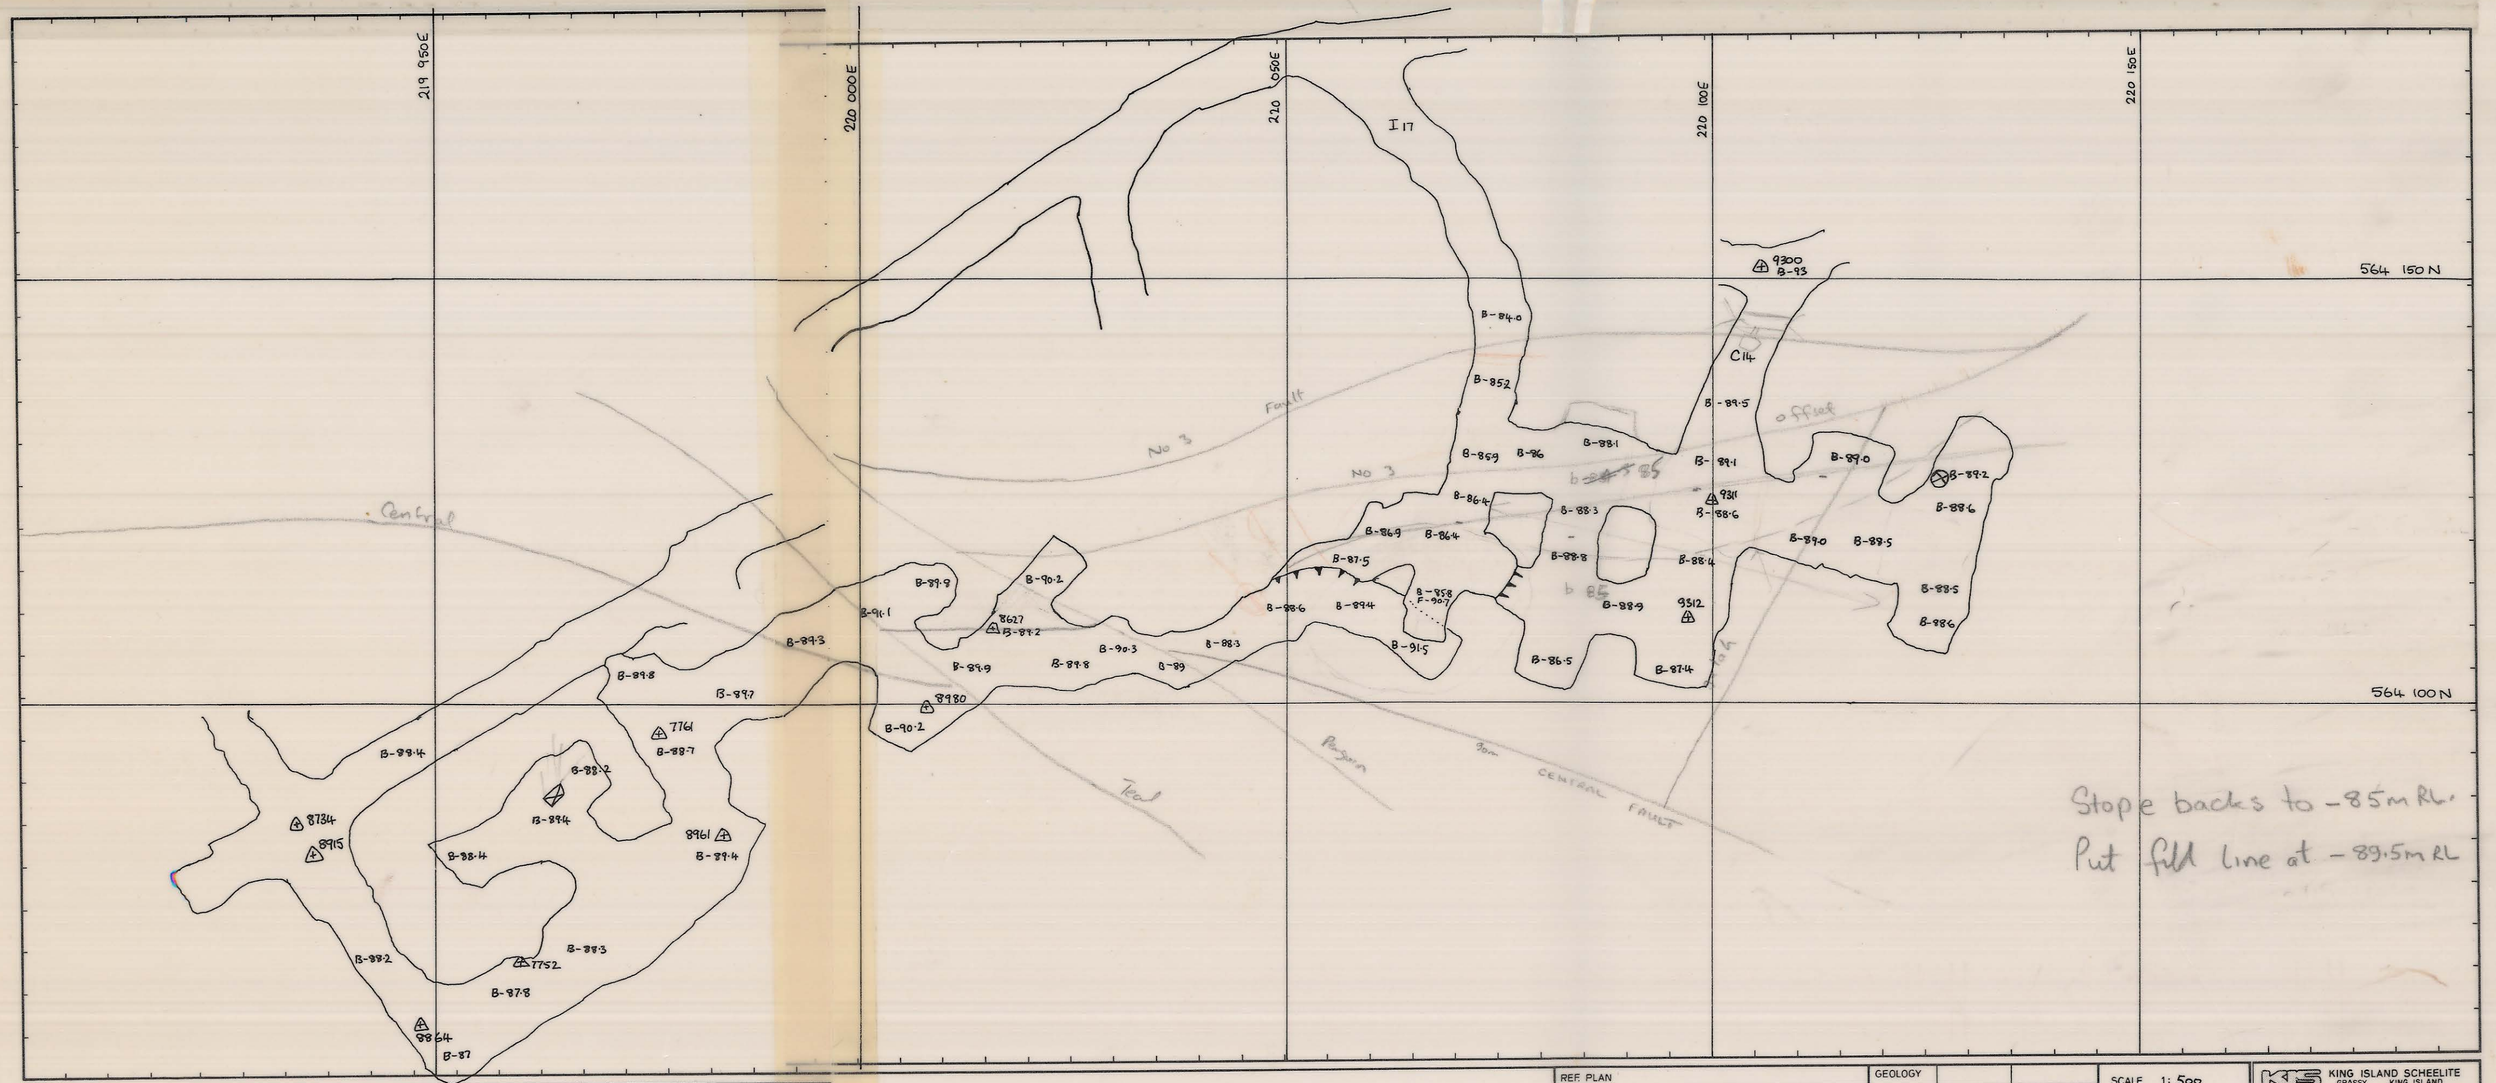

Stope backs to -85m RL.
Put fill line at -89.5m RL

REF. PLAN	GEOLOGY			1 : SCALE	KING ISLAND SCHEELITE GRASSY KING ISLAND
	SURVEY				
	PLANNING				
	ROCK. MEC.				
	GRADE CON.				
	DRAFTING			DRAWING NUMBER	
	T.S.S.				

REF. PLAN	GEOLOGY			SCALE 1: 500	KING ISLAND SCHEELITE GRASSY KING ISLAND
	SURVEY			CURRENT BACK HEIGHTS	
	PLANNING			CENTRAL AND UPPER PIT.	
	ROCK MEC.				
	GRADE CON.				
	DRAFTING			DRAWING NUMBER	
	T.S.S.				