

REF PLAN

NOTE \* PILLARS MOVED 5m EAST OF ORIGINAL POSITION.

GEOLOGY

SURVEY

PLANNING


ROCK MEC.

GRADE CON.

DRAFTING

T.S.S.

SCALE 1: 500

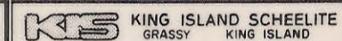

WEDGE REMNANT STOPE

DRAWING NUMBER