27 JUN 1981

5 cm

0374_2426

03 DM 03 1010

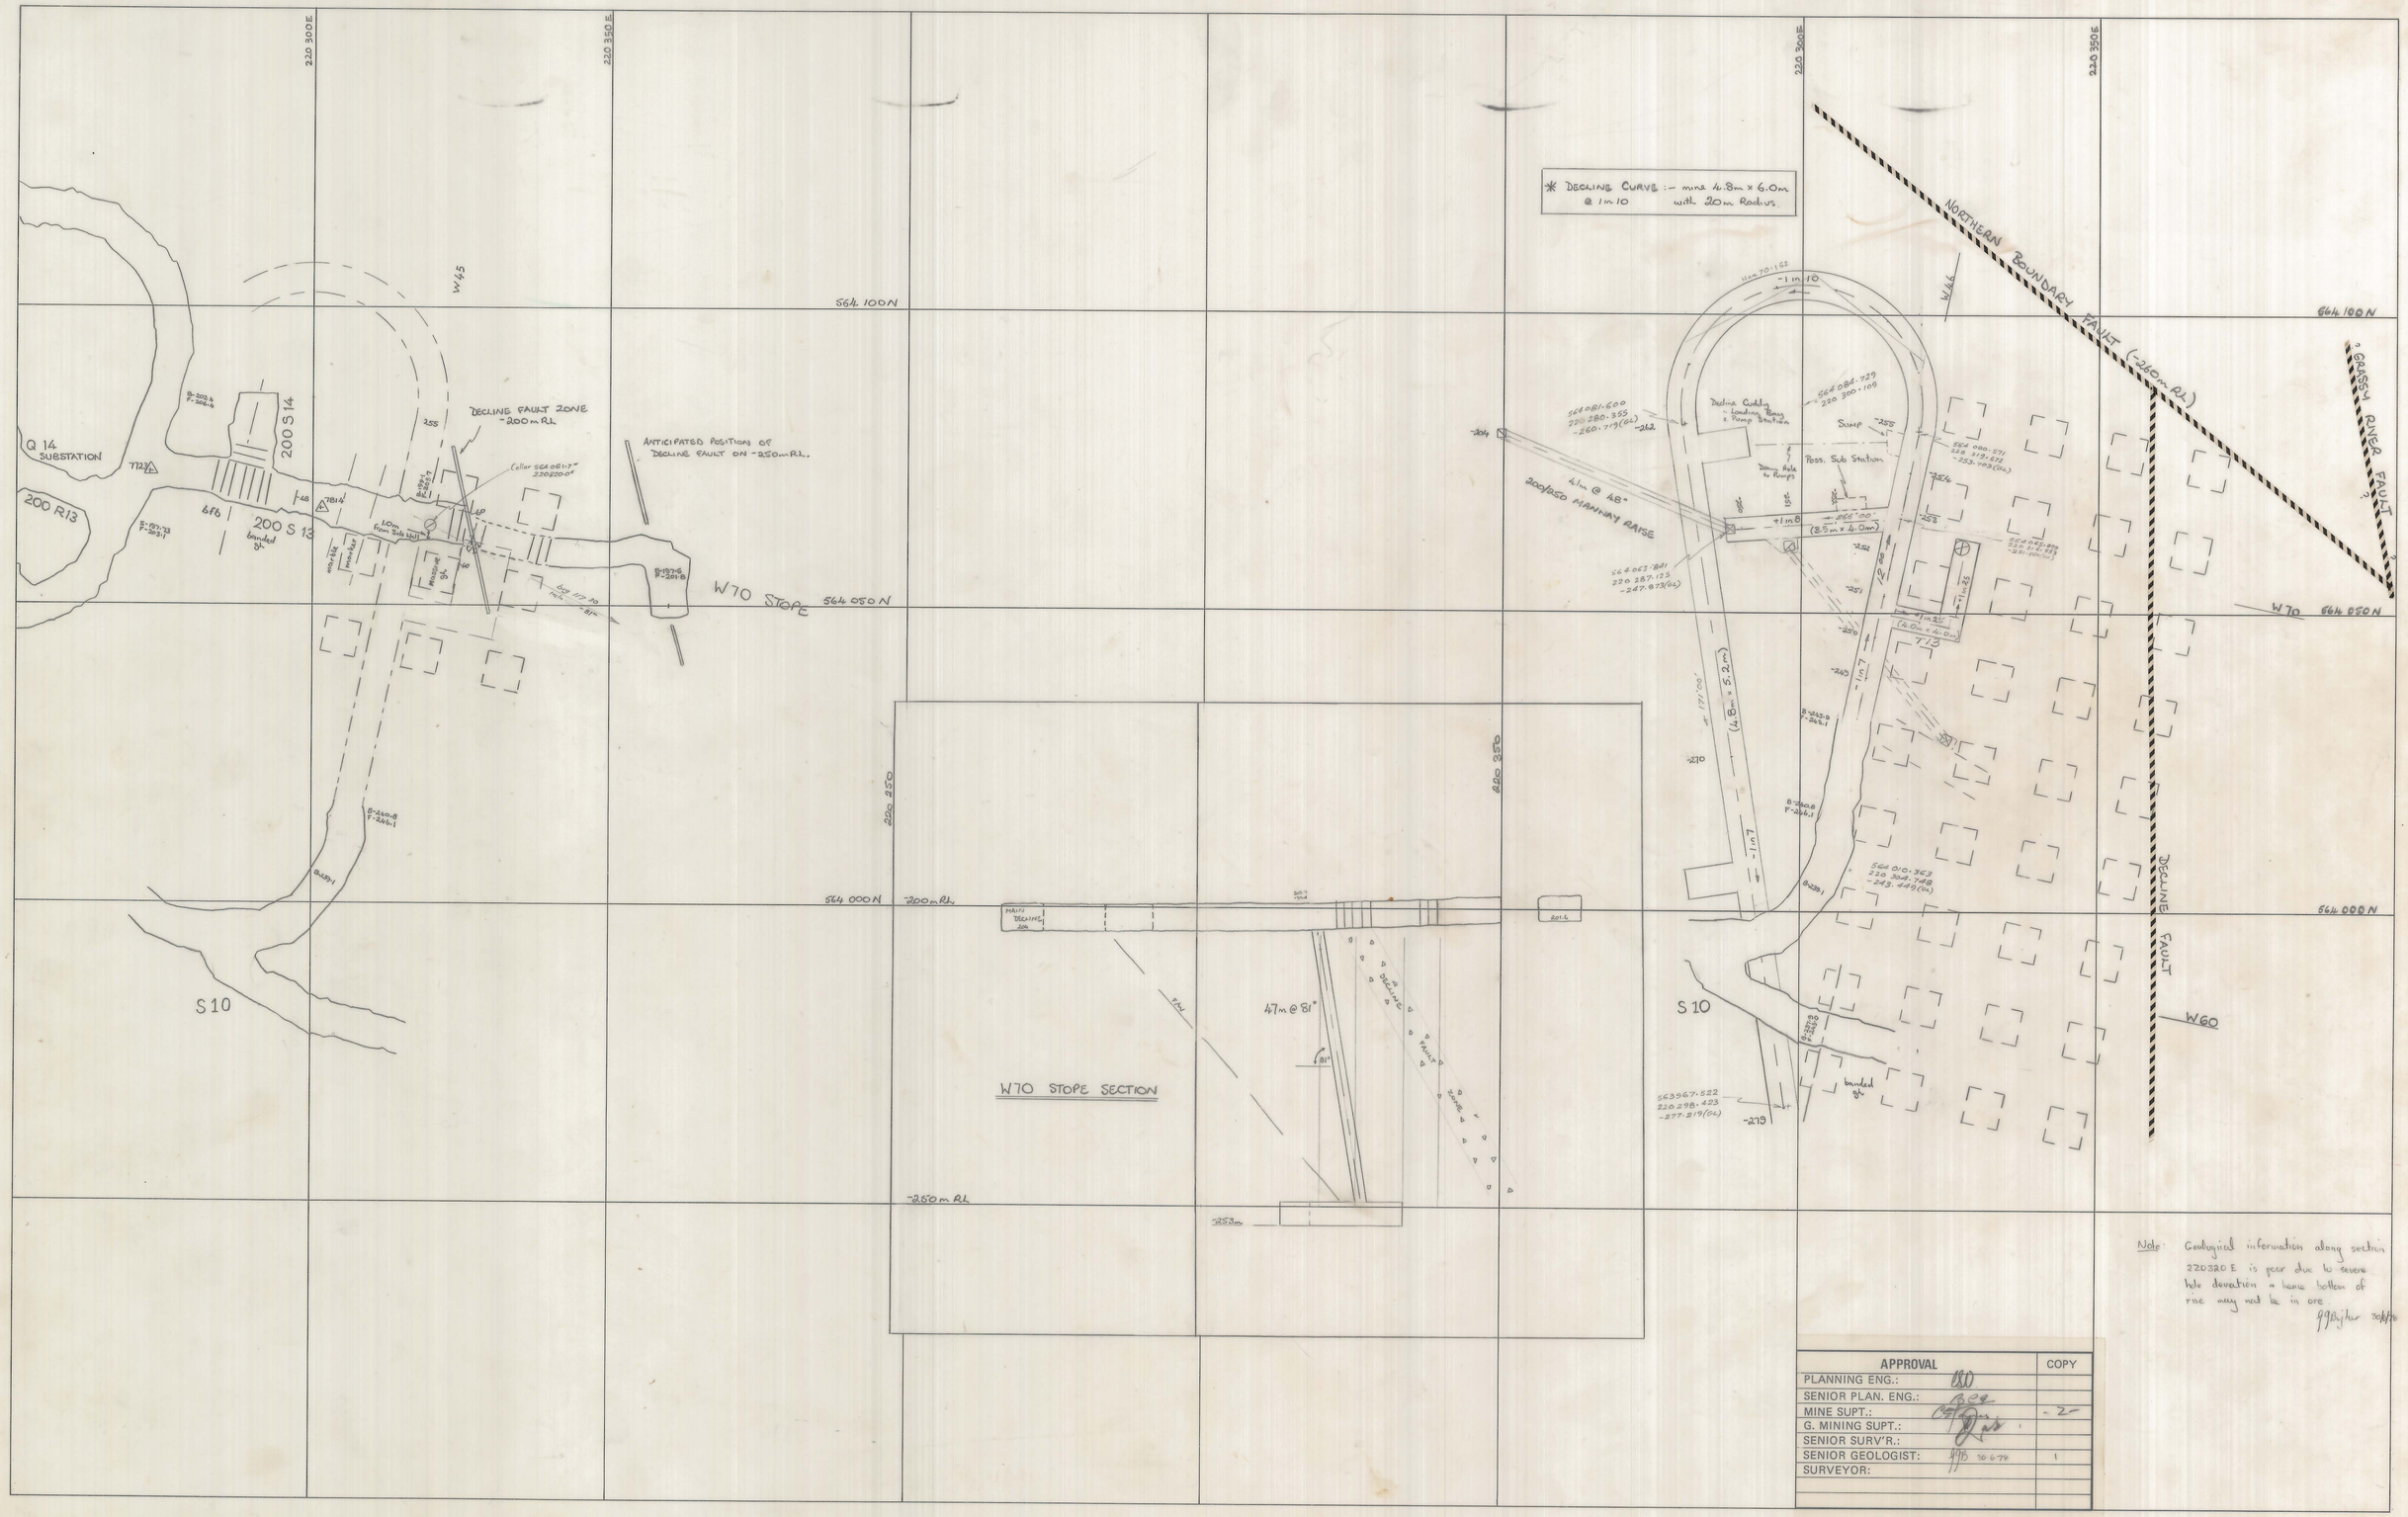

Note: Geological information along section 220320 E is poor due to severe hole deviation & hence bottom of rise may not be in ore
G.G.Bijster 20/8/76

APPROVAL		COPY
PLANNING ENG.:		
SENIOR PLAN. ENG.:		
MINE SUPT.:		- 2 -
G. MINING SUPT.:		
SENIOR SURV'R.:		
SENIOR GEOLOGIST:	30 6 79	1
SURVEYOR:		

SCALE 1: 500

VENT RAISE – 47m @ 81°
Pilot Hole should be drilled to 49m so that it may be more easily located when x/cut is mined on -250m RL.

north

LOCATION: DOLPHIN MINE

SUBJECT: MAIN DECLINE – (-216m RL to -279m RL) & -250m ZONE DEVELOPMENT

KING ISLAND SCHEELITE
A DIVISION OF WARMAN INTERNATIONAL

GRASSY 28 JUNE 1978 KING ISLAND

PLAN NUMBER 03 DM 03 1010