5 cm

0374_2436

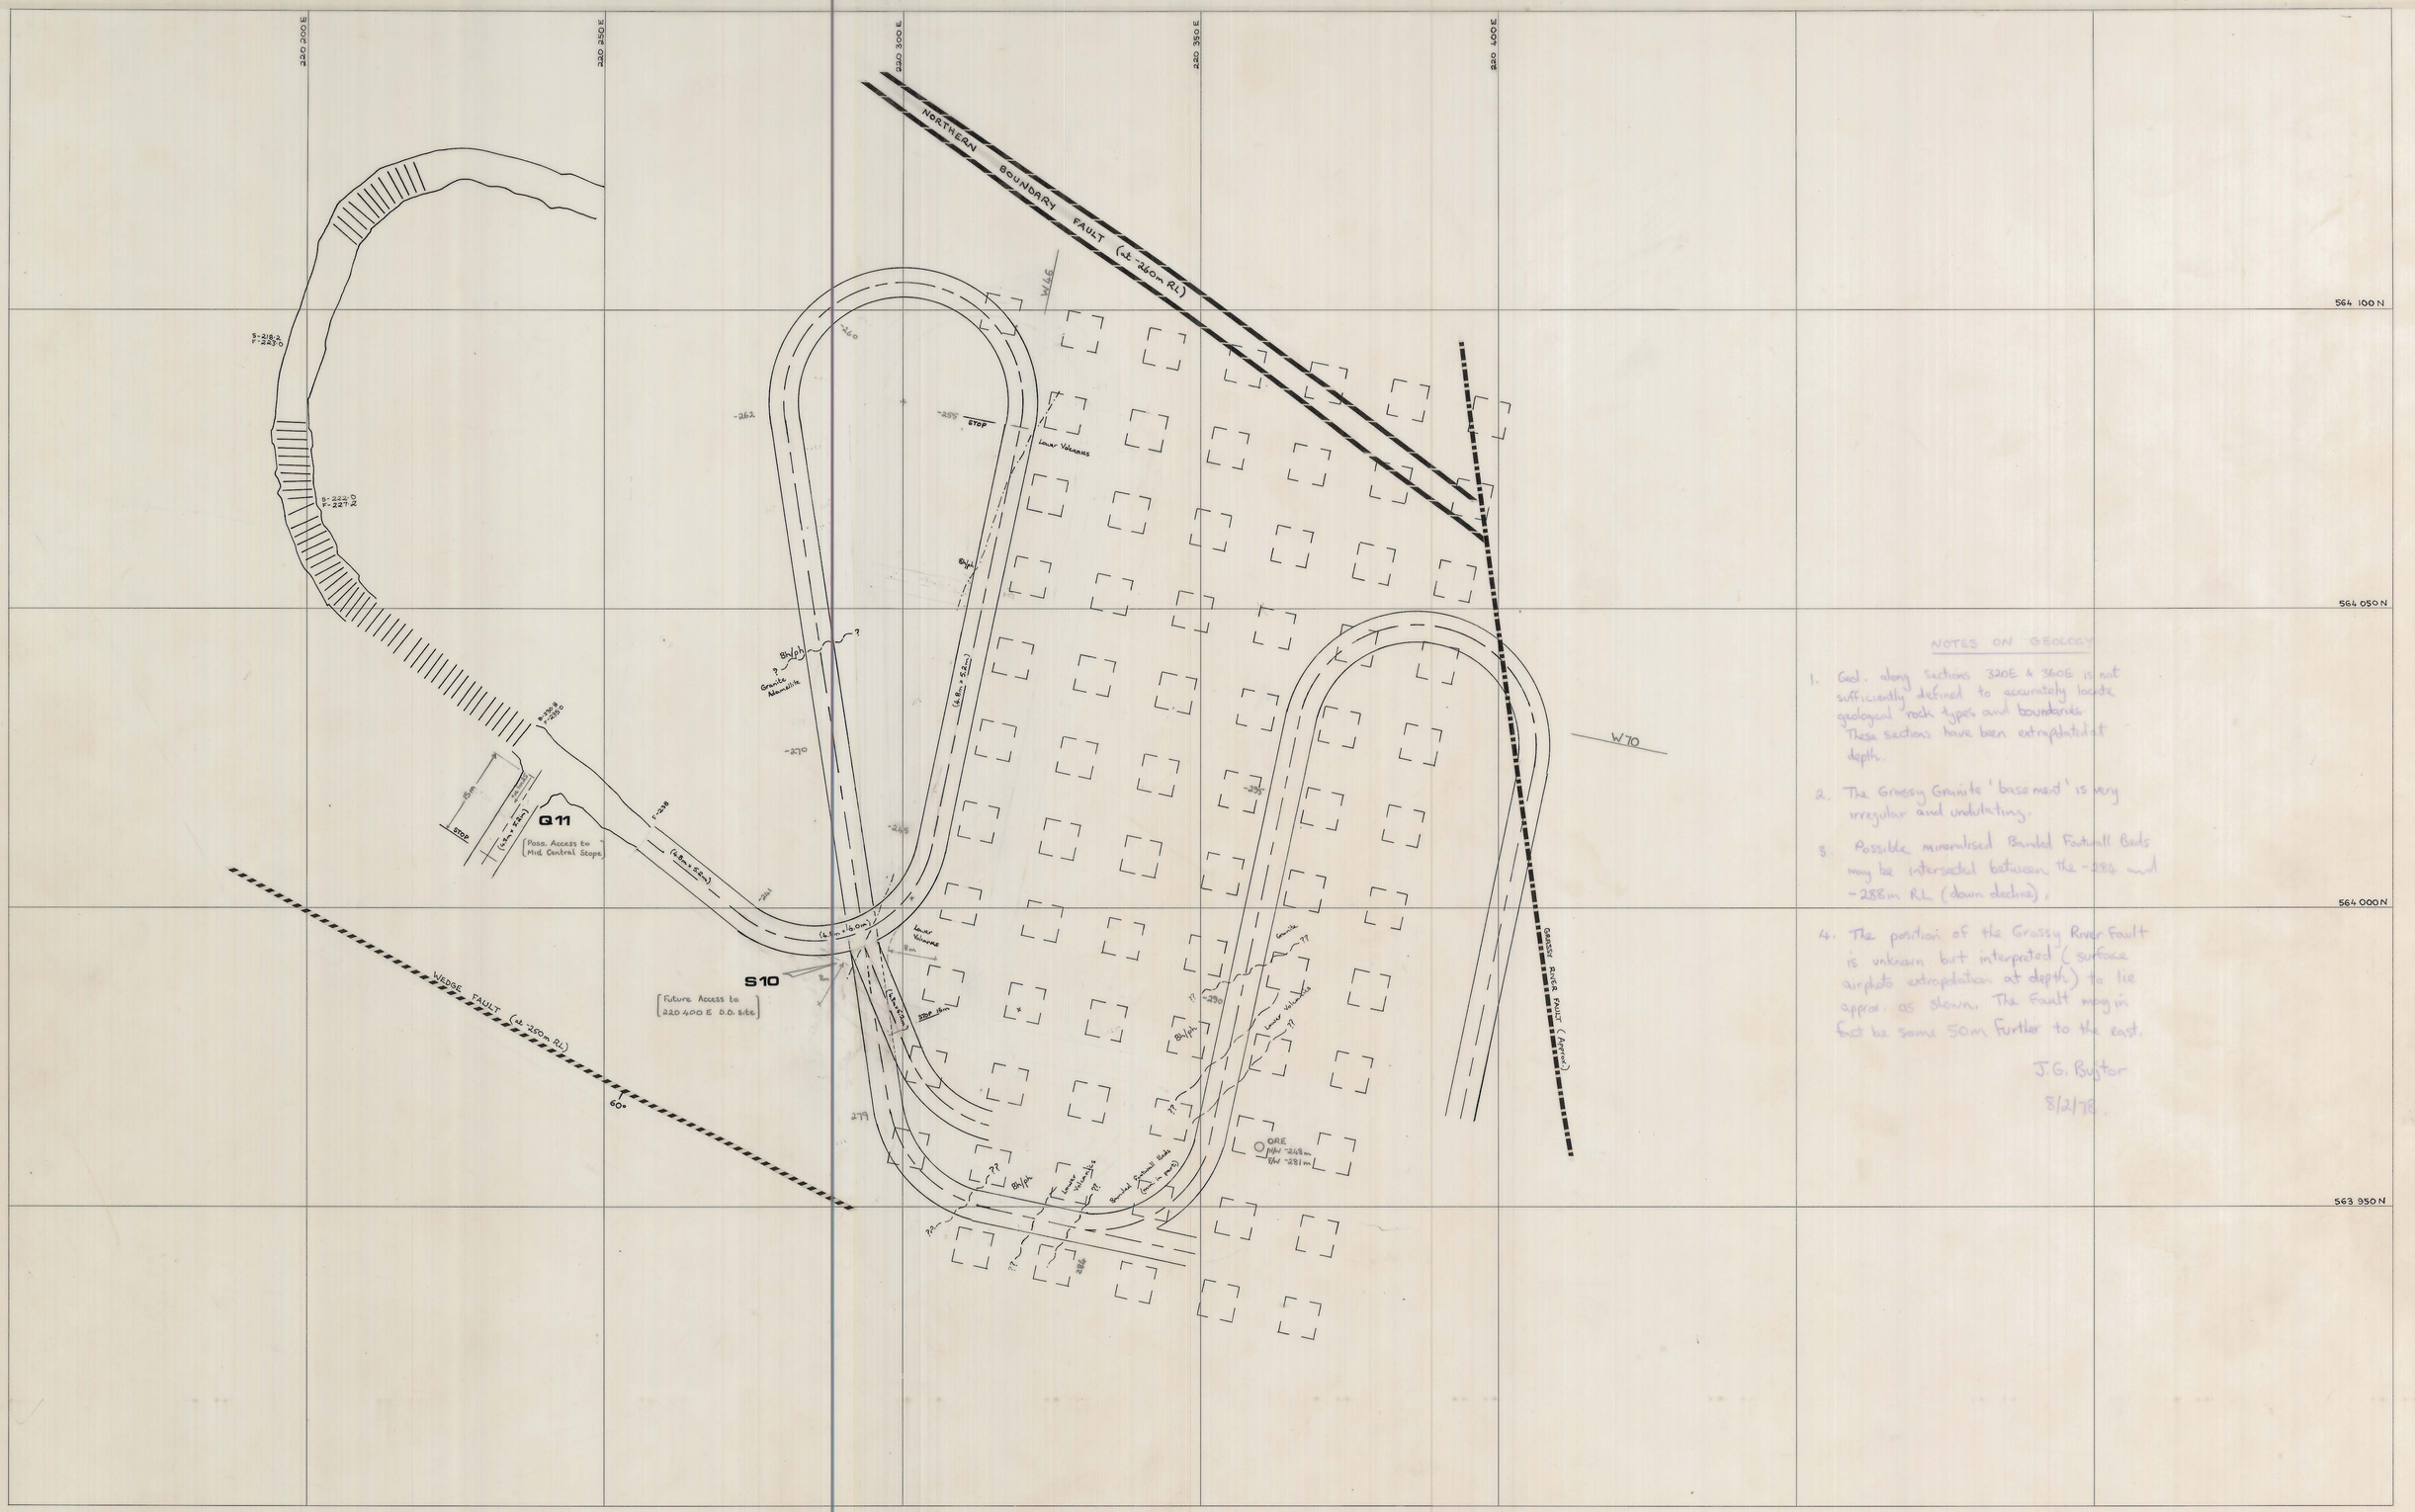

NOTES ON GEOLOGY

1. Geol. along sections 320E & 360E is not sufficiently defined to accurately locate geological rock types and boundaries. These sections have been extrapolated at depth.

2. The Grassy Granite 'basement' is very irregular and undulating.

3. Possible mineralised Banded Footwall Beds may be intersected between the -284 and -288m RL (down dip).

4. The position of the Grassy River Fault is unknown but interpreted (surface airphoto extrapolation at depth) to lie approx. as shown. The Fault may in fact be some 50m further to the east.

J.G. Buyter
8/2/78