27 JUN 1981

03DM03-1020.

0374_2488

CO-ORDINATES OF POINTS			
POINT	N	E	R.L.
1	564 097.52	220 223.09	B -181.9 F -186.7
2	564 138.6	220 231.82	B -178.7 F -183.5
3	564 129.87	220 272.90	B -184.7 F -188.5
4	564 140.68	220 222.04	B -179.4 F -184.2
5	564 151.5	220 171.0	B -138.3 F -143.1
6	564 150.25	220 177.04	B -139.3 F -144.1
7	564 147.63	220 189.36	B -139.3 F -144.1
8	564 191.33	220 185.77	B -145.3 F -150.1
9	564 193.41	220 176.02	B -145.3 F -150.1
10	564 182.6	220 226.7	B -151.3 F -156.1
11	564 155.21	220 221.03	B -155.3 F -160.1
12	564 150.01	220 245.49	B -159.7 F -165.5
13	564 100.43	220 209.39	B -163.3 F -168.1
14	564 102.51	220 199.61	B -163.3 F -168.1
15	564 091.7	220 250.47	B -169.2 F -174.0

B -178.3 F -184.2) pick-up.

	N	E	R.L.
A	564 157.29	220 211.85	B -153.3 F -160.1

16
124
67
21

SUPERSEDED.
(SEE 03DM04-1034).
6/7/81.

NOTE: THE GEOLOGICAL INFORMATION AVAILABLE AT THE TIME THE ACCESSES WERE REVISED IS DATED APRIL, 1980.
THE STOPE SECTIONS SHOWN WERE PROVIDED BY W. BLACK, IN MAY, 1980.

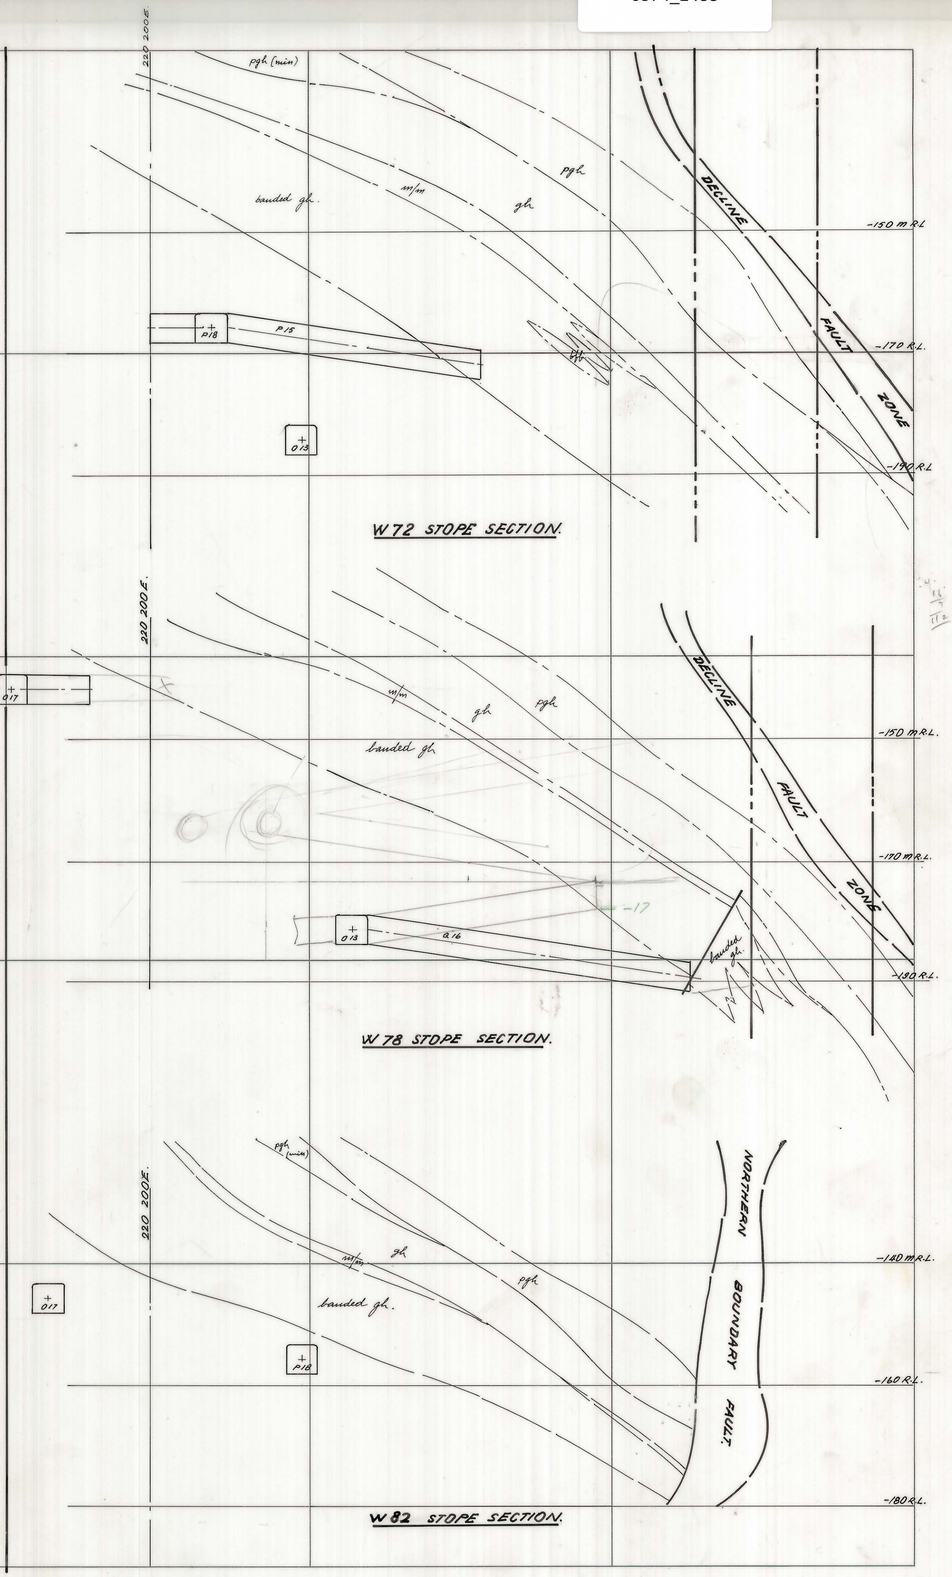

REVISIONS			INITIALS
Nº	DATE		
1	13-10-80	O13 L/BAY, O13 L/BAY, P17 ACCESS & P17 L/BAY. Dgt.	P.B.
2	18-2-81	Q16.	P.B.
		DEV OFF O13 - FINAL OK.	

APPROVAL	INITIALS	DATE	COPY
PLANNING ENGINEER	P.B.	16-7-80	
SNR. PLANNING ENGINEER			
TECHNICAL SERVICES SUPT.		16/7/80	
GENERAL MINING SUPT.		6/8/80	
MINE SUPT.		16/7/80	
SNR. SURVEYOR (2)		16/7/80	2
SNR. GEOLOGIST		18/7/80	1

SCALE 1: 500

north

LOCATION: DOLPHIN MINE

SUBJECT: MID WEDGE STOPE ACCESS. N17, O13.

REVISION 1.

KING ISLAND SCHEELITE
A DIVISION OF WARMAN INTERNATIONAL

GRASSY KING ISLAND

PLAN NUMBER: 03DM03-1020/1