5 cm
03DM04-1005
0374_2493

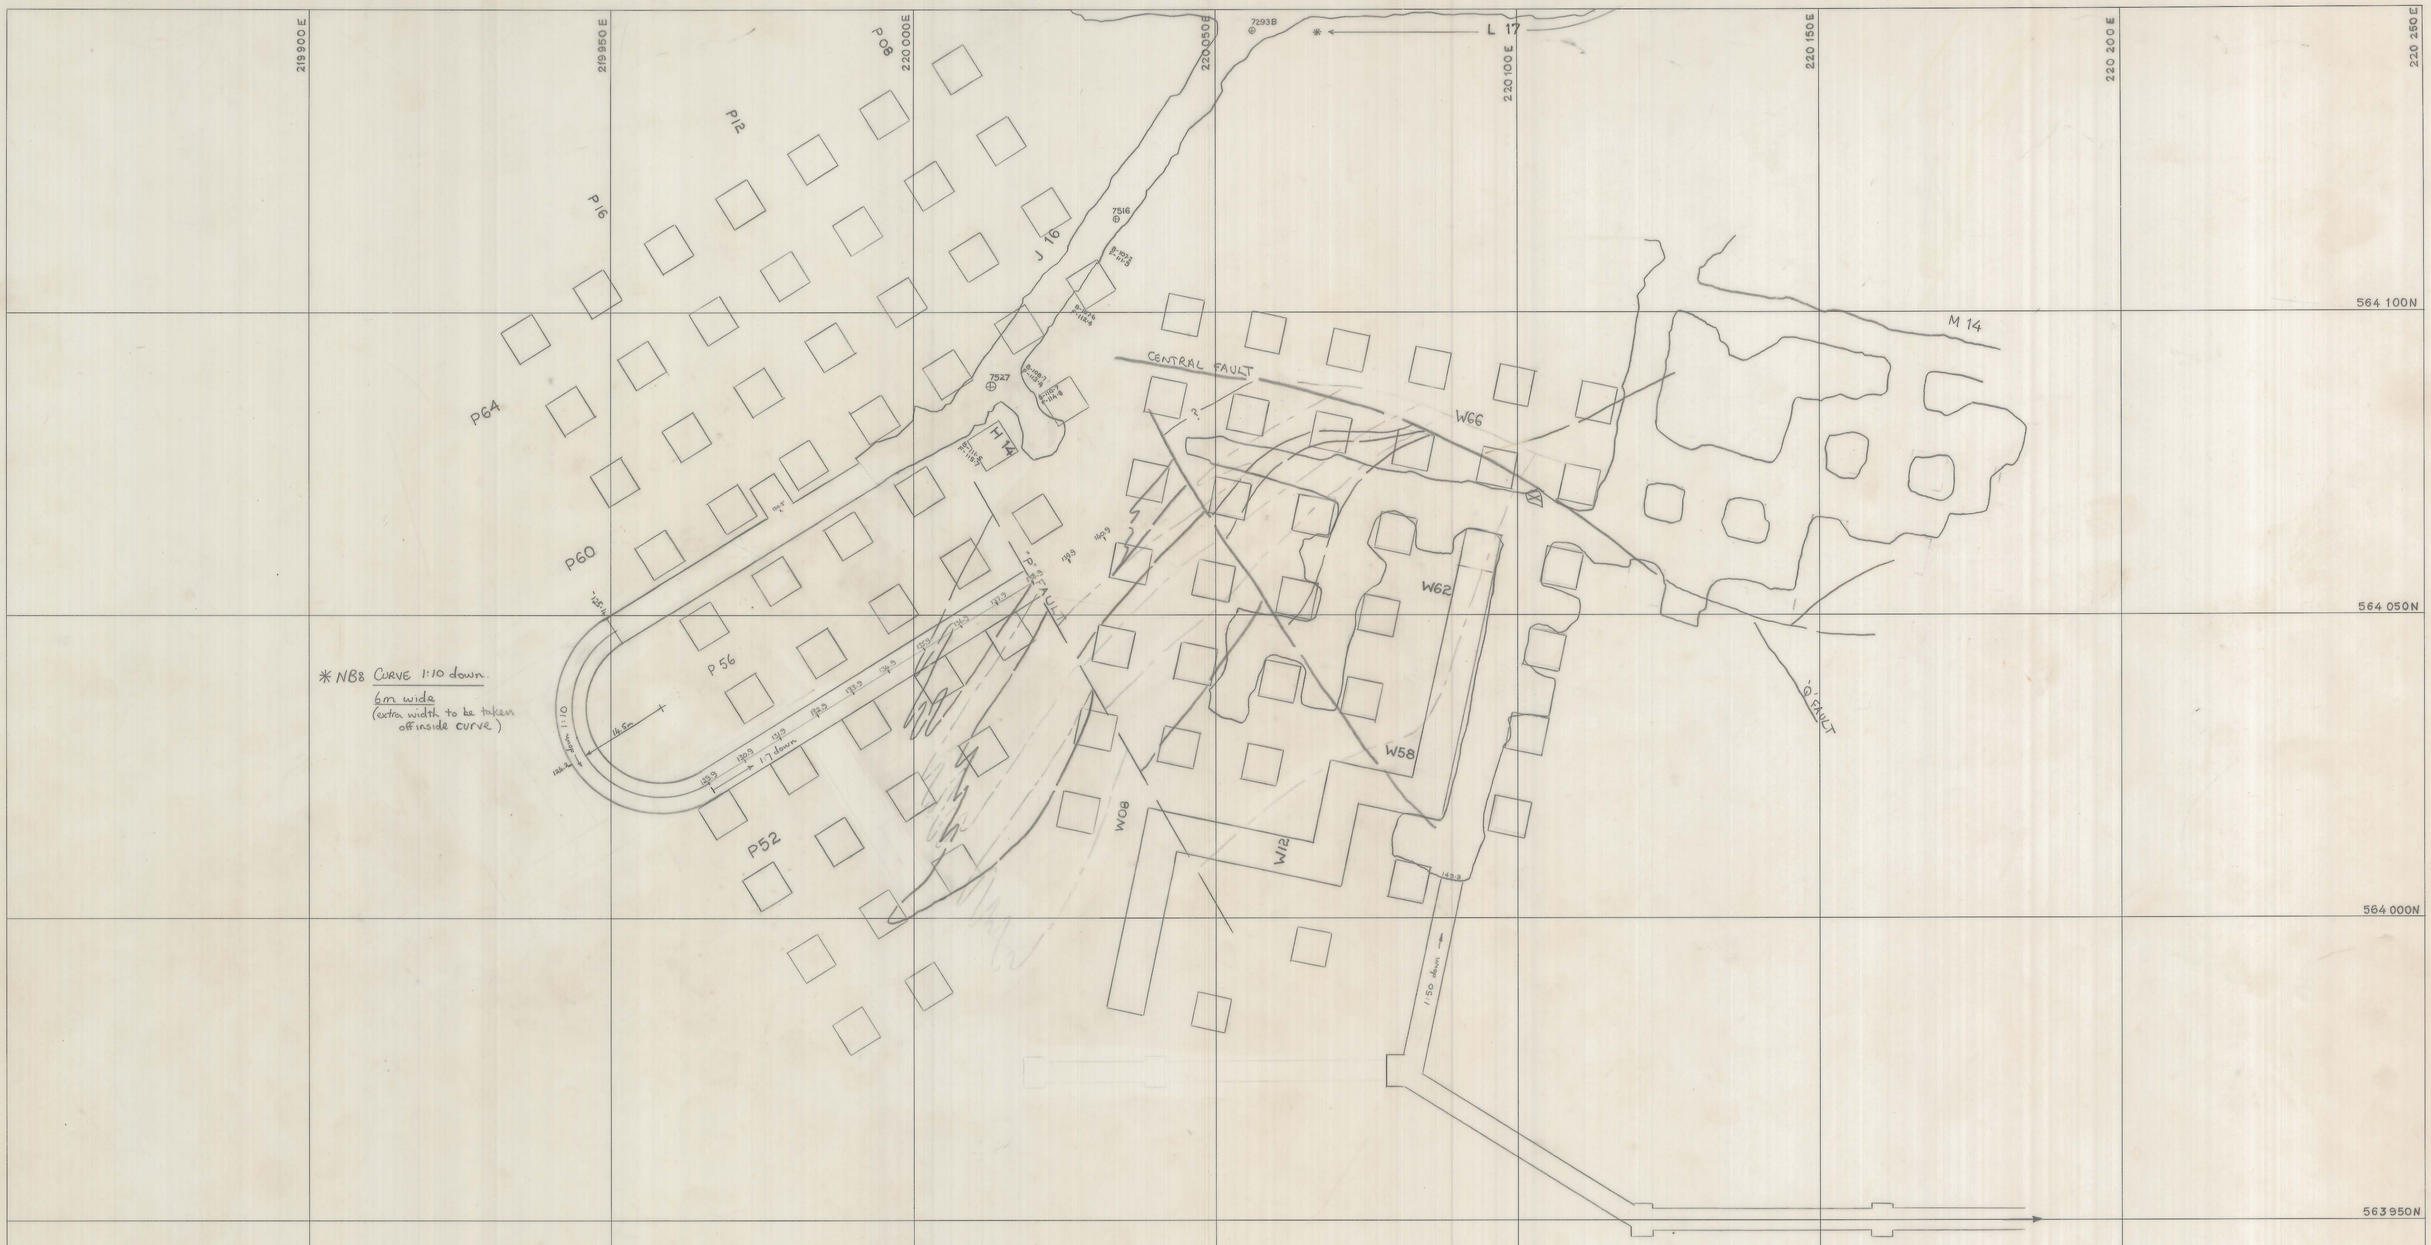

NOTE: -139m RL. GEOLOGY SHOWN

REVISIONS NO	DATE	DESCRIPTION	INITIALS
1	18.11.76	J16 redesigned, deletion of DD positions West of 220 080 E	

KING ISLAND SCHEELITE		APPROVAL	COPY
DATE:	SCALE: 1:500	PLANNING ENG.:	
MINE: DOLPHIN	DWG/NO.: 03 DM 04 1005	SENIOR PLAN. ENG.:	1
STOPE ACCESS — J 16		MINE SUPT.:	2
		G. MINING SUPT.:	1
		SENIOR SURV'R.:	1
		SENIOR GEOLOGIST:	1
		SURVEYOR:	
PRELIMINARY	X FINAL		