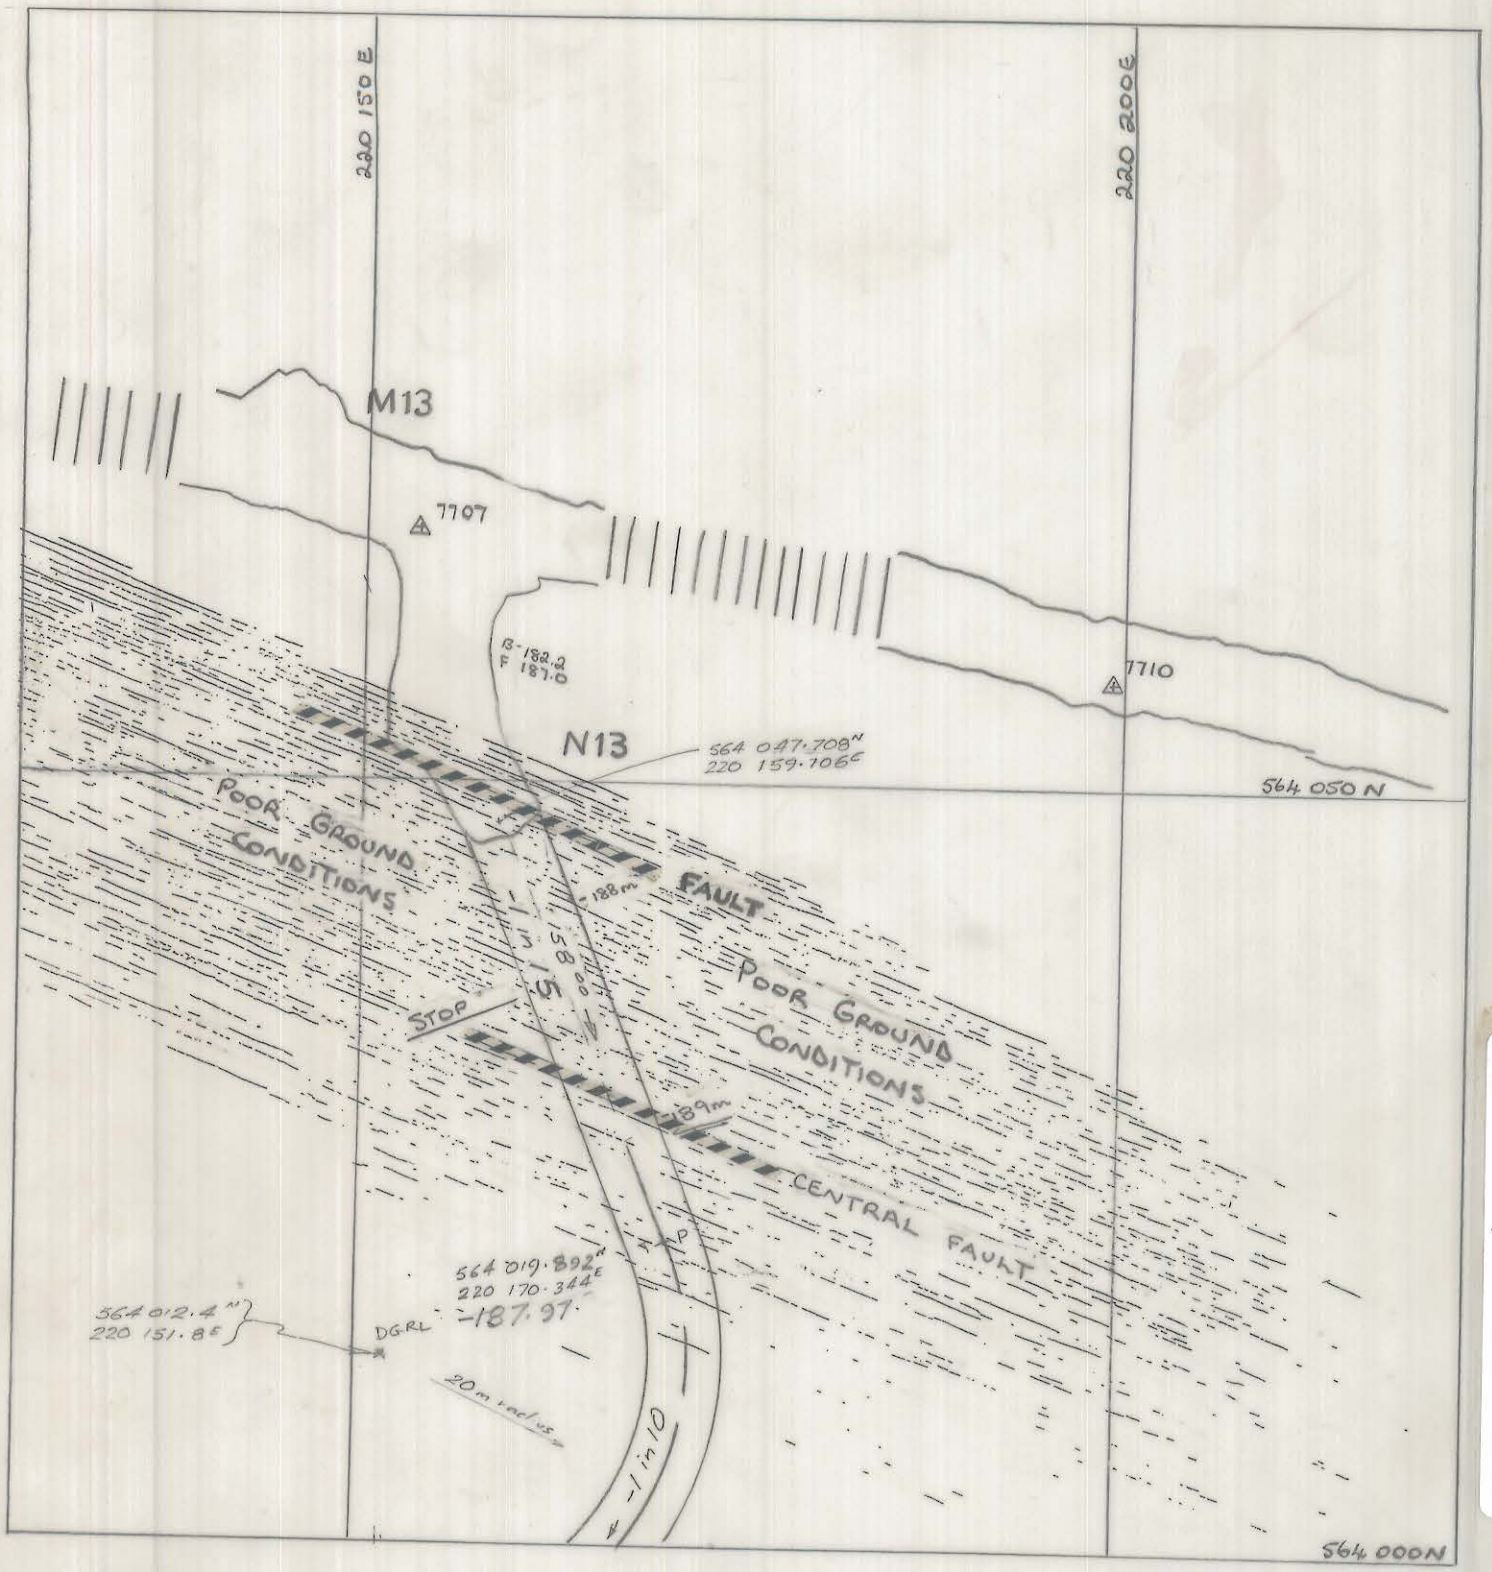

KING ISLAND SCHEELITE				APPROVAL		COPY
DATE: 18 MAY 1978	SCALE: 1:500			PLANNING ENG.:		
MINE: DOLPHIN	DWG/NO.: 03 DM 04 4001			SENIOR PLAN. ENG.:		
N13 PIT STOPE RAMP ACCESS				MINE SUPT.:		
(Modification to drwg 03DM03-1009)				G. MINING SUPT.:		
				SENIOR SURV'R.:		
size: 4.6 x 5.2				SENIOR GEOLOGIST:	19-5-78	1
PRELIMINARY		FINAL		SURVEYOR:		

27 JUN 1981
0374_2506
5 cm
03DM03-4001