5 cm

0374_2559

03 DM04 - 3020

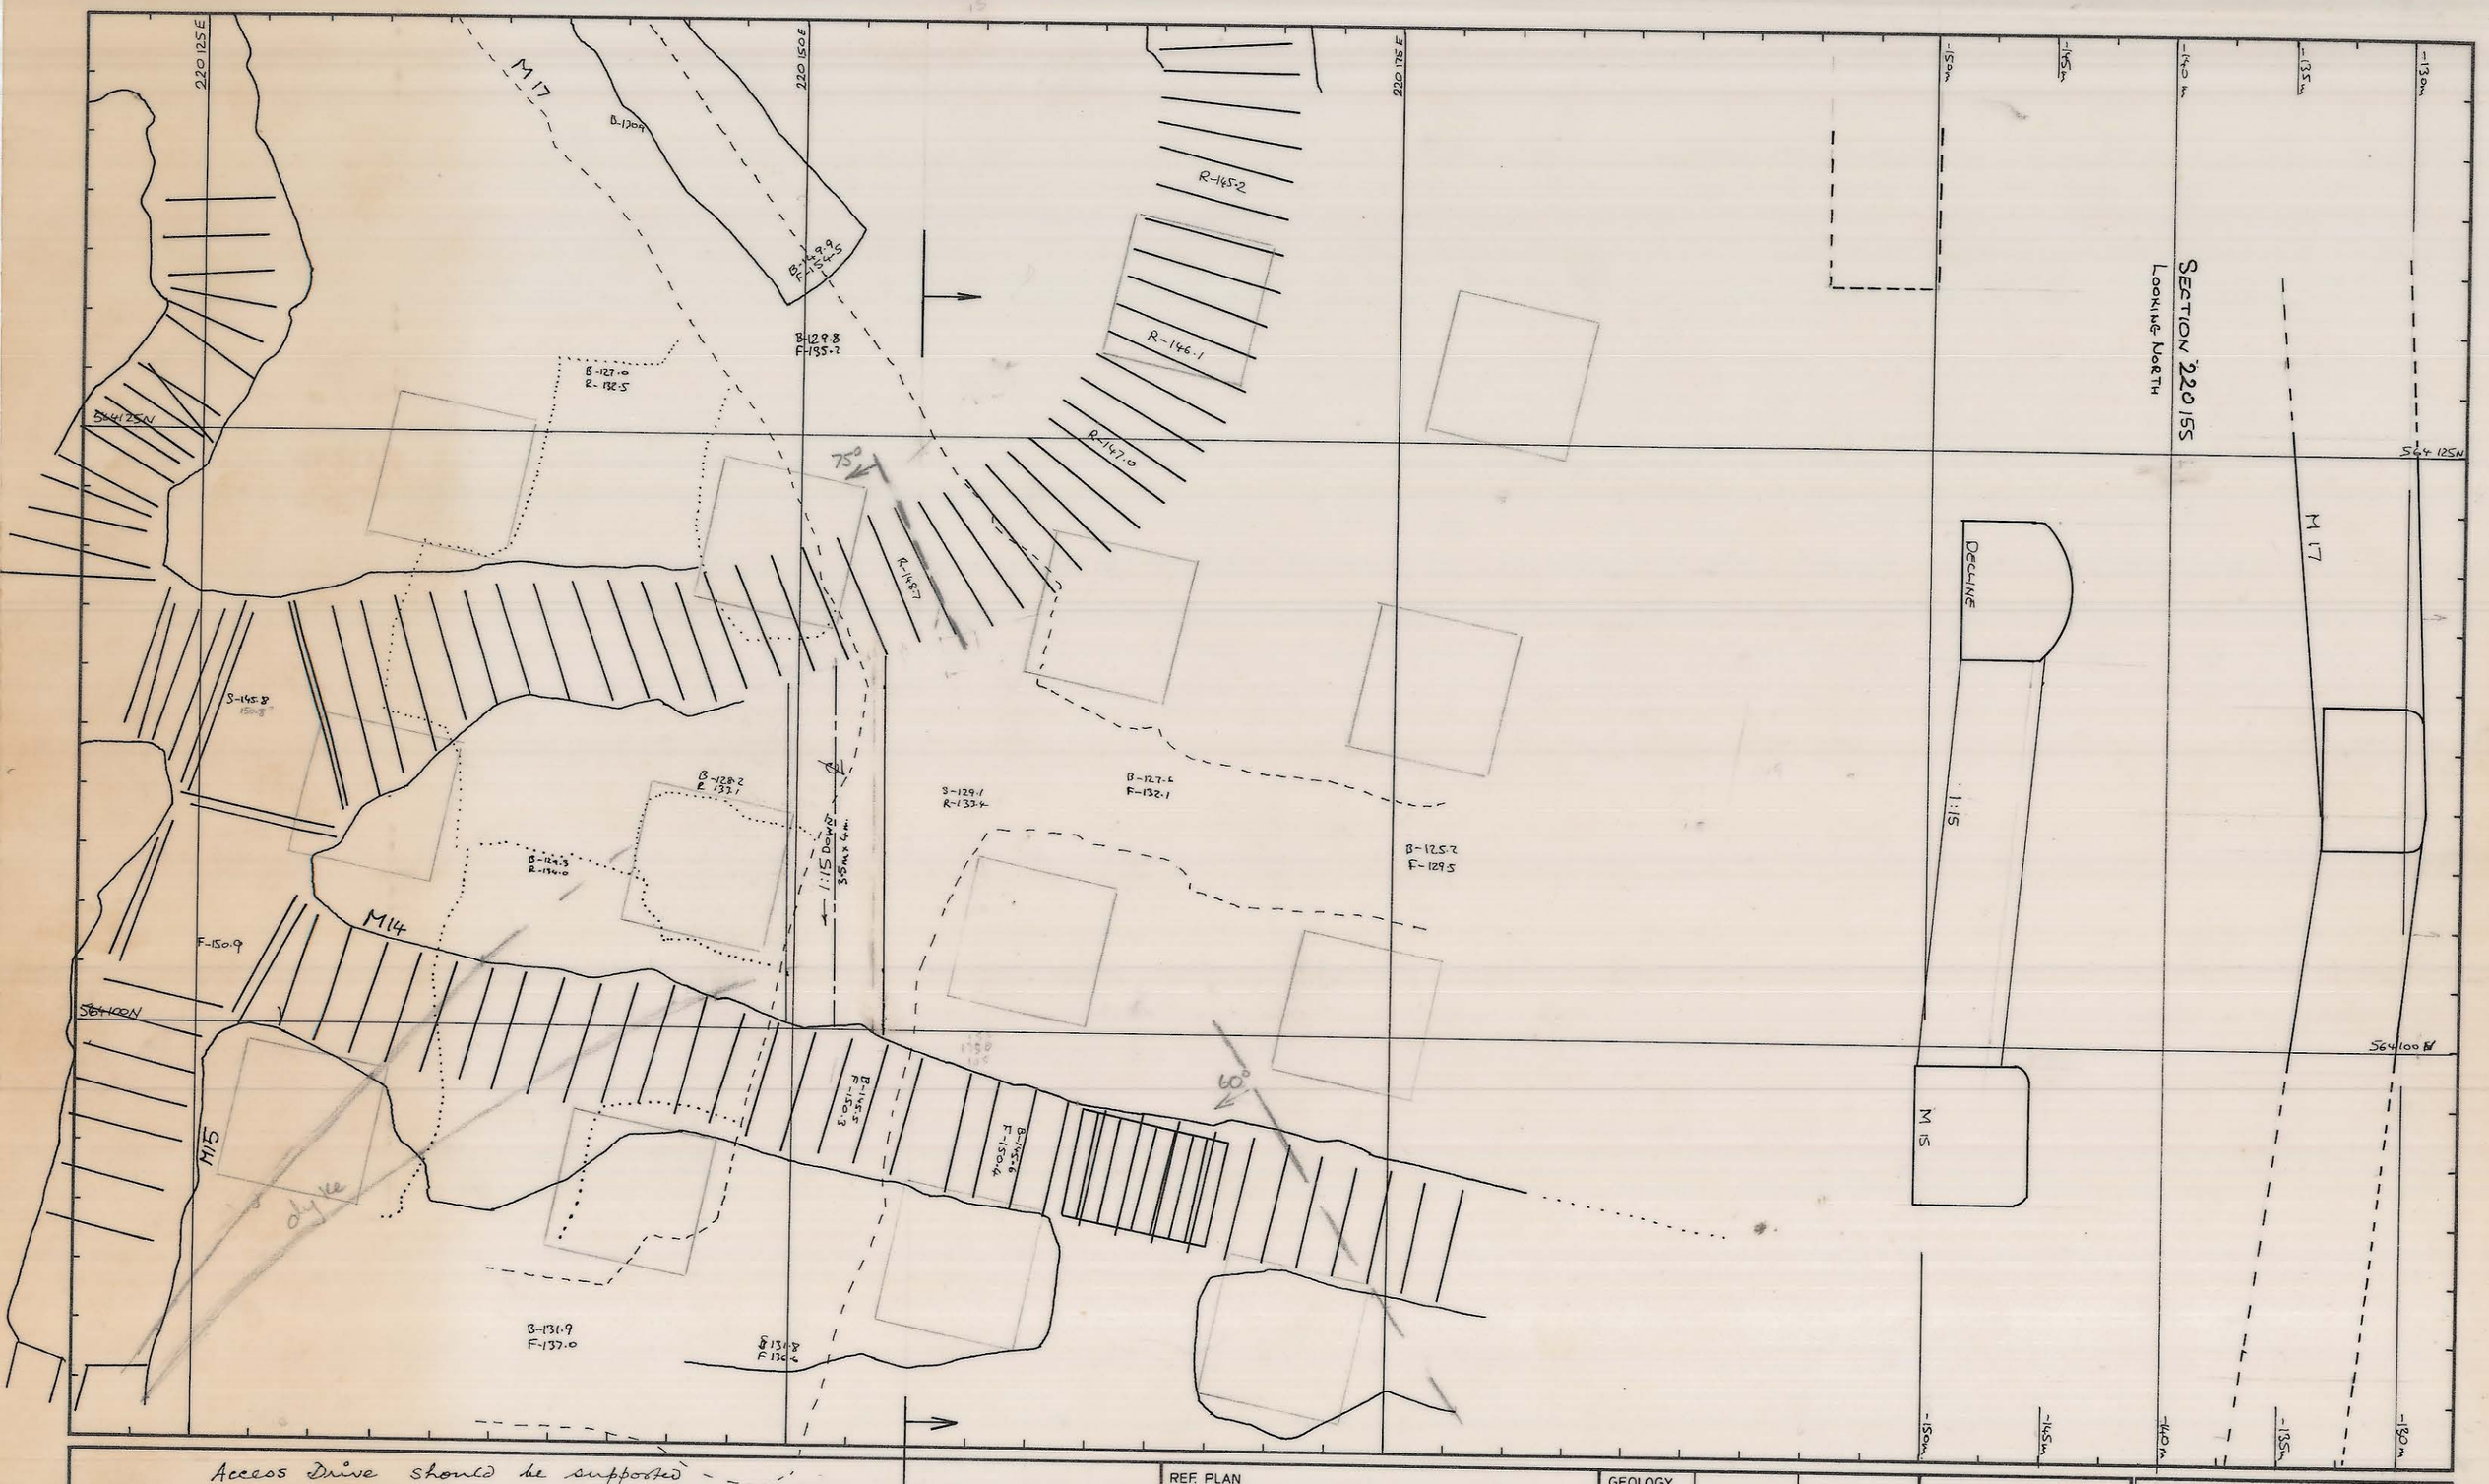

Access Drive should be supported by grouted rebar. 24mm dia 2.4 m long @ 1.2 M spacing.
FIRST 4 Metre and last 4 metre ground is expected to be fractured.

REF. PLAN			
GEOLOGY			
SURVEY			
PLANNING	W. [illegible]	14 7 81	
ROCK MEC.	[illegible]	16.7.81	
GRADE CON.			
DRAFTING			
T.S.S.			

SCALE 1:250

KING ISLAND SCHEELITE
GRASSY KING ISLAND

ACCESS TO 150m. LEVEL.

DRAWING NUMBER
03DM04 - 3020