0374_2567

03 DM 04 3006

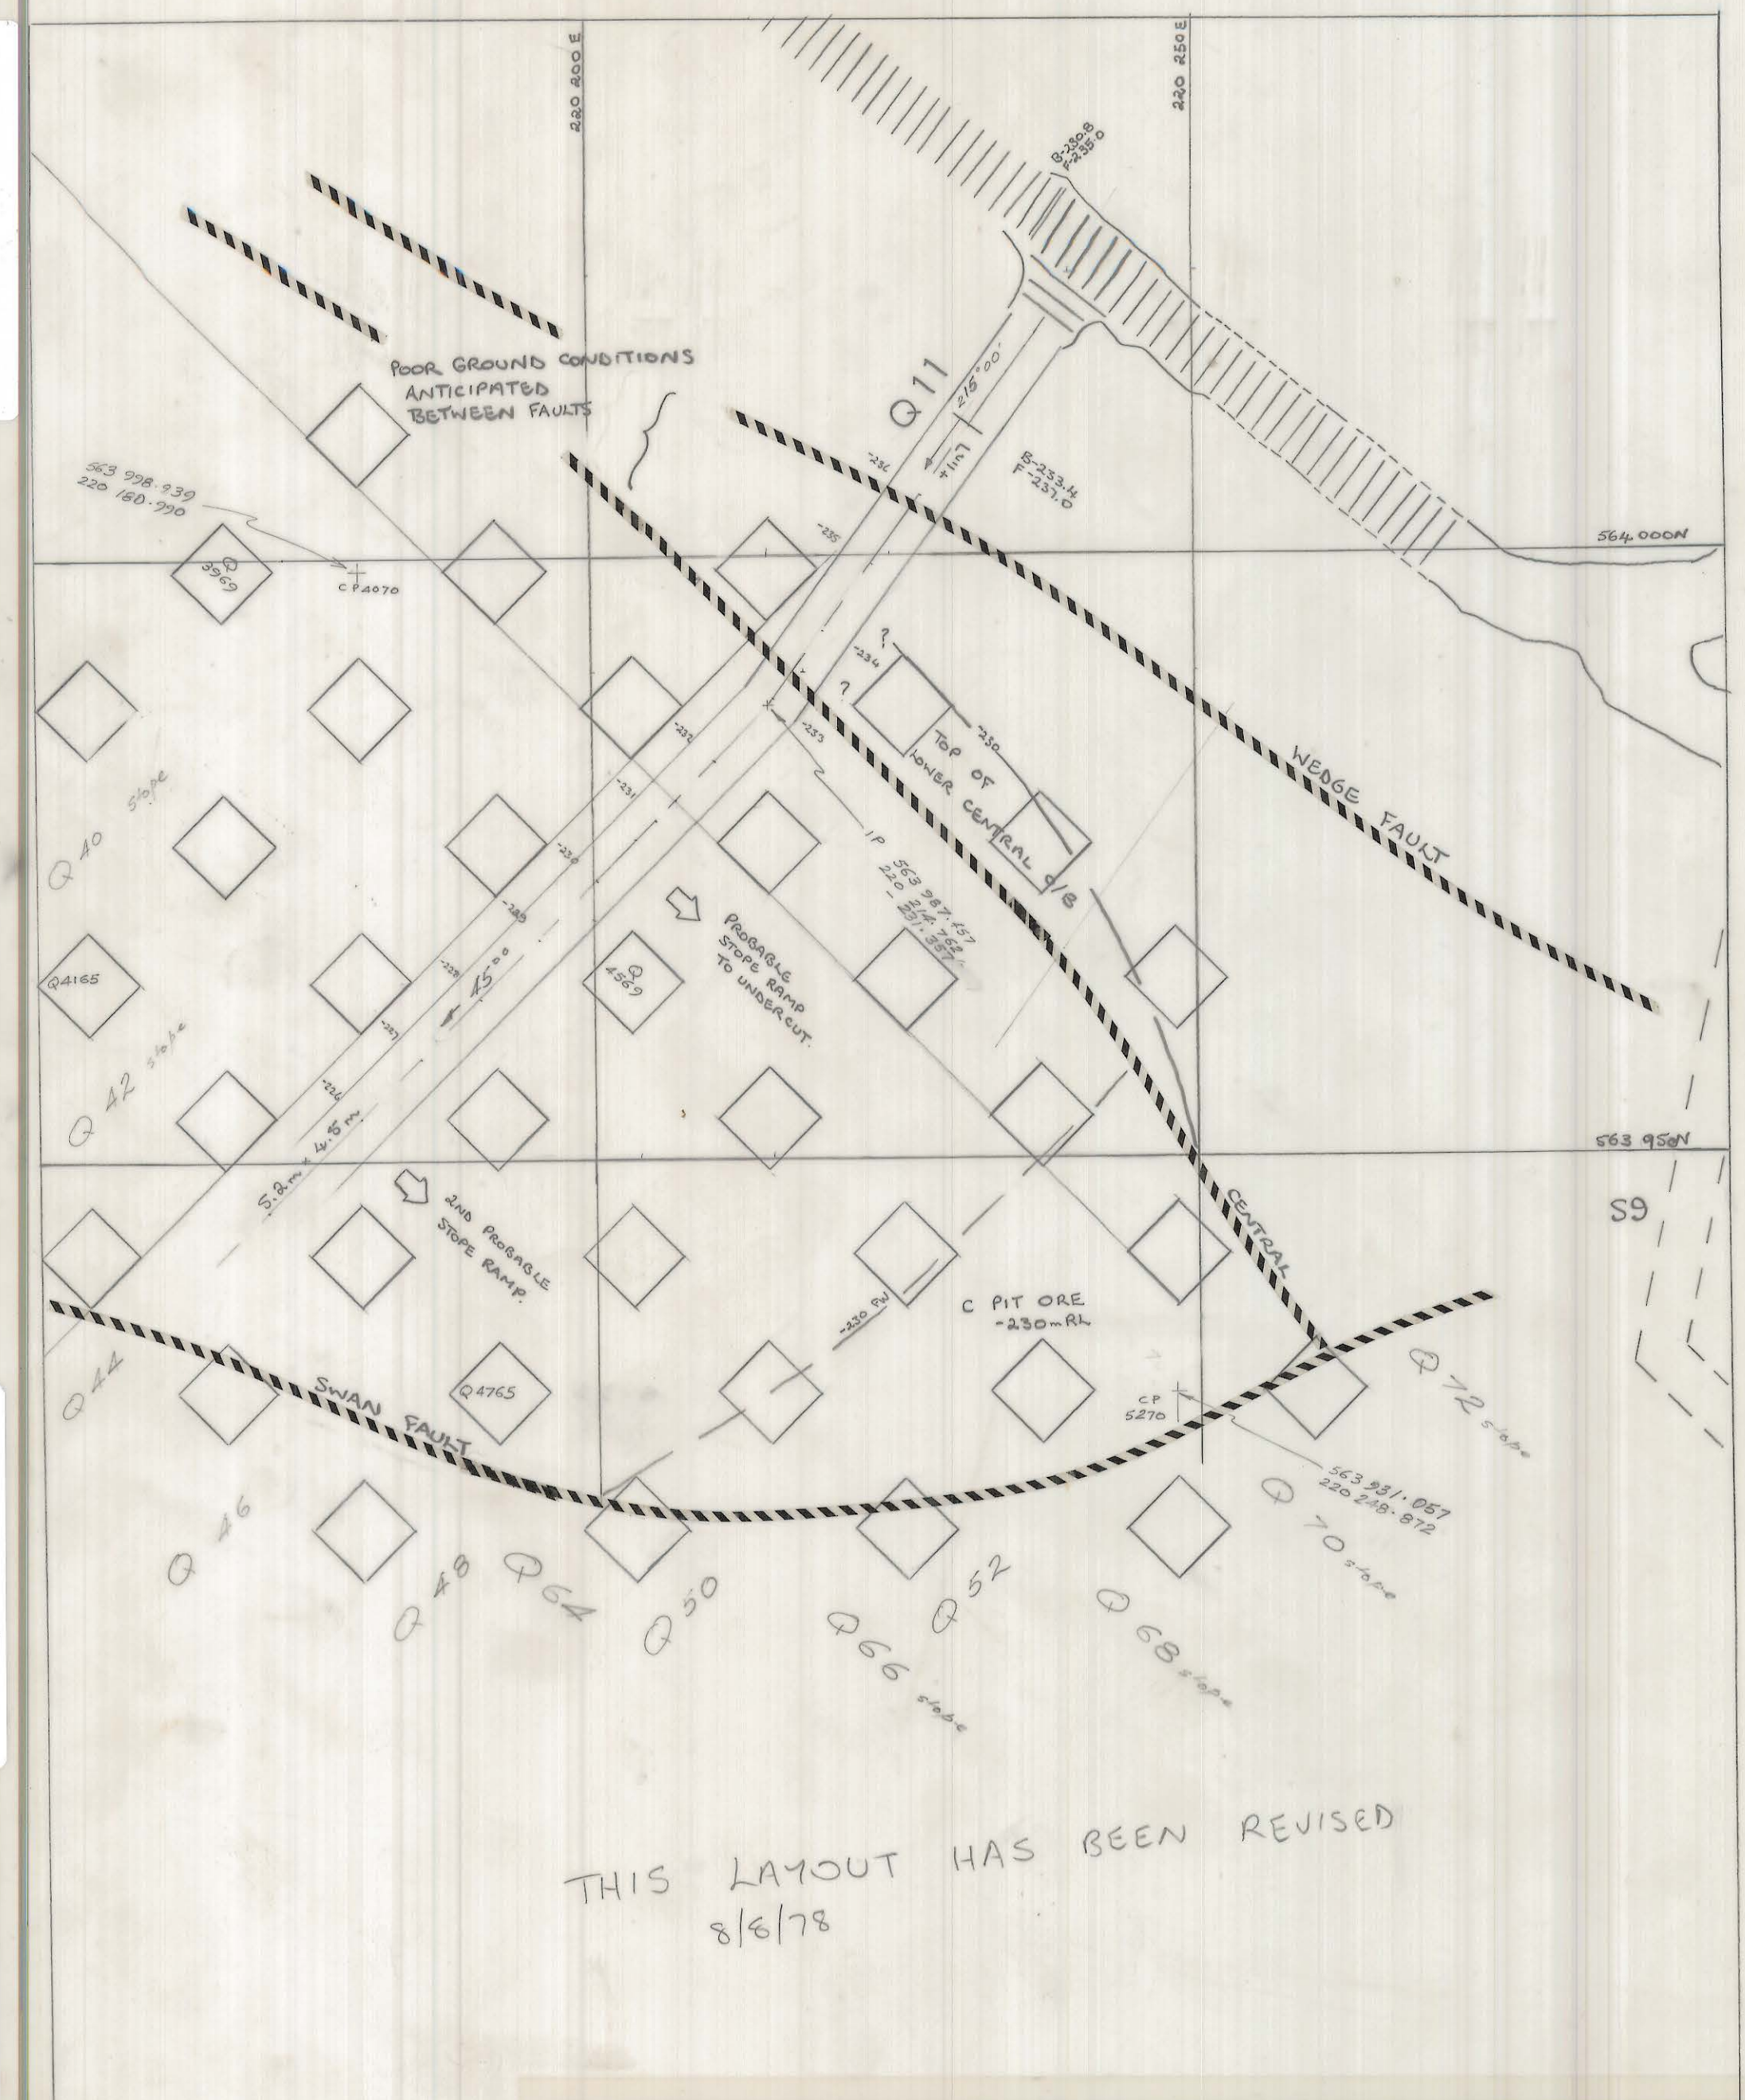

THIS LAYOUT HAS BEEN REVISED
8/8/78

KING ISLAND SCHEELITE		APPROVAL	COPY
DATE: 7 JULY 1978	SCALE: 1:500	PLANNING ENG.:	
MINE: DOLPHIN	DWG/NO.: 03DM04 3006	SENIOR PLAN. ENG.:	
Q11 PIT STOPE ACCESS		MINE SUPT.:	2
		G. MINING SUPT.:	
		SENIOR SURV'R.:	
6m x 6m PILLARS & 10m STOPE WIDTH		SENIOR GEOLOGIST:	1
		SURVEYOR:	
PRELIMINARY	FINAL		

5 cm