


5 cm

0374_2601

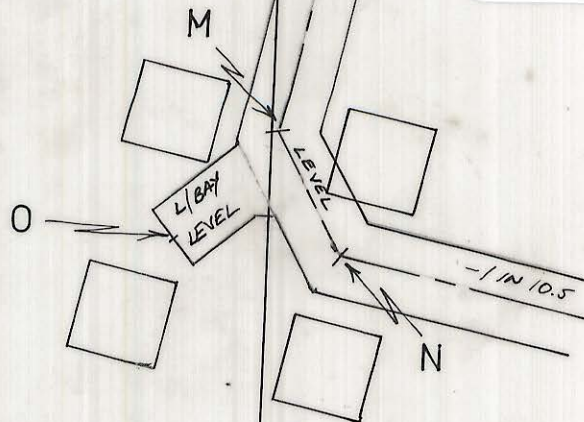

584 100N

PT	N	E	R.L.
M	584 124.0	220 200.5	173.3 f
N	584 116.0	220 204.7	173.3 f
O	584 116.5	220 193.8	173.3 f

20 200N