03DM05-3007

0374_2637

5 cm

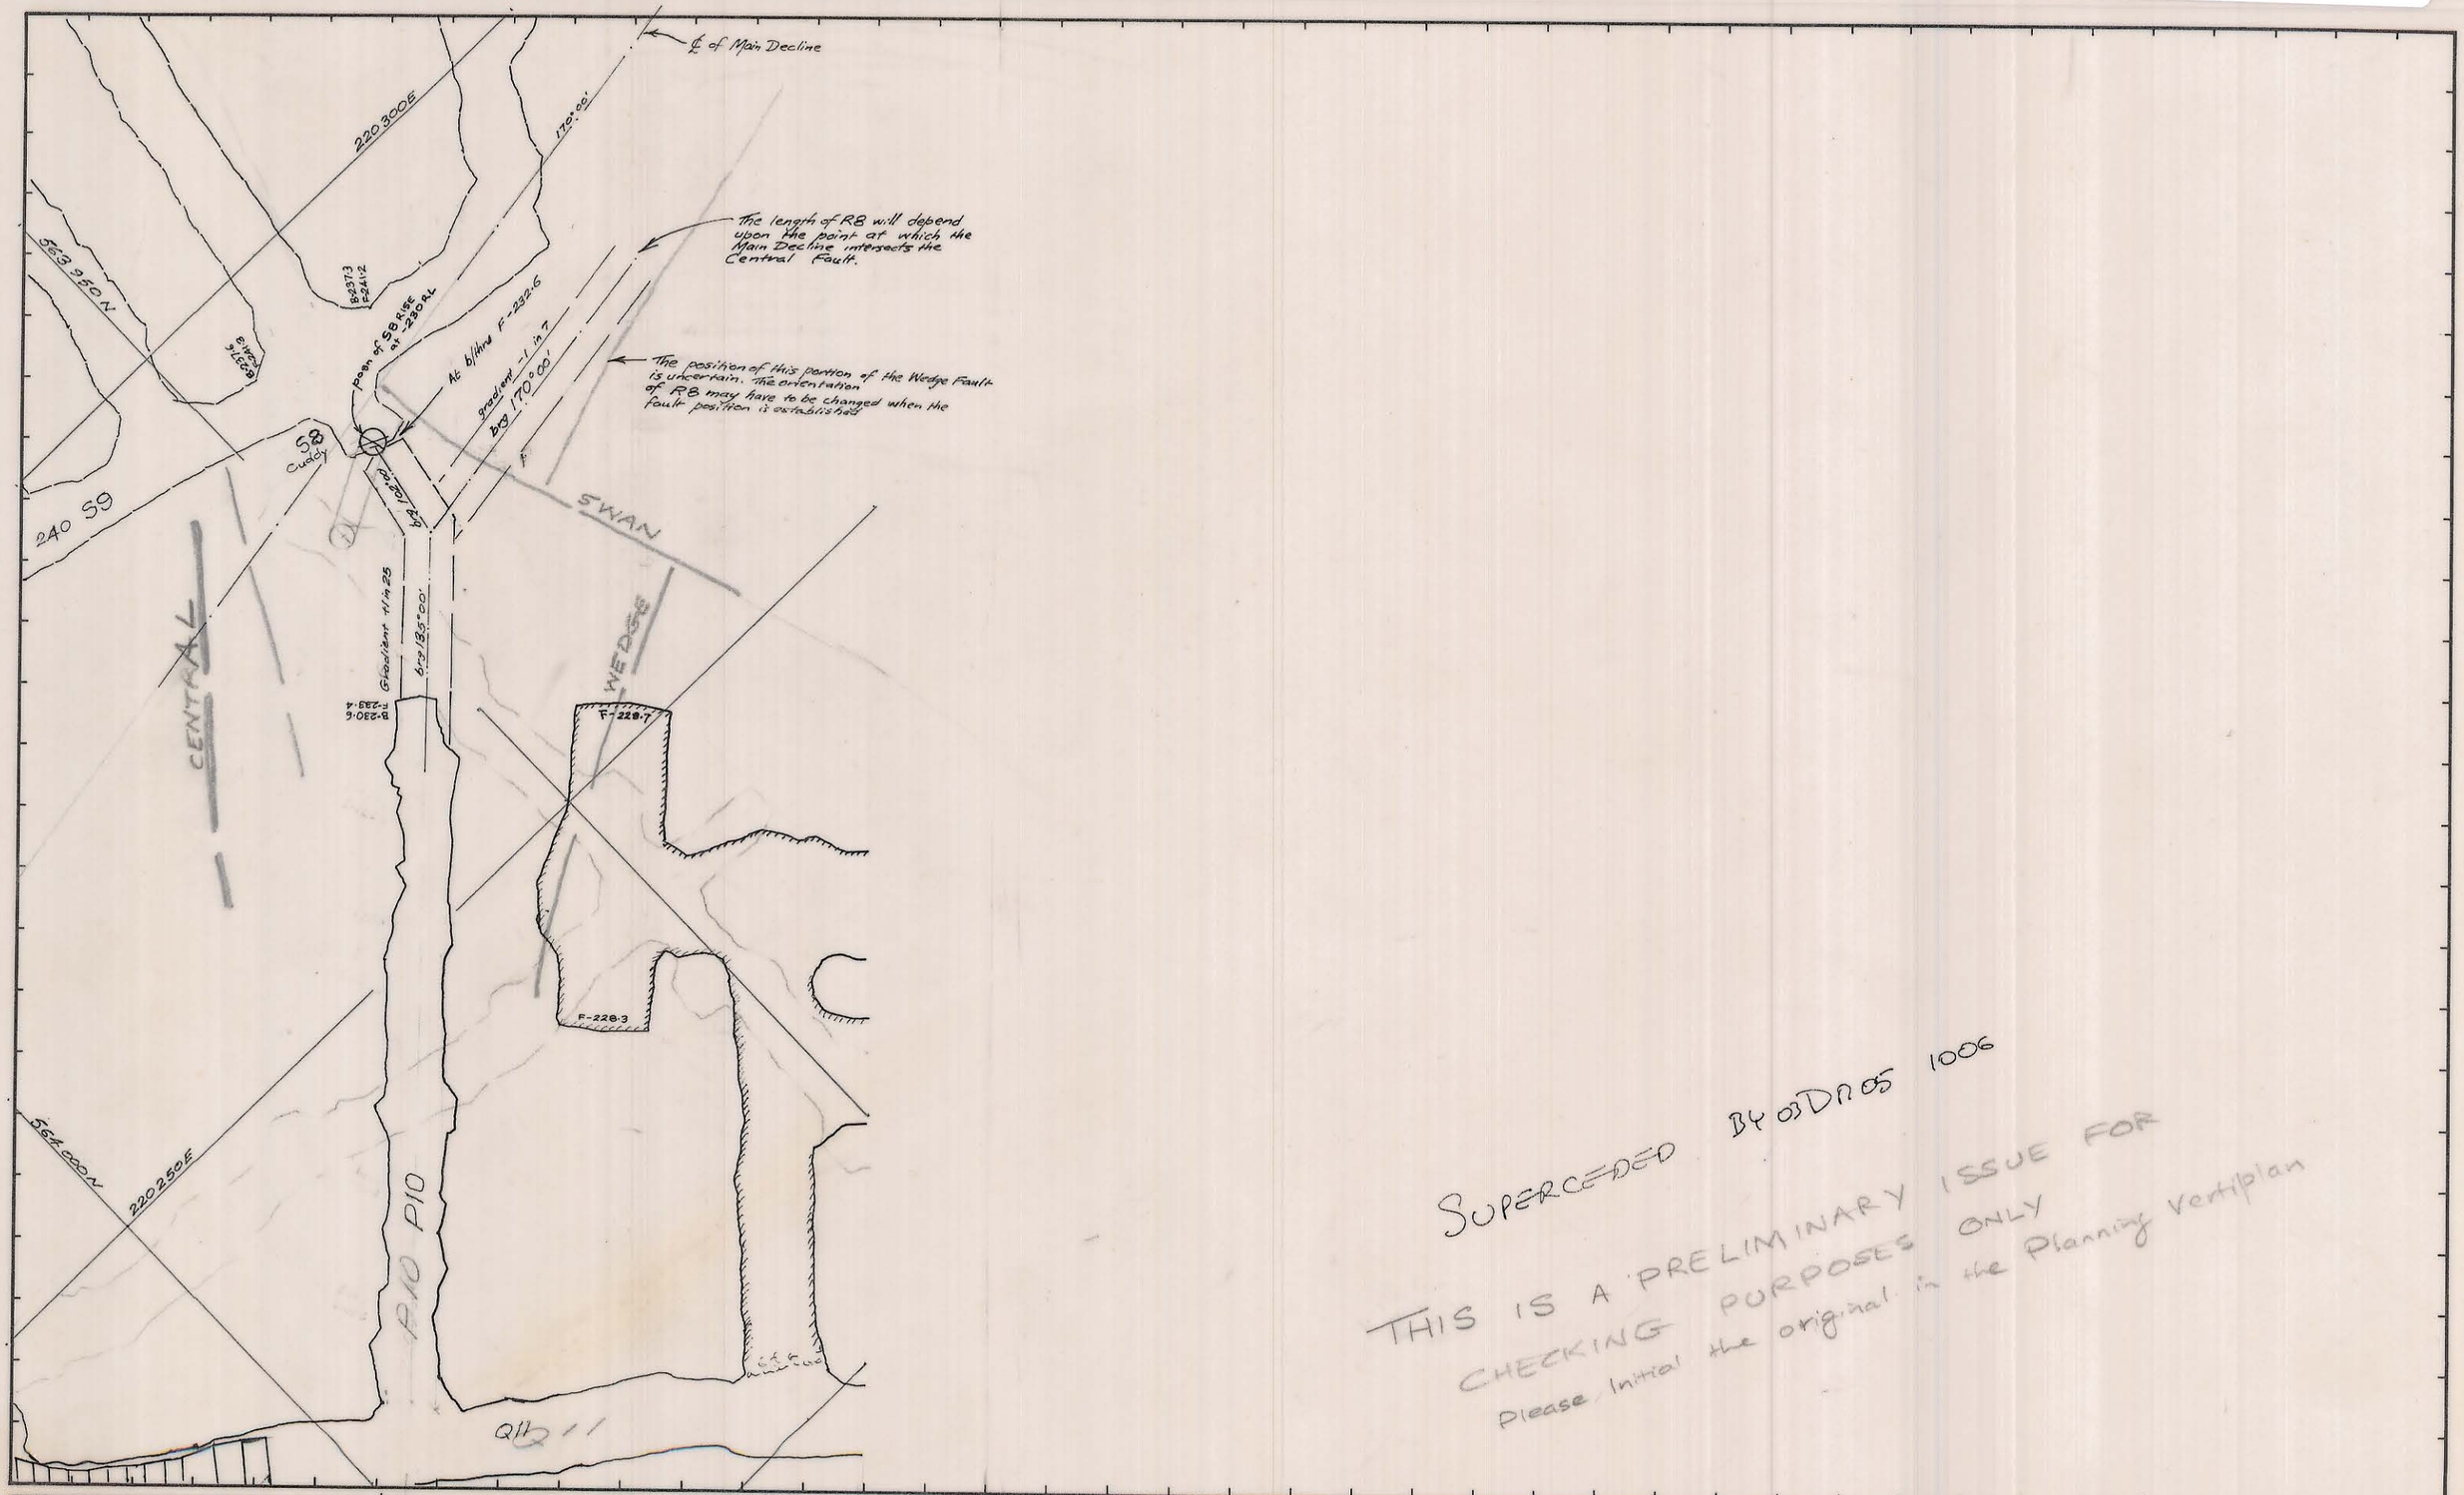


SUPERCEDED BY 03DM05 1006

THIS IS A PRELIMINARY ISSUE FOR CHECKING PURPOSES ONLY
Please initial the original in the Planning Ventiplan

| | | | | |
|---|---|---|---|---|
| REF. PLAN | GEOLOGY | RESP | 2-9-81 | SCALE 1:500 |
| Geology at -230 RL | SURVEY | | | KING ISLAND SCHEELITE GRASSY KING ISLAND |
| | PLANNING | | | VENTILATION P10 & RB VENT RETURN DRIVES For Lower Wedge and Lower Central |
| | ROCK MEC. | | | |
| | GRADE CON. | | | |
| | DRAFTING | | | DRAWING NUMBER 03DM05-3007 |
| | T.S.S. | | | |