5 cm
03Dm07-1025
0374_2651

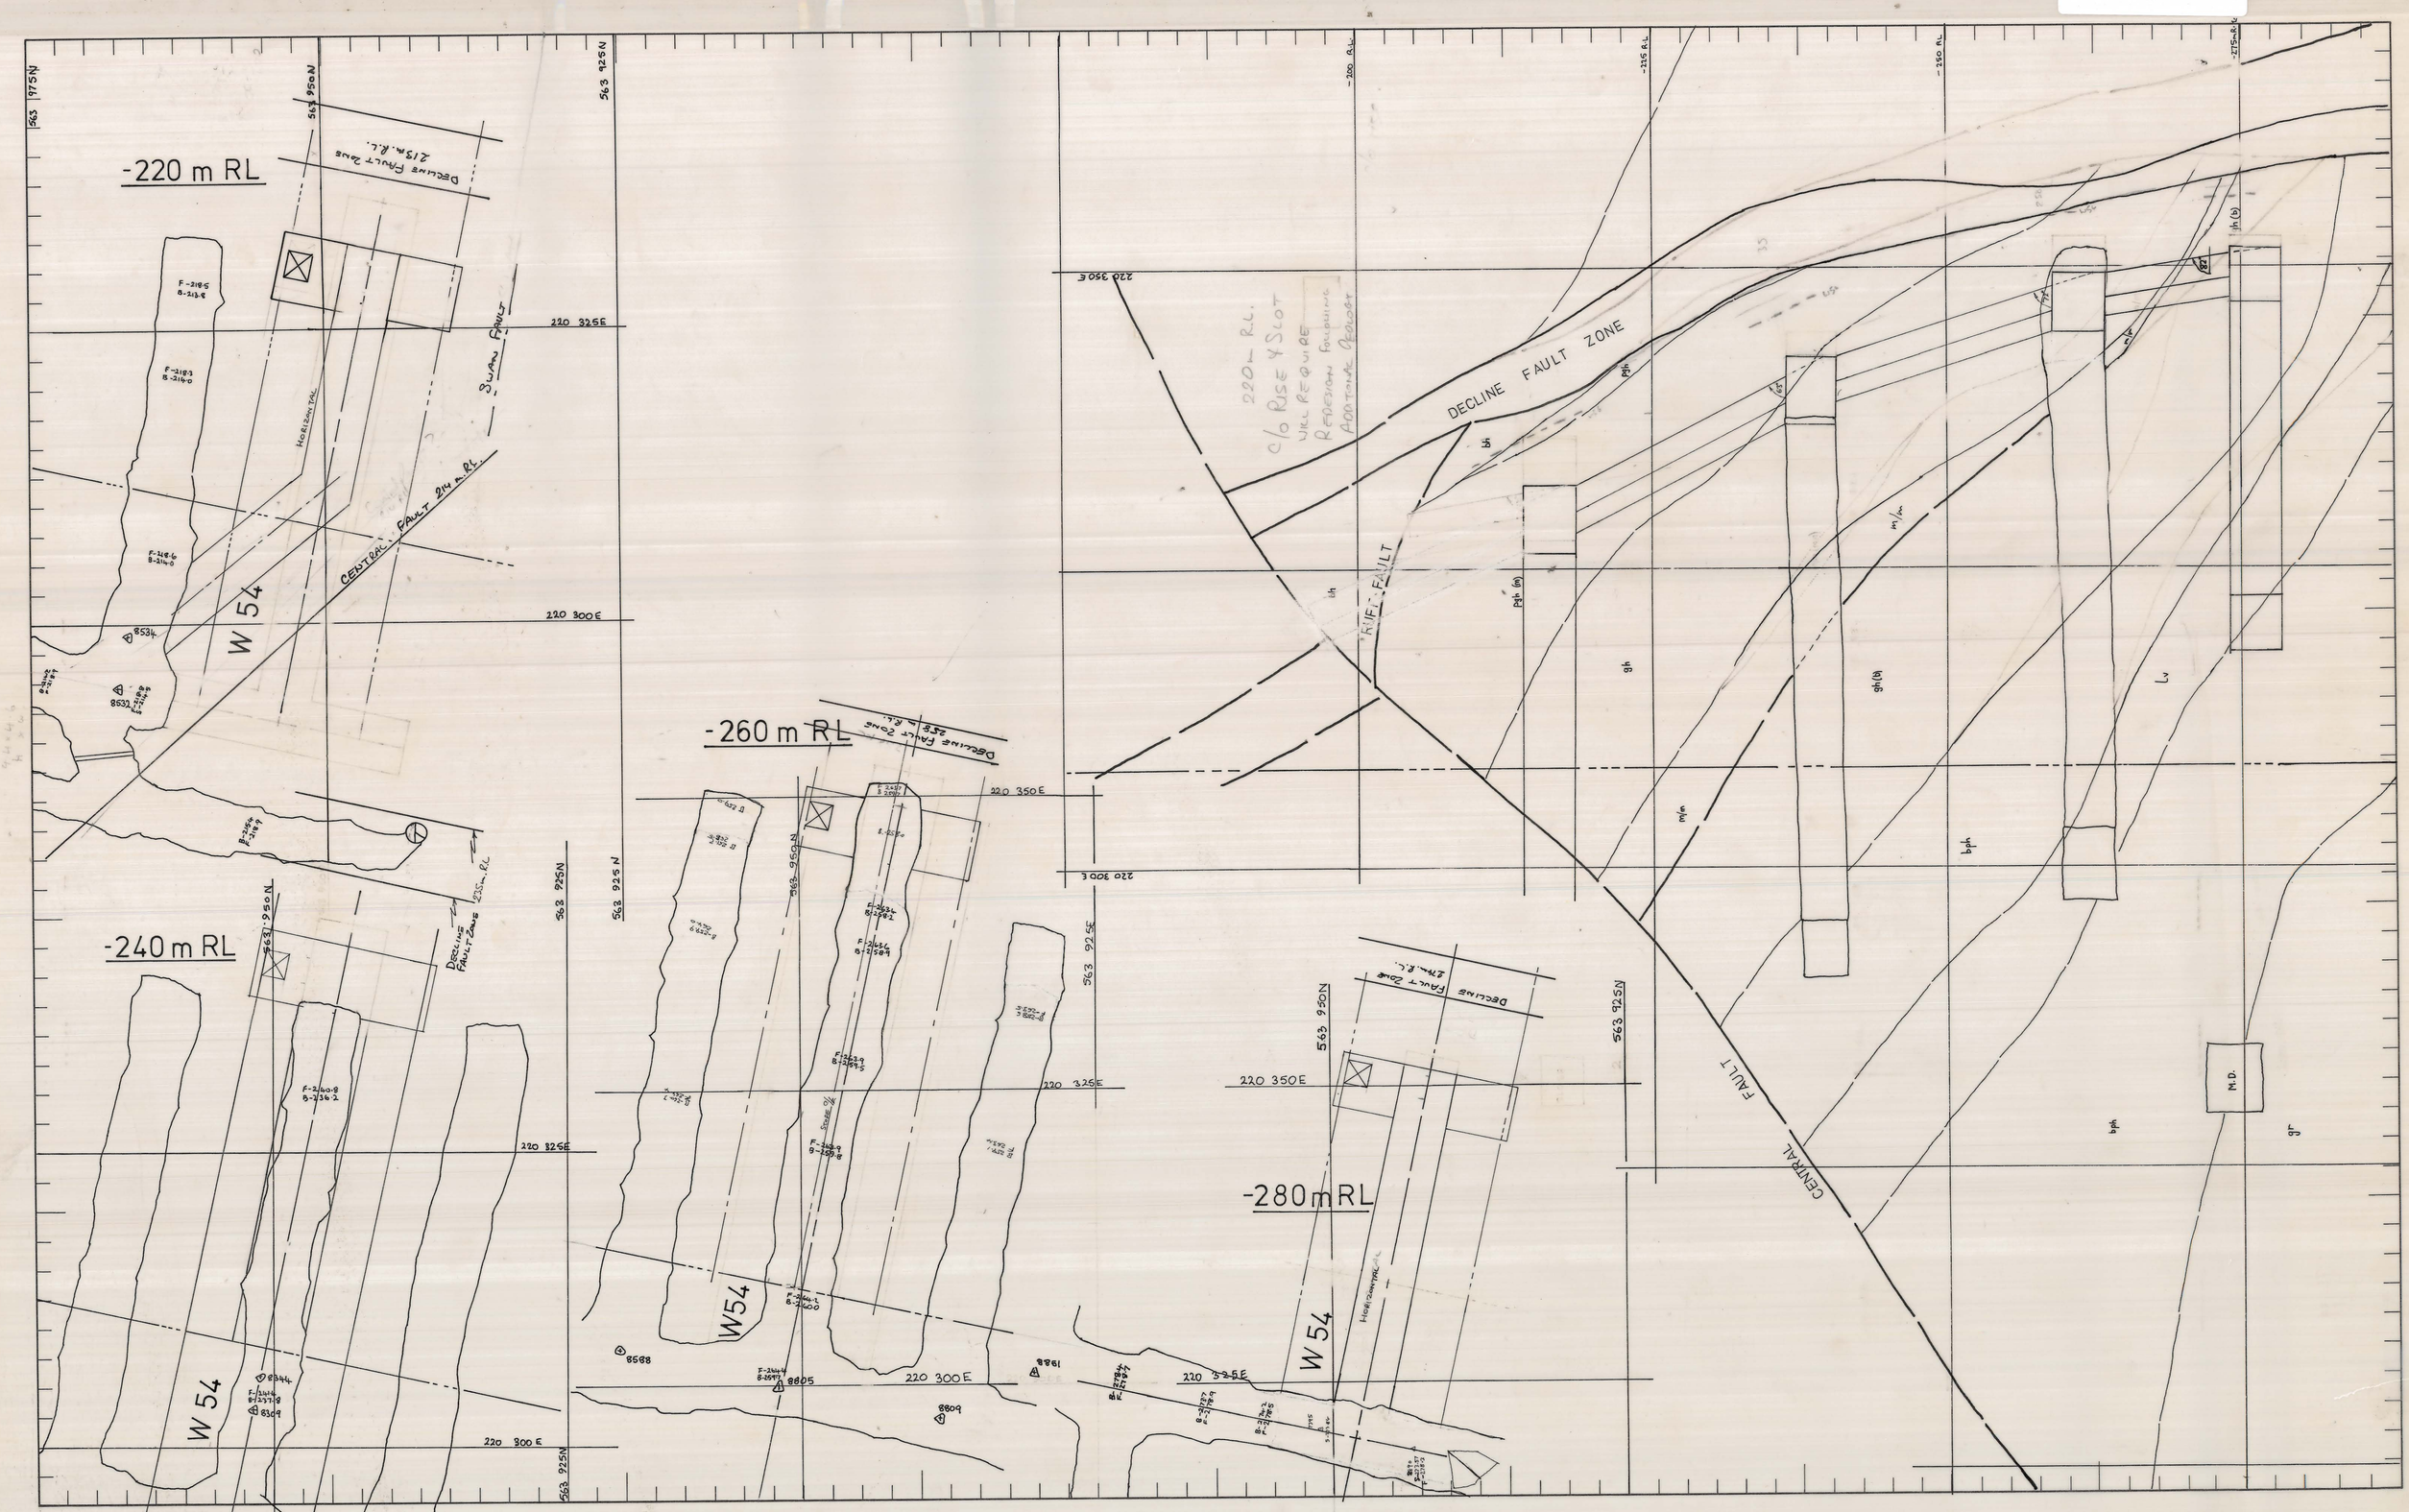

REVISIONS			
Nº	DATE		INITIALS

APPROVAL	INITIALS	DATE
PLANNING ENGINEER	W.Y.	23/9/82
SNR. PLANNING ENGINEER		
TECHNICAL SERVICES SUPT.		
GENERAL MINING SUPT.		
MINE SUPT.		
SNR. SURVEYOR		
SNR. GEOLOGIST		

SCALE 1:

LOCATION

SUBJECT

LOWER WEDGE W54

KIS KING ISLAND SCHEELITE
A Member of the Peko Wallsend Group

GRASSY — KING ISLAND

PRELIMINARY ☐ FINAL ☐

PLAN NUMBER 03Dm07-1025