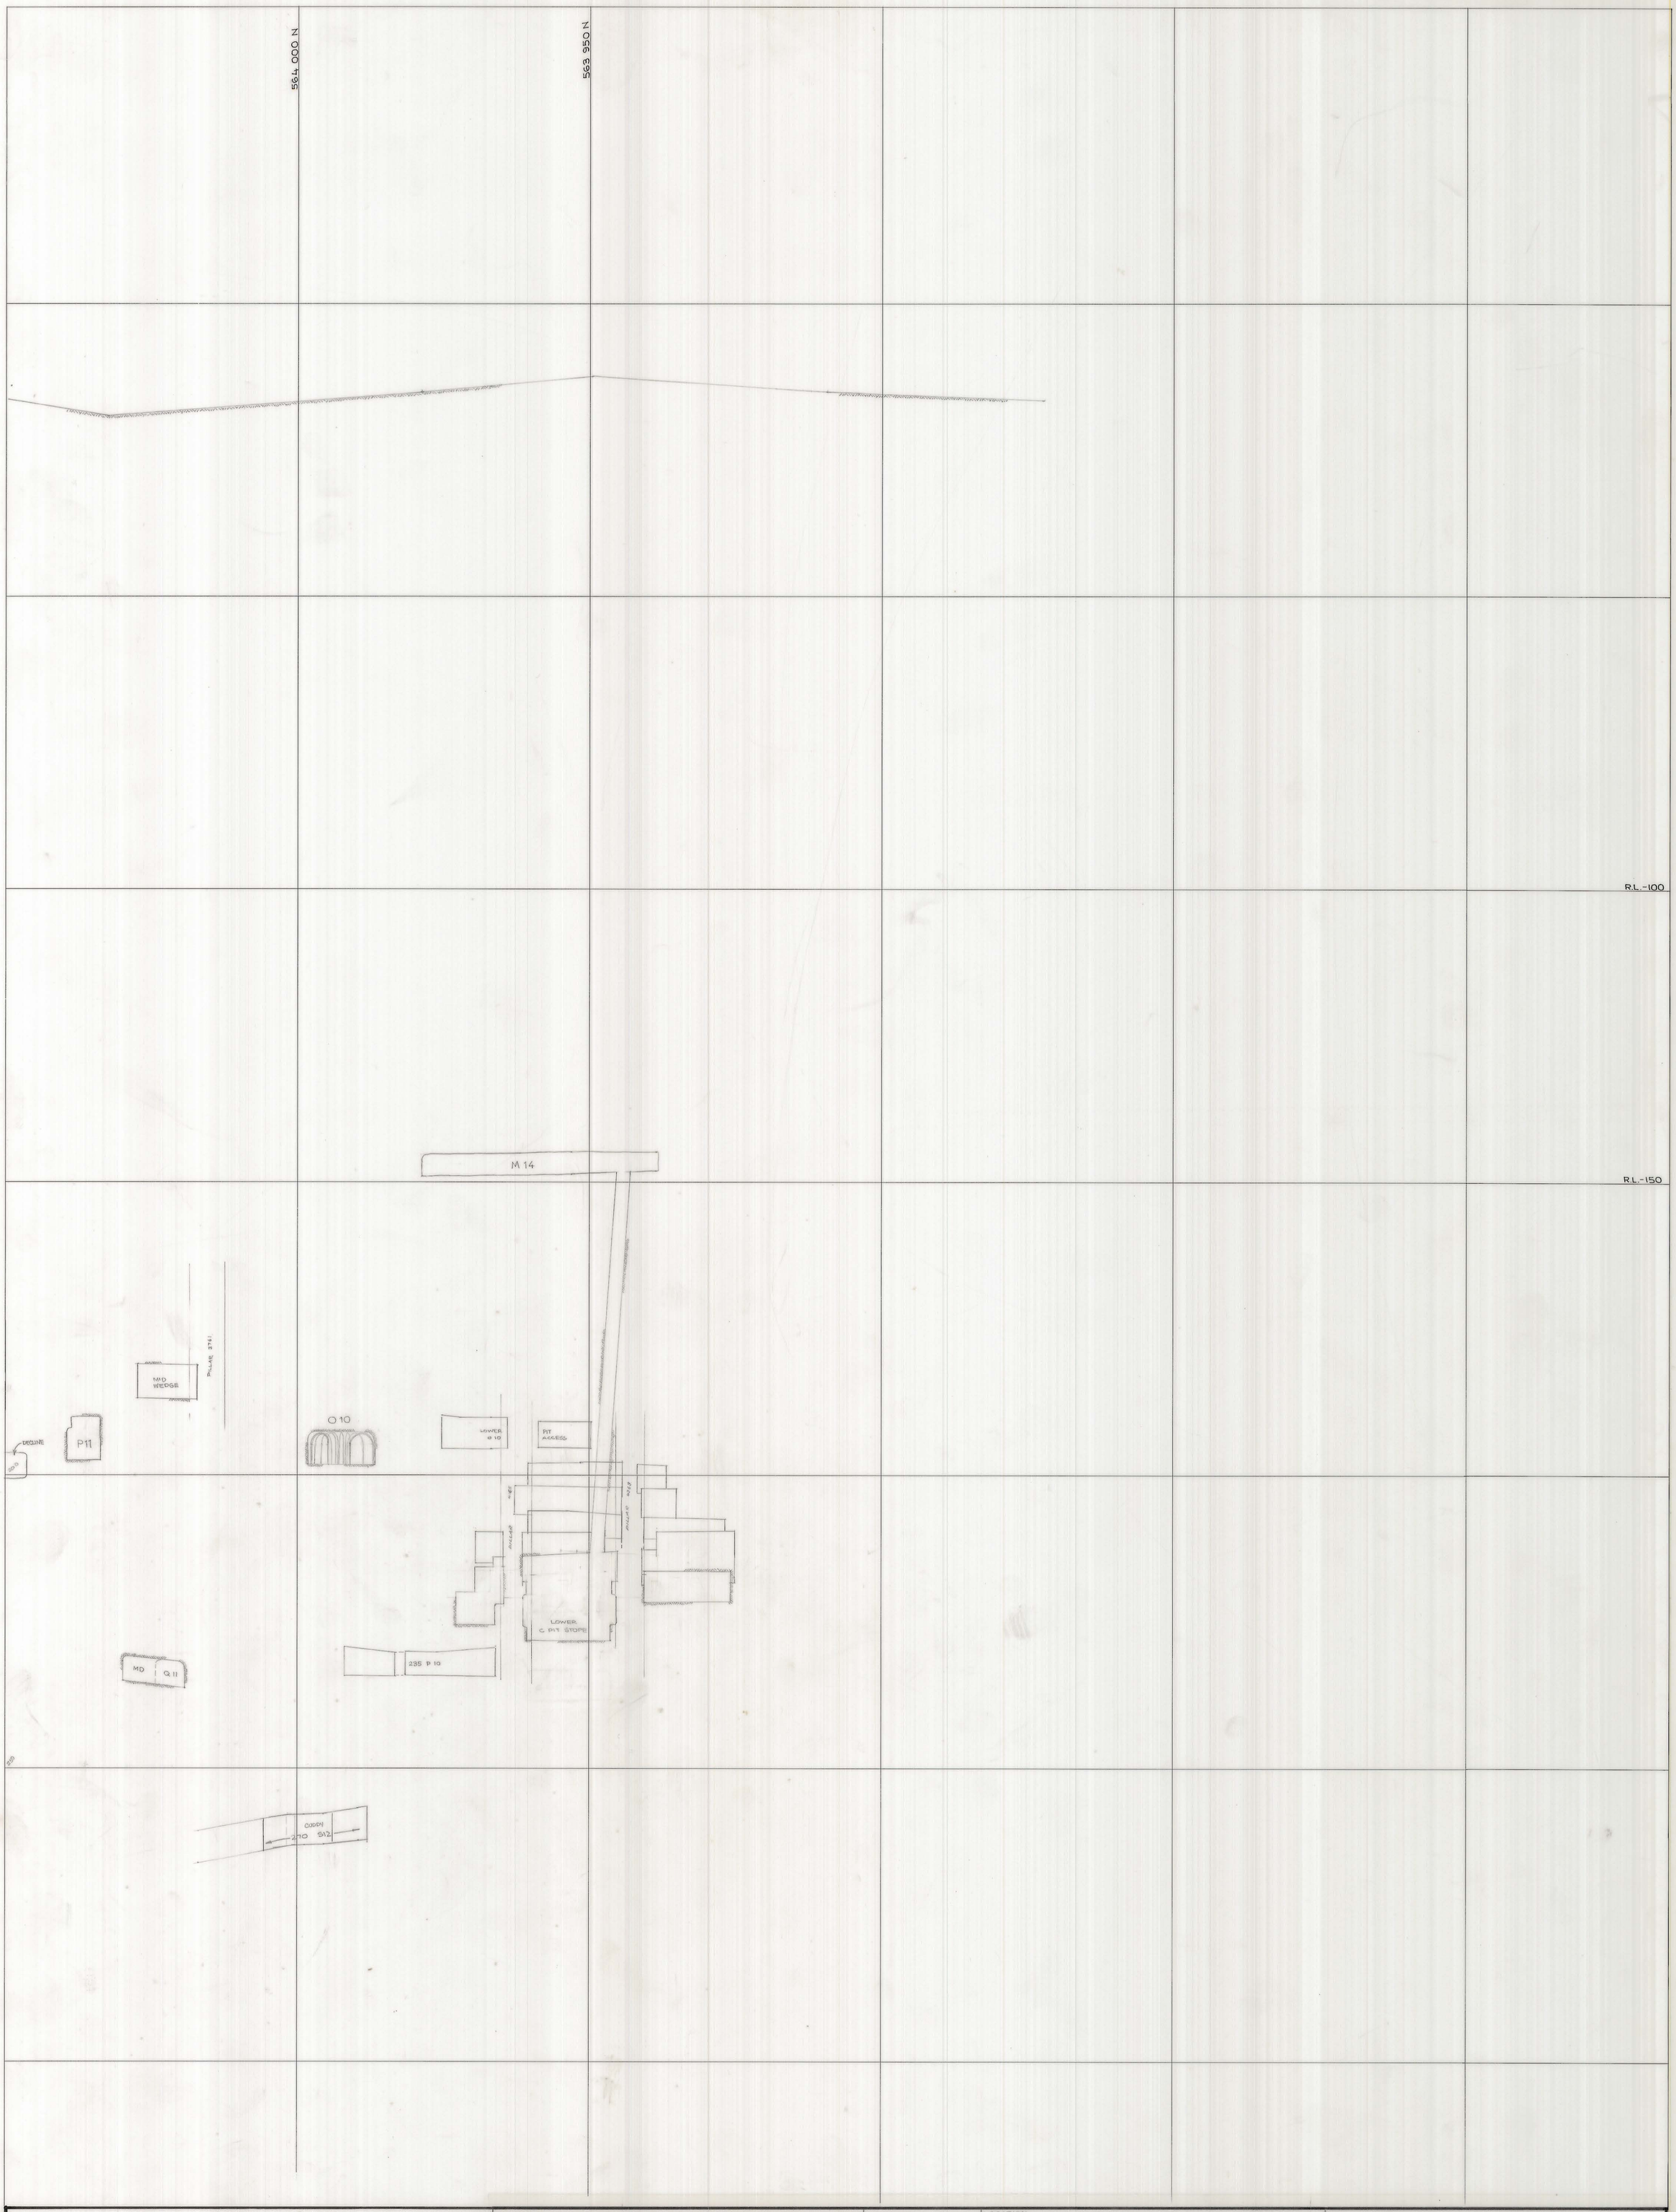

SCALE 1

north

LOCATION

SUBJECT 220 240E

KING ISLAND SCHEELITE
A DIVISION OF WARMAN INTERNATIONAL

GRASSY KING ISLAND

PLAN NUMBER

27 JUN 1981

5 cm

0374_2690