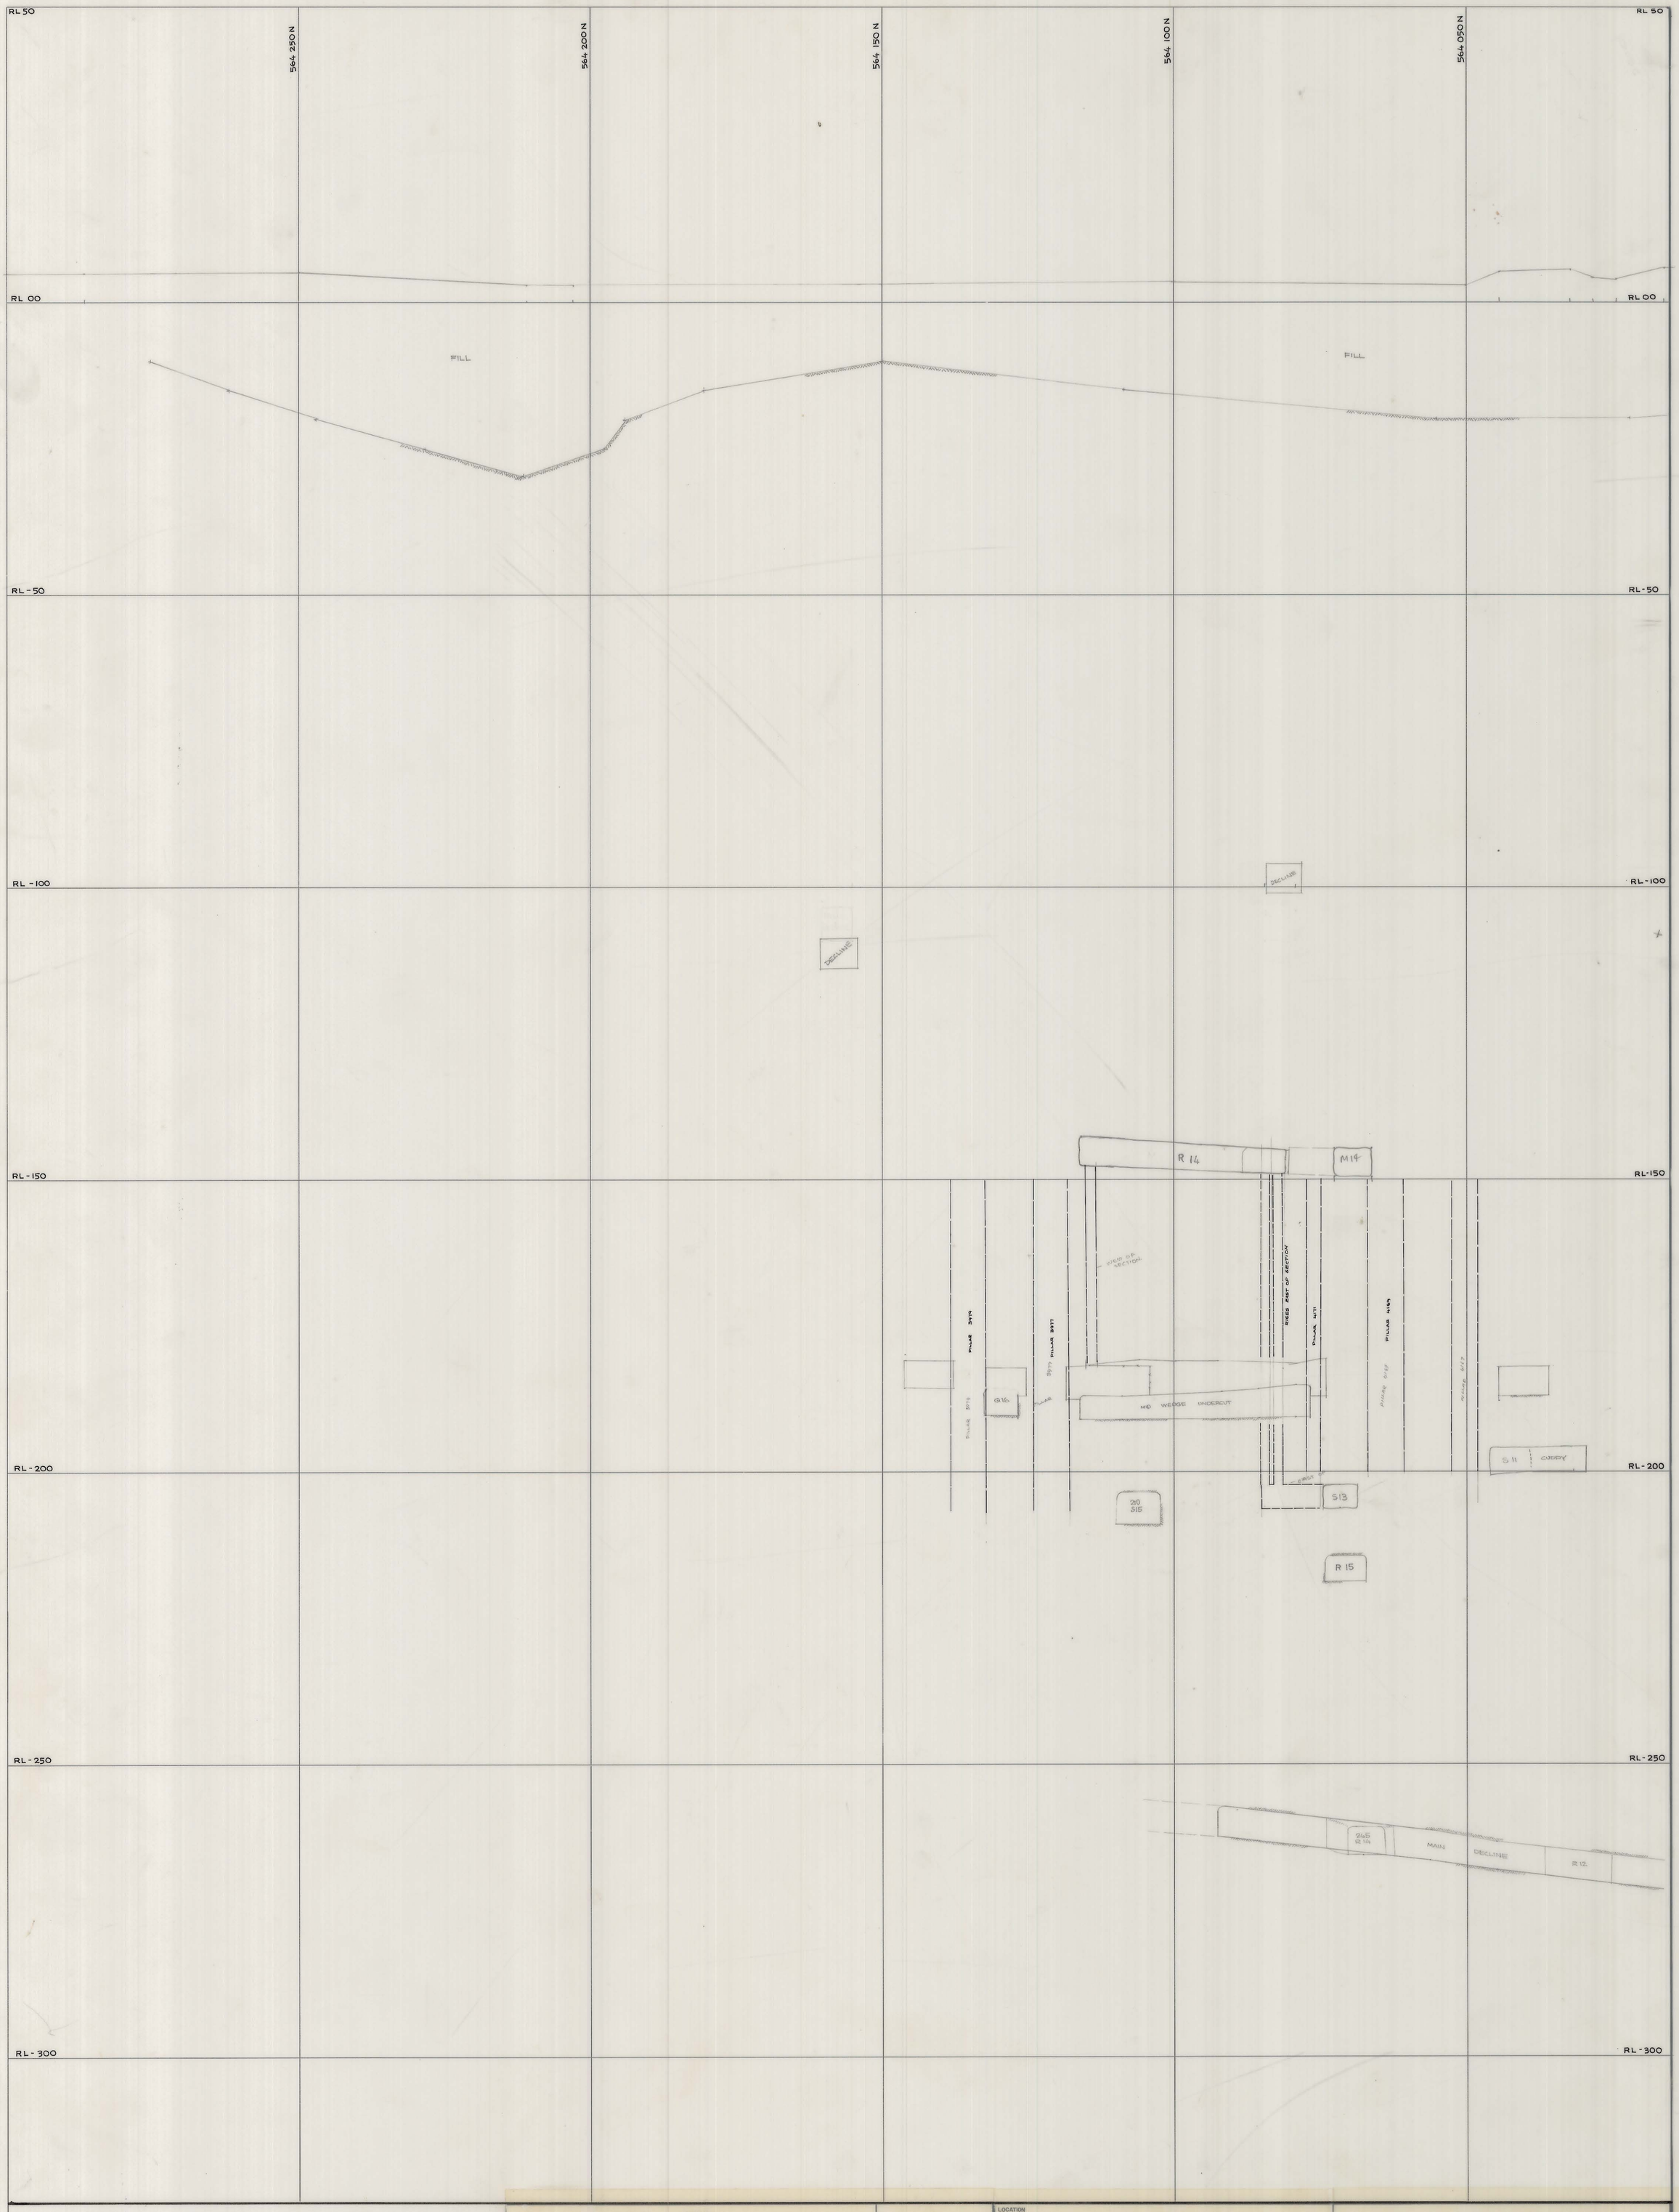

SCALE 1 : 500	looking east	LOCATION: DOLPHIN MINE SUBJECT: CROSSECTION 220 280 E	KIS KING ISLAND SCHEELITE A DIVISION OF WARMAN INTERNATIONAL GRASSY KING ISLAND PLAN NUMBER: 04DM22 - 1029

27 JUN 1981
5 cm
04DM22-1029
0374_2699