


5 cm

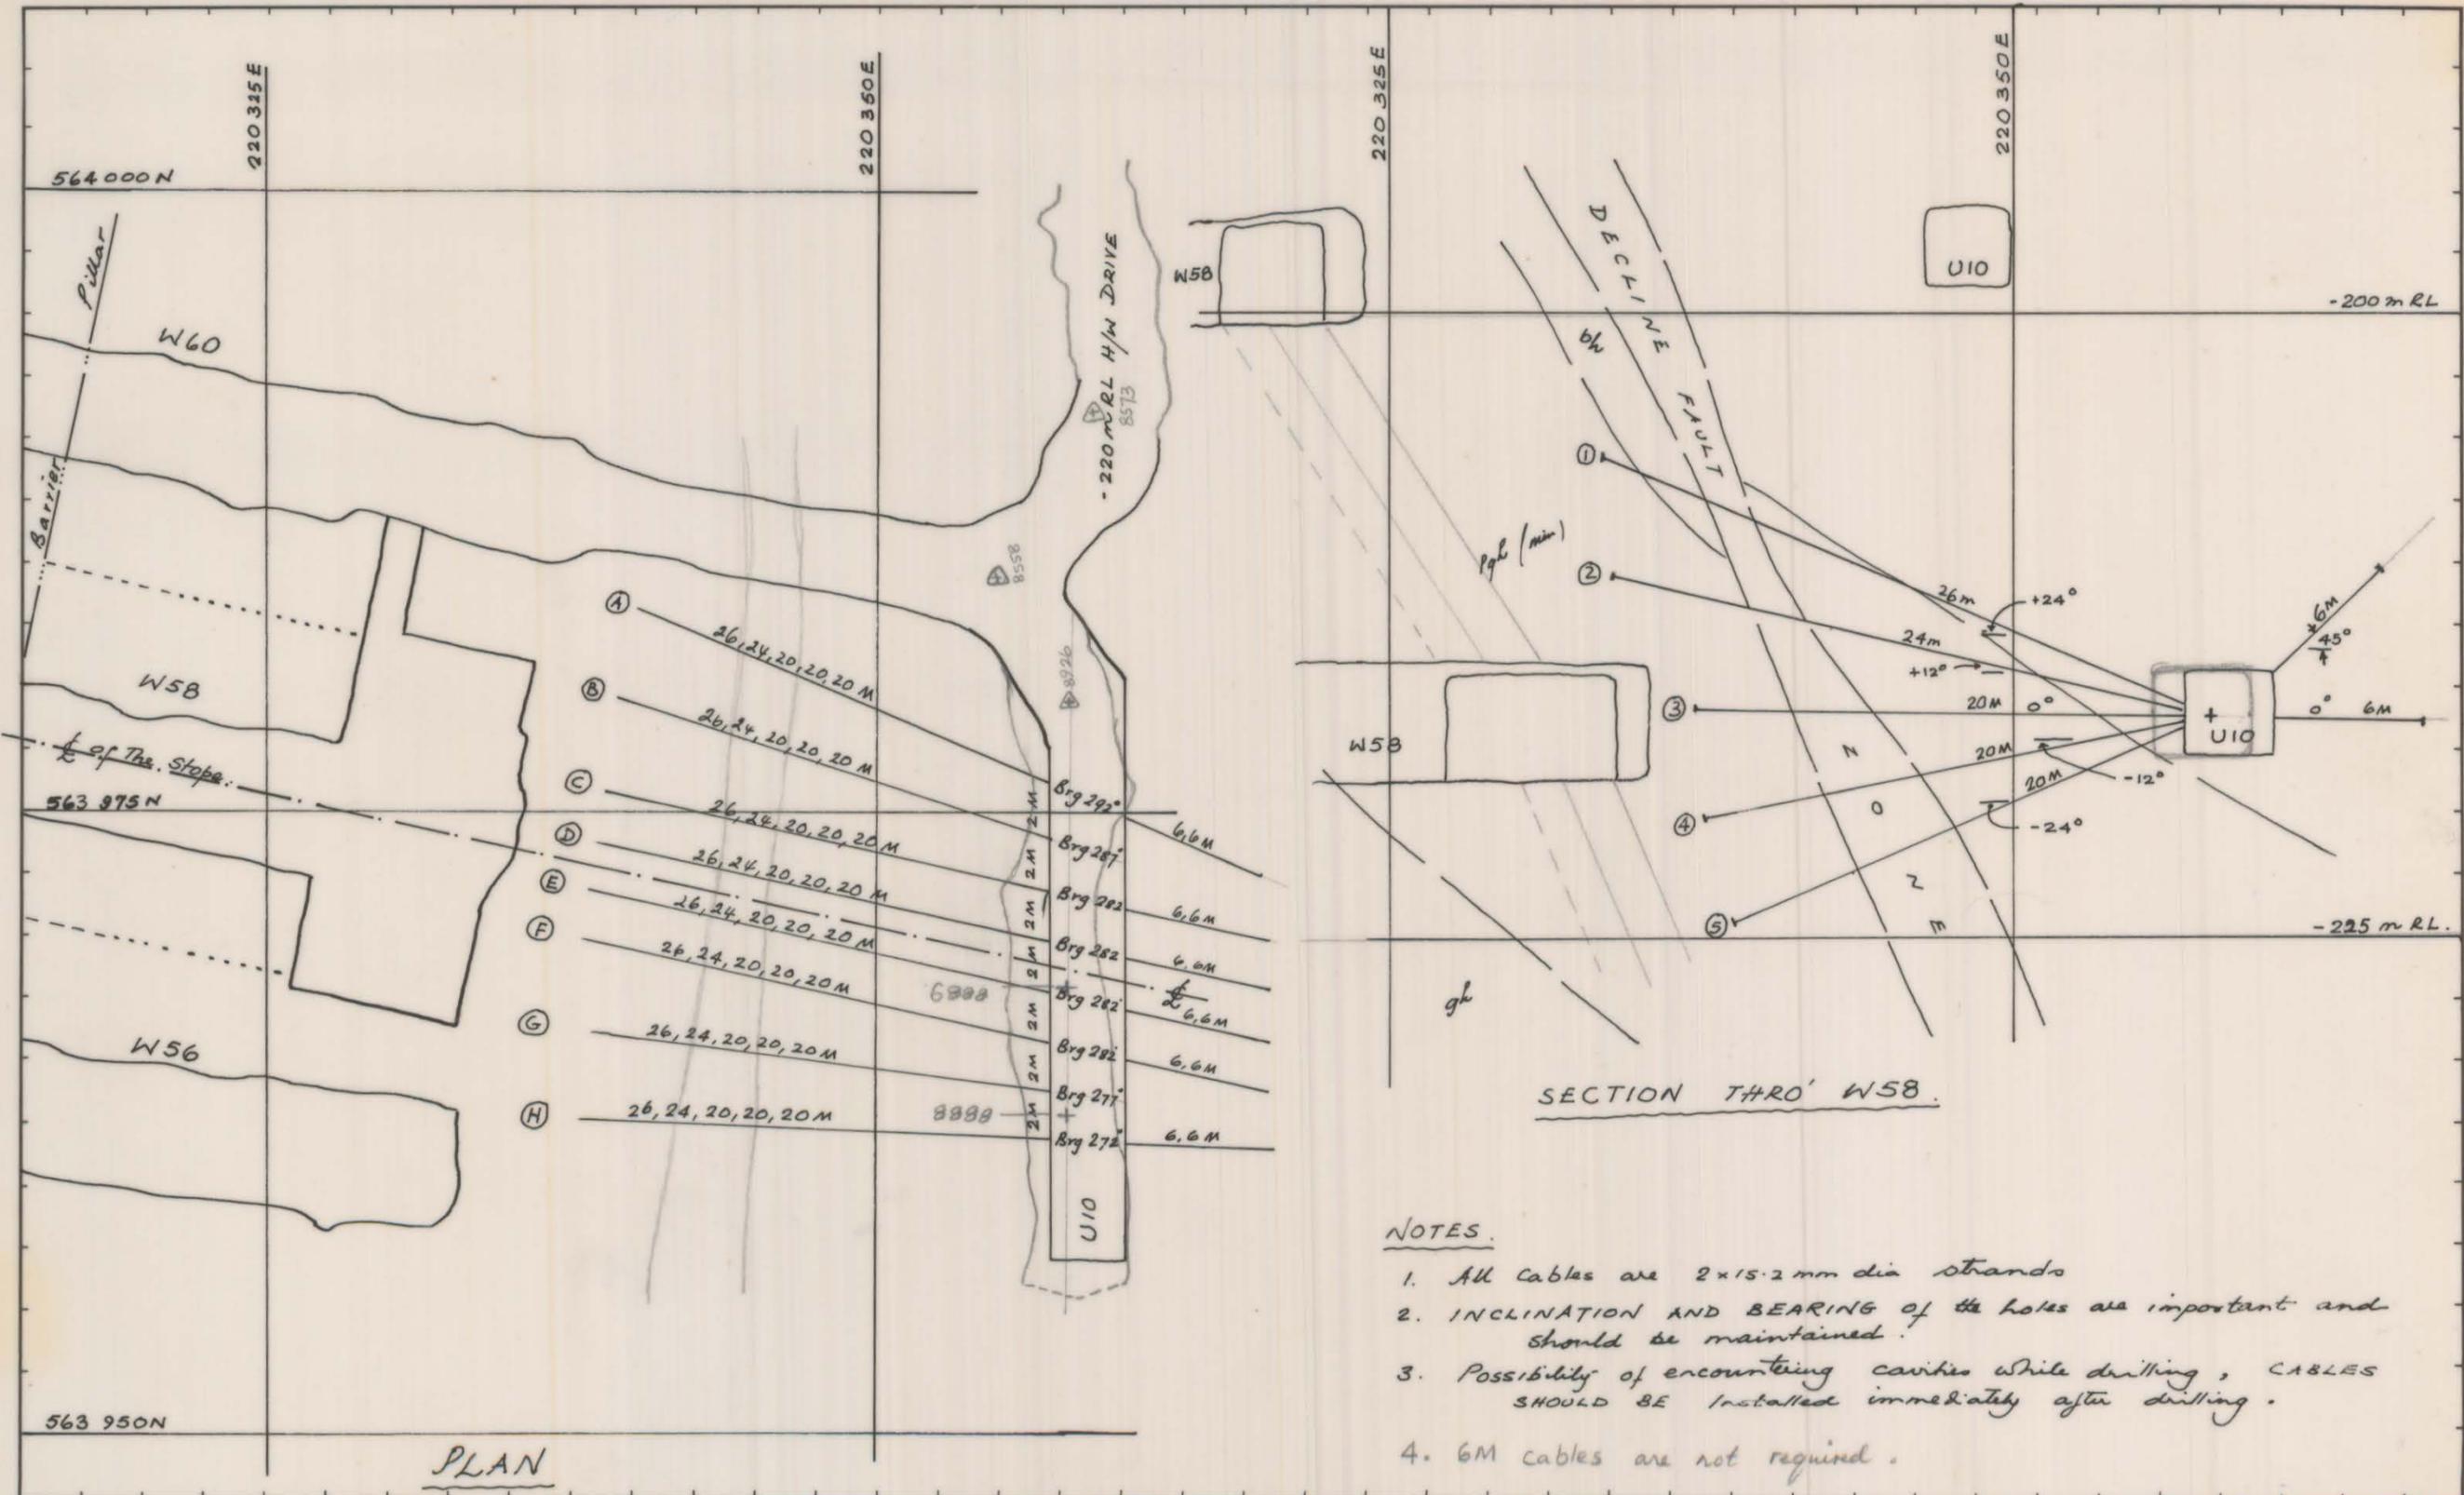

PLAN

SECTION THRO' W58.

NOTES.

1. All cables are 2x15.2 mm dia strands
2. INCLINATION AND BEARING of the holes are important and should be maintained.
3. Possibility of encountering cavities while drilling, CABLES SHOULD BE installed immediately after drilling.
4. 6M cables are not required.

Total Cable :

6M	2x6	= 72 M
20M	3x8	= 480 M
24M	8	= 192 M
26M	8	= 208 M
		<u>952 M</u> 880 M.

REF. PLAN 03 DM 06 - 1003	GEOLOGY	SCALE 1: 250	KIS KING ISLAND SCHEELITE GRASSY KING ISLAND
	SURVEY		
	PLANNING		SUPPORT SYSTEM FOR H/W DRIVE W58 SLOPE - 220m RL.
	ROCK MEC.	Jhy Jan'1982	
	GRADE CON.		
	DRAFTING		
	T.S.S.		
			DRAWING NUMBER 07 DM 09.5- 3007