5 cm
0374_2817
07DM09.5-1001

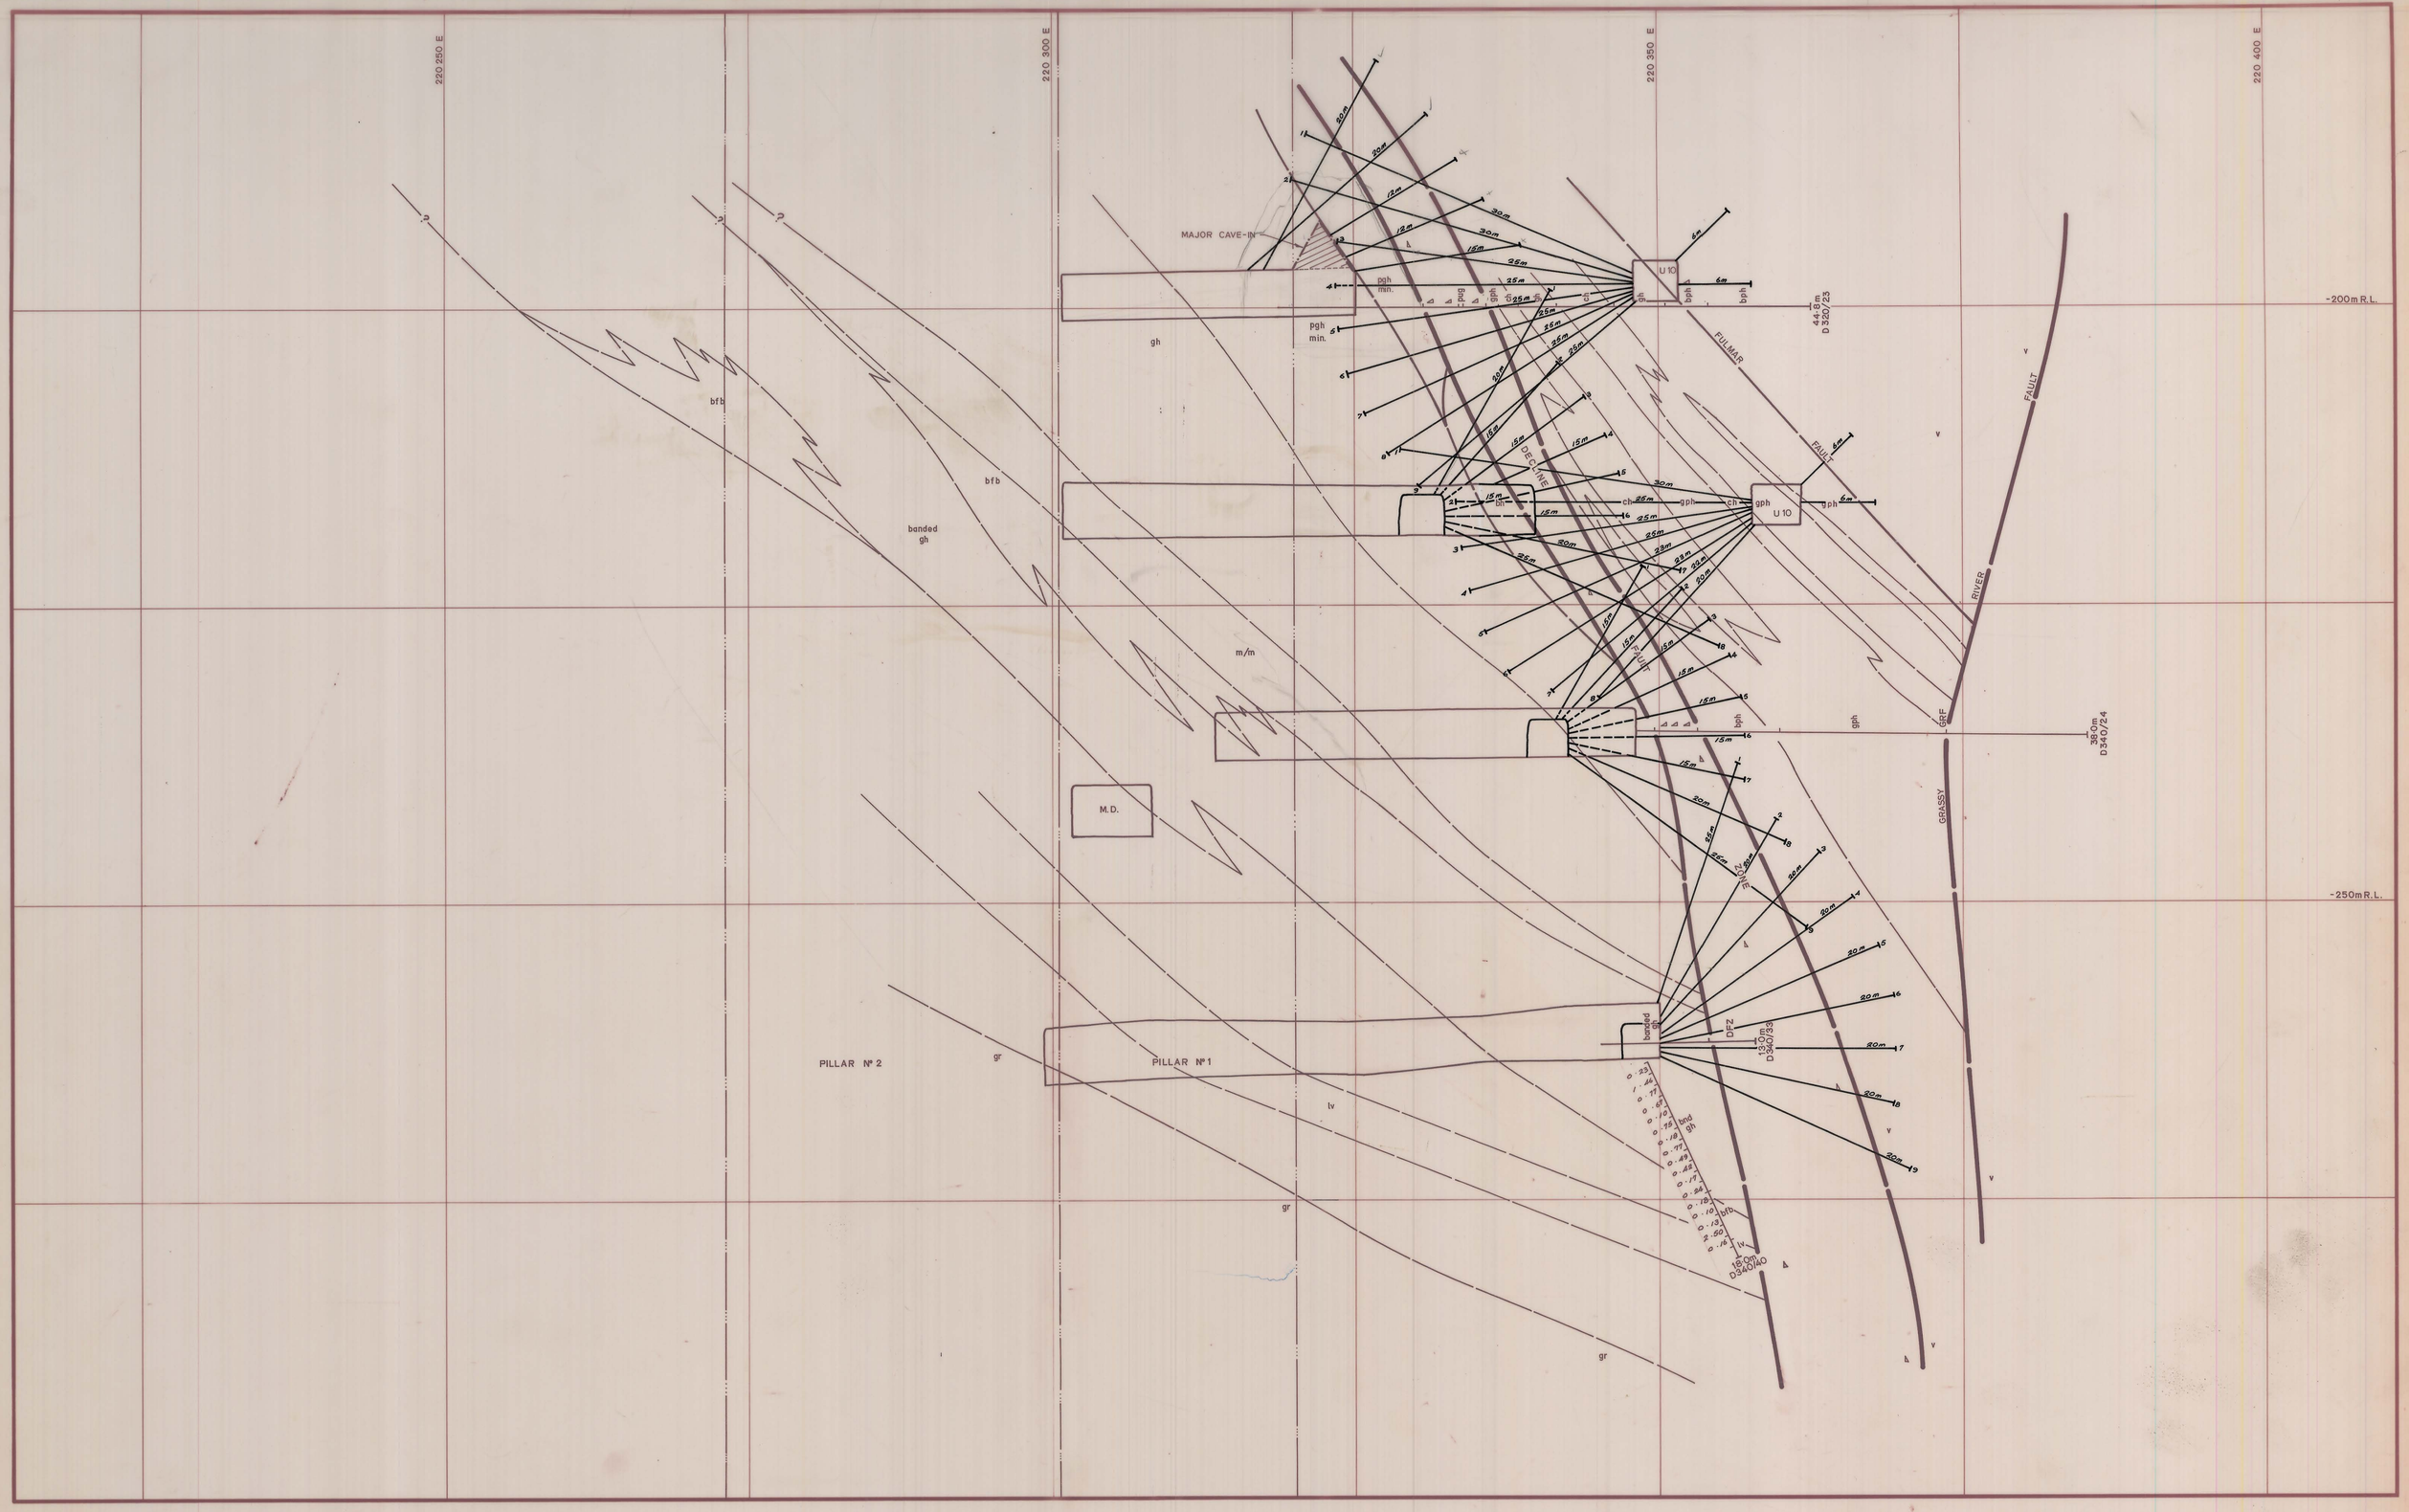

LEGEND:

v	Upper metavolcanics	bfb	Banded footwall beds
		bph	Biotite pyroxene hornfels
bh/ph	Banded hornfels	lv	Lower metavolcanics
ch	Marble	q	Quartzite
bh	Biotite hornfels		
pgh	Pyroxene garnet hornfels	ap	Aplite
gh	Garnet hornfels	gr	Granite

DENSITY.
3·5 to 6·25 M².
All cables 2/15·2 mm dia strand.

GRID BEARING 102°00'

DATE 1·8·81
DRAWN:
GEOLOGY: R. Bd D.
CHECKED:

KING ISLAND SCHEELITE

SCALE 1:250

DWG. No. KG2-05-062

DOLPHIN MINE
LOWER WEDGE AREA
W62 STOPE
CABLE BOLTING.

07 DM 09.5-1001