5 cm

0374_2820

HORIZONTAL 1:1-50
SCALE VERTICAL 1:100
TAILINGS DISPOSAL PIPELINE
1-9-51

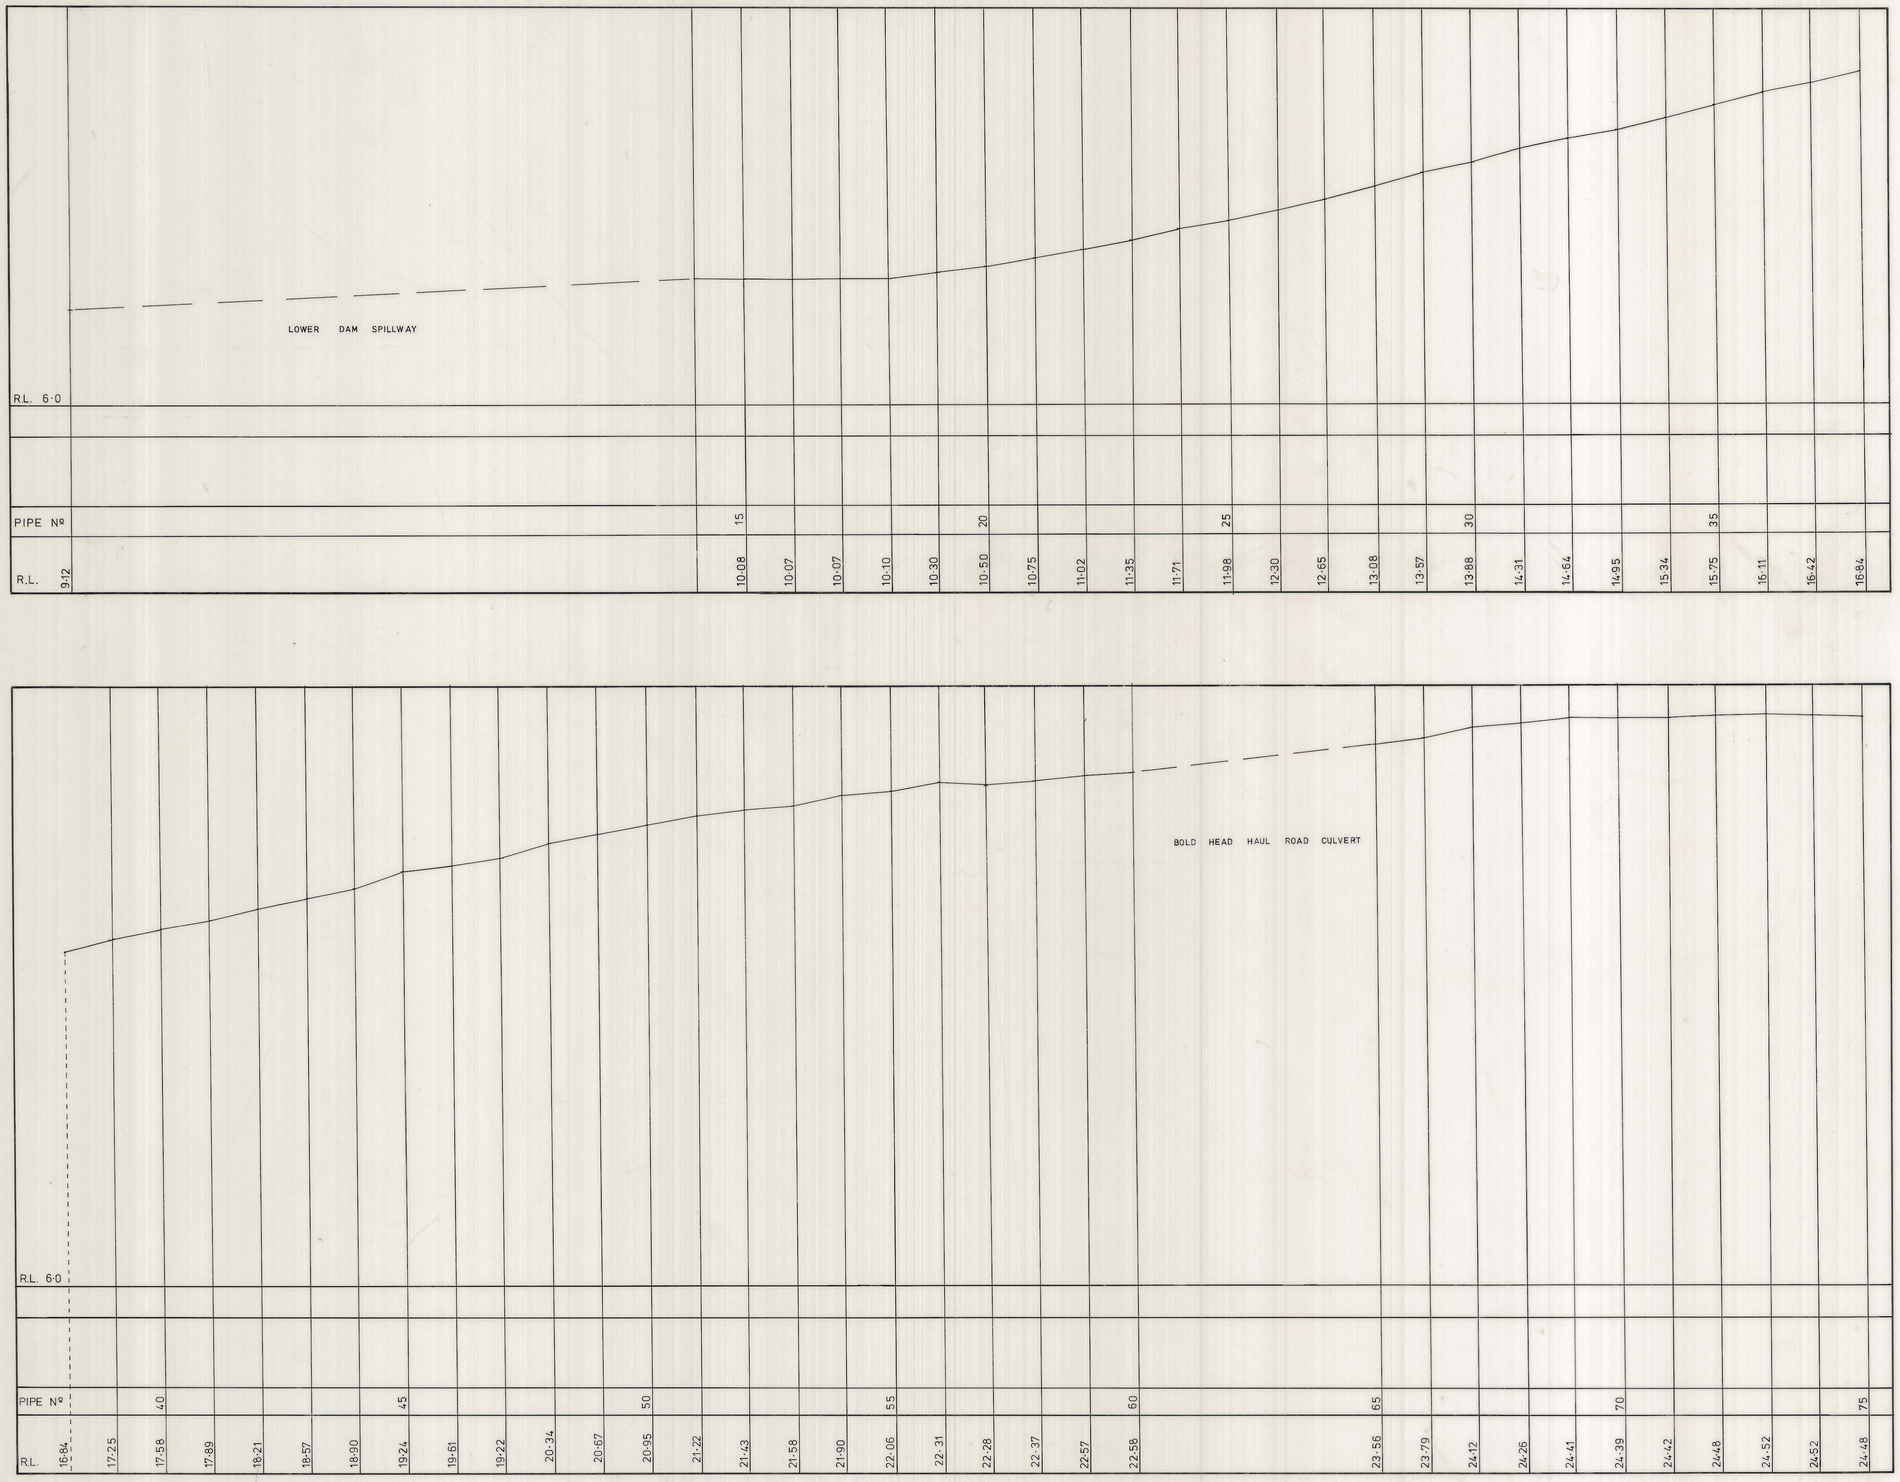

DATE 24-10-74	KING ISLAND SCHEELITE LTD.
SURVEYED M.G.M.	No 1-9-51
DRAWN M.D.B.	TAILINGS DISPOSAL PIPELINE
TRACED	VERTICAL PROFILE
CHECKED M.G.M.	SCALES HORIZONTAL 1:250 VERTICAL 1:100