


5 cm

0374_2838

RS-5 49

07 DM 02.2-1005

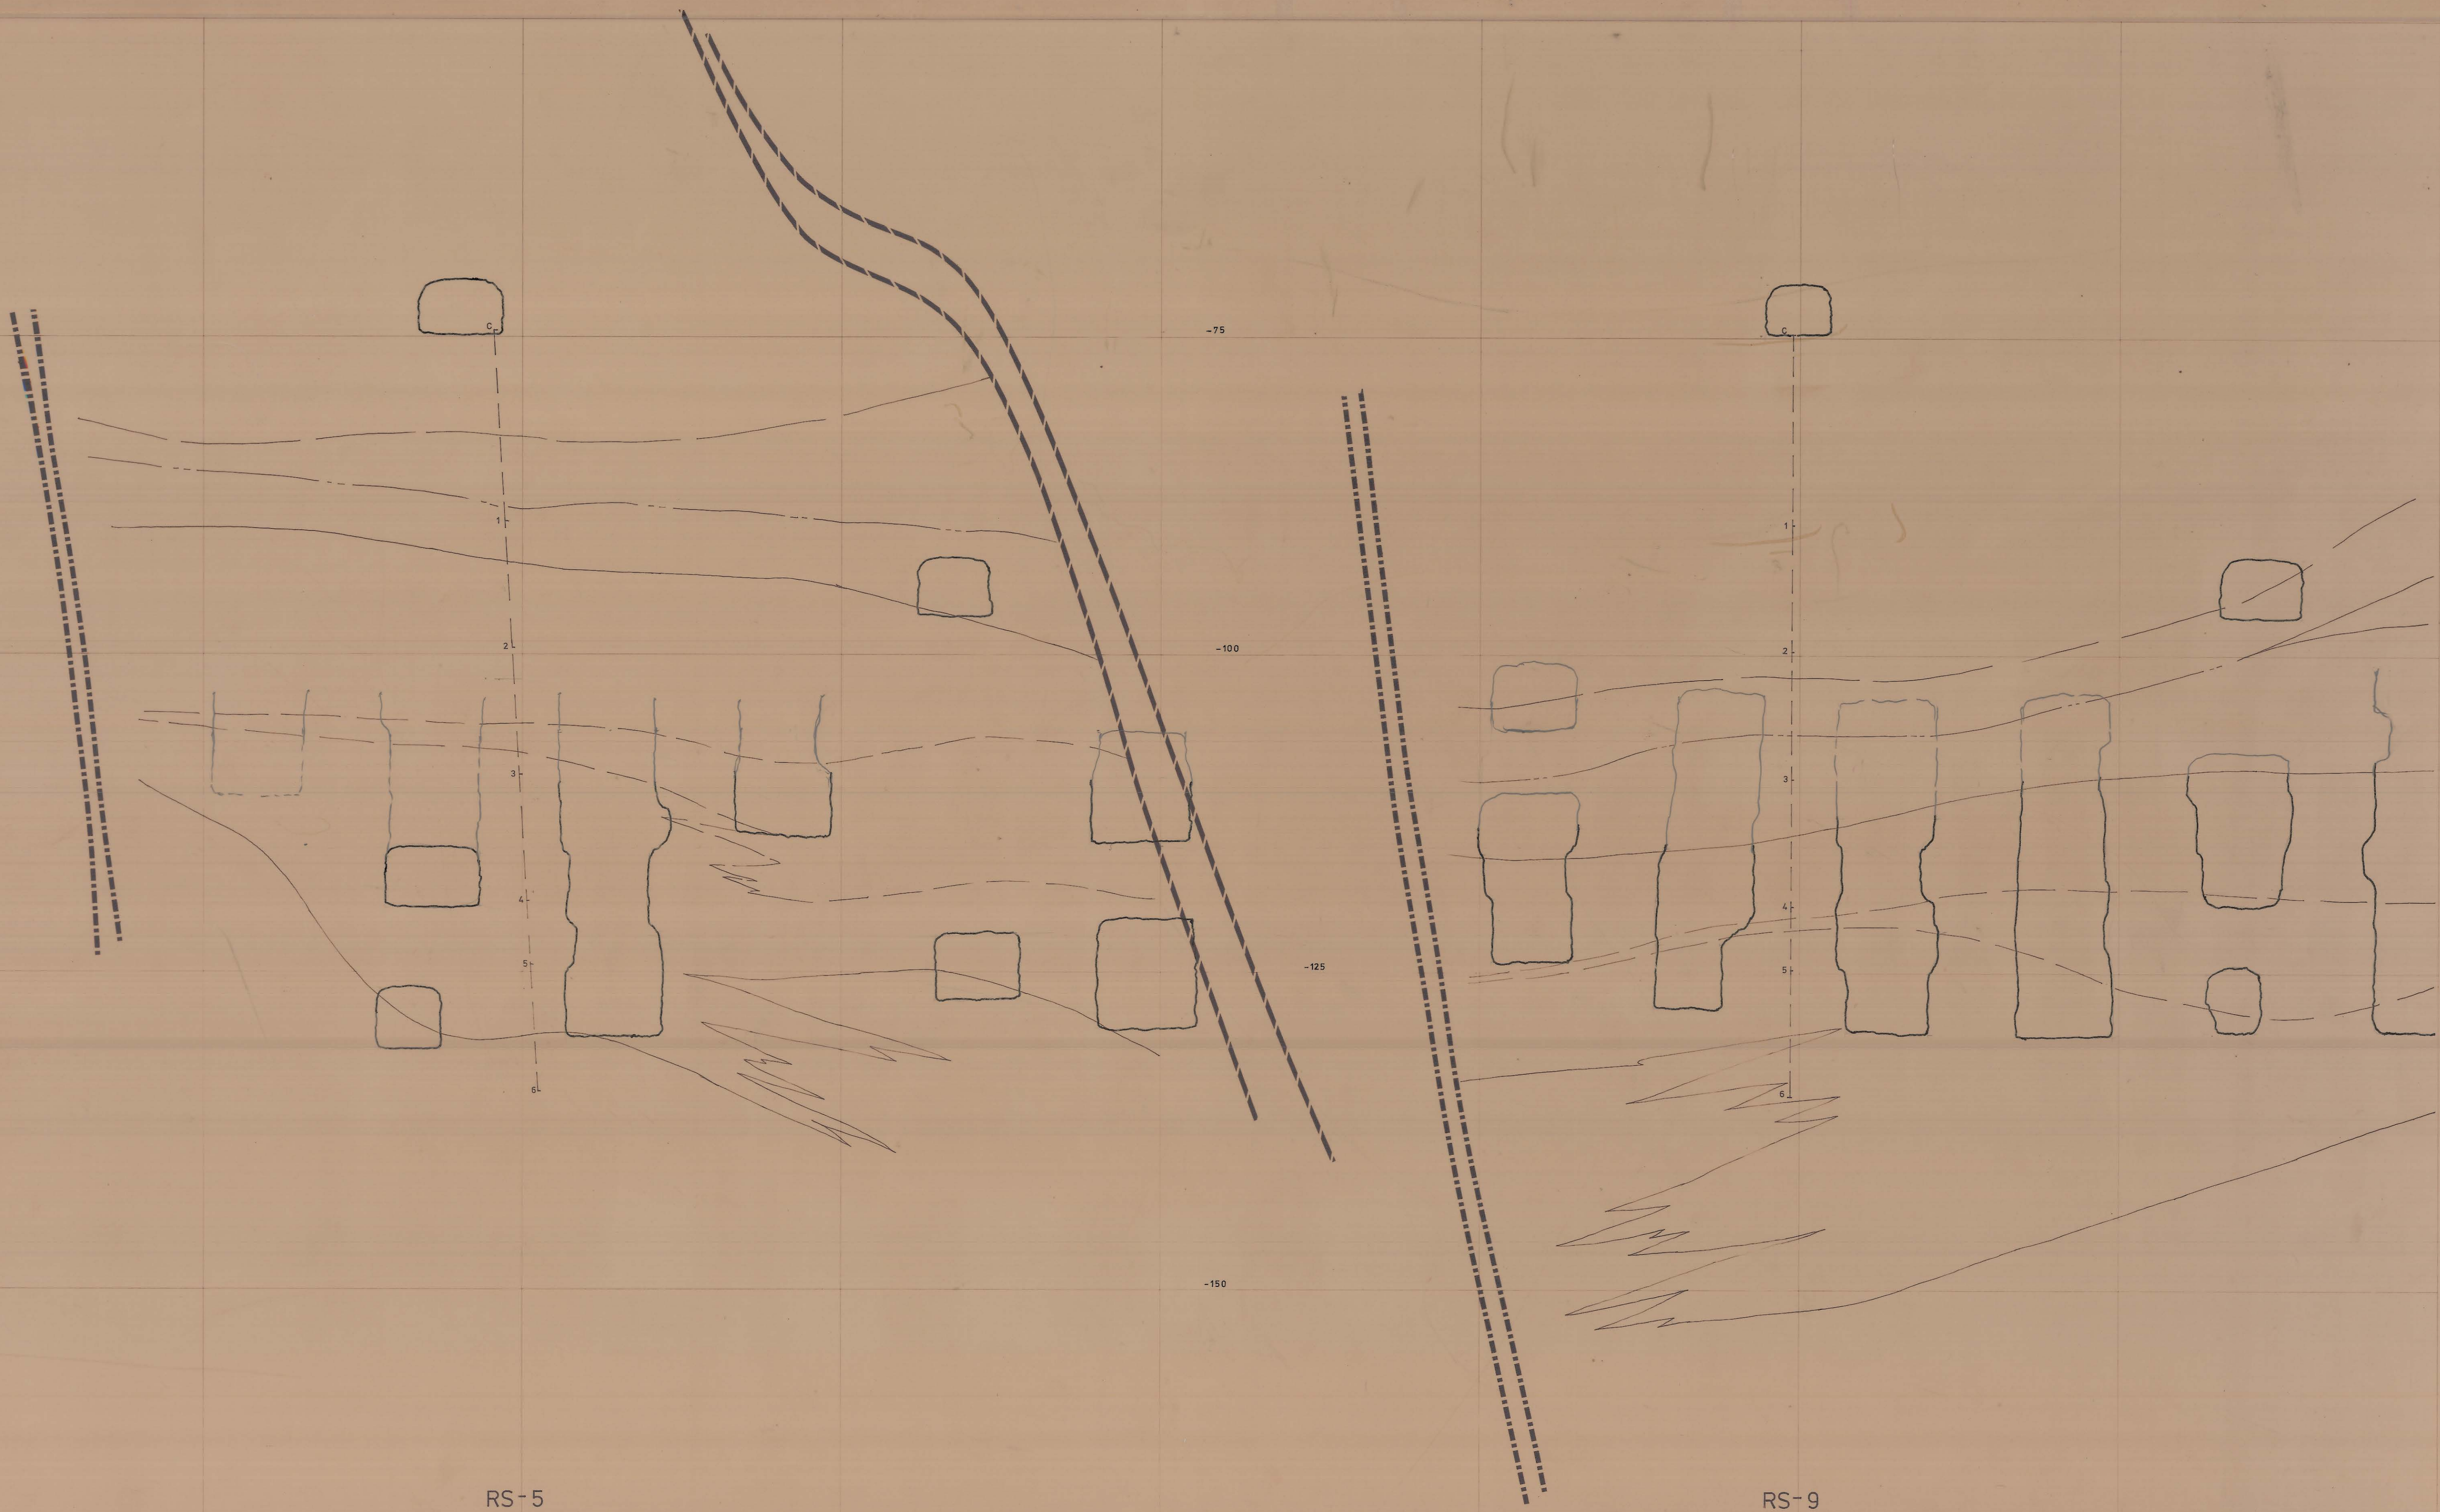

WEDGE
North BOUNDARY



SCALE 1:250

LOCATION

DOLPHIN MINE

SUBJECT

KIS KING ISLAND SCHEELITE
A DIVISION OF WARMAN INTERNATIONAL

GRASSY

KING ISLAND

PLAN NUMBER

north

07 DM 02.2-1005