0374_3018

5 cm

DEMEC GAGE

STATION № SP-5

TYPE No. 1487 Cement and Concrete Assoc.

DATE OF INSTALLATION

№ OF PINS

CALIBRATION FACTOR 1 division = 6.68 με

LOCATION DOLPHIN MINE -200

EAST

NORTH

m R.L.

DIAGRAM:

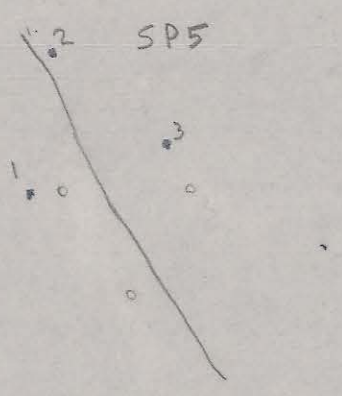

Surface pins — superseded by SP8

DATE	DAY	DISTANCE BETWEEN STAT. 1 - 2	1 - 3	3 - 2	CALIBRATION	REMARKS
11.5.1981		1036	1032	986	948	
18.5.81		1029	1034	990	949	
26.5.81		1031	1035	992	949	
28.5.81		1032	1036	993	949	
1.6.81		1025	1031	992	950	
3.6.81		1030	1031	992	950	
19.6.81		1030	1034	989	949	
1.7.81		1025	1030	989	949	
23.10.81		1018	1032	995	949	
30.10.81		1018	1032	995	949	
20.11.81		1018	1031	996	949	
30-4-82		1014	1042	998	949	
14.5.82		1013	1033	994	949	
12.7.82		1008	1032	999	948	
20.7.82		1013	1036	997	949	
23.8.82		1006	1038	997	949	
31.8.82		1007	1038	997	949	
14.9.82		1010	1039	996	949	
2.11.82		1010	1038	996	947	
4.11.82		996	984	999	946	
16.11.82		1001	1022	997	948	
22.11.82		995	1033	1002	948	
6.12.82		991	1034	1004	952	
13.12.82		1070	1043	1005	953	
8-2-83		1007 ~~984~~	~~1038~~ 1038	1005	947	
18-2-83		1006	1039	1005	944	