0374_3026

5 cm

DEMEC GAGE

STATION № SP-13

TYPE No. 2948 Cement and Concrete Assoc.

DATE OF INSTALLATION .....

№ OF PINS .....

CALIBRATION FACTOR 1 division = 6.4 με

LOCATION DOLPHIN MINE -240 W56

..... EAST

..... NORTH

..... m R.L.

DIAGRAM:

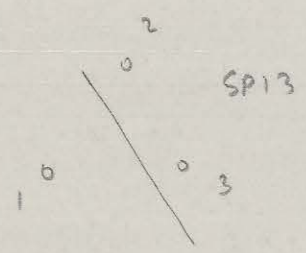

DATE	DAY	DISTANCE BETWEEN STAT. 1 - 2	1 - 3	3 - 2	CALIBRATION	REMARKS
12.7.82		635	845	1273	810	
20.7.82		620	835	1289	811	
27.7.82		623	792	1261	812	
3-8-82		634	807	1257	810	
23-8-82		636	725	1259	810	
31.8.82		647	722	1258	808	
14.9.82		647	721	1258	809	
9-11.82		641	811	1266	811	
16-11.82		651	782	1271	810	
22.11.82		646	780	1265	810	
6.12.82		648	781	1281	820	
13.12.82		652	790	1285	820	
8-2-83.		655	779	1326.	815.	
15-2-83		710	810	1293	812.	

DATE	DAY	DISTANCE BETWEEN STAT. 1 - 2	1 - 3	3 - 2	CALIBRATION	REMARKS