


LOWER PIT
FILL INSTRUMENT

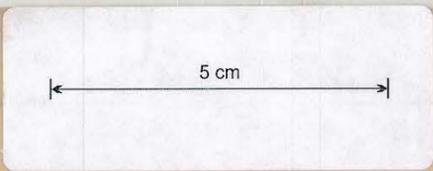


0374_3034

NUMBER 1 (LOWER PIT)

INSTALLATION DETAILS

Female side of Black Box

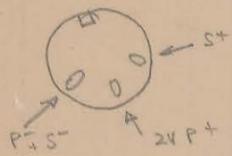

PILLAR S 3961
LIFT 2nd
R.L. -219.69
BEARING 315°
DATE 10.6.1980


CALIBRATION 20.8 mm/Volt

ROD LENGTHS

NUMBER LENGTH

NOTE: New base from 27.11.80 is due to voltage divider being read on opposite side to that previously read.

TRANSVERSE MONITORING UNIT

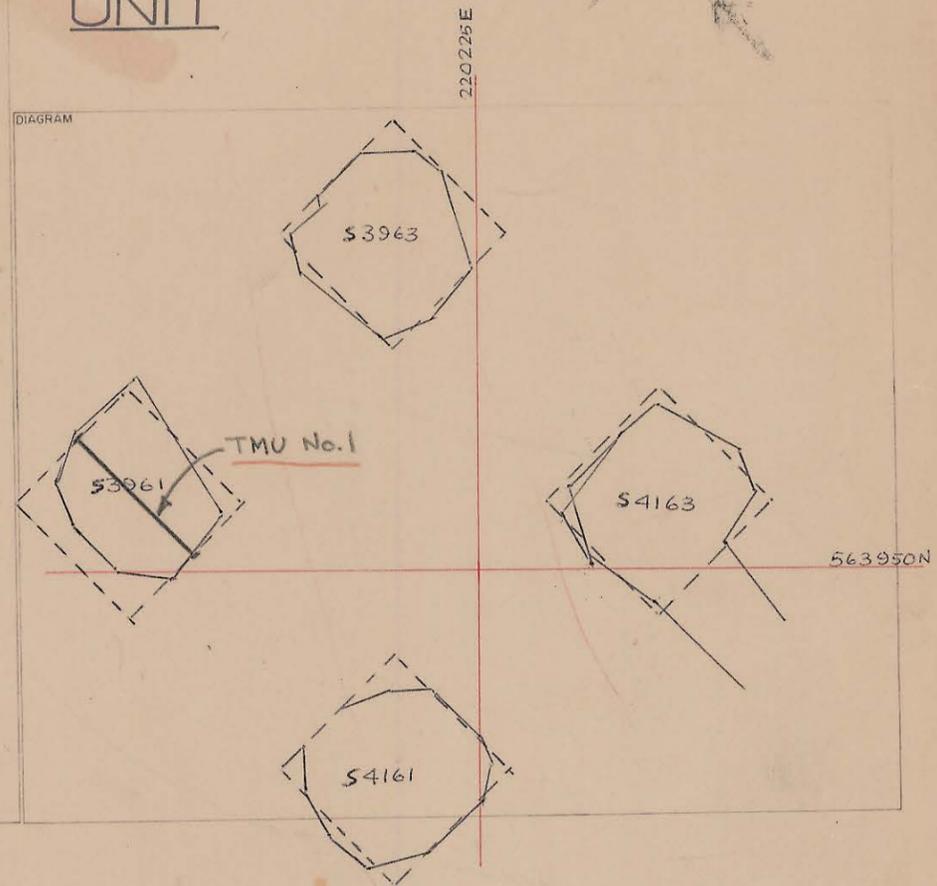

READINGS

DATE	ROD			DATE	ROD			DATE	ROD			
	V	ΔV	Δmm		V	ΔV	Δmm		V	ΔV	Δmm	
15.7.80	1.828	?		5.9.80	1.302	-0.061	-1.27	22.10.80	15:45	1.293	-0.070	-1.46
15.7.80	1.833	?		8.9.80	1.302	-0.061	-1.27	23.10.80	15:15	1.292	-0.071	-1.48
16.7.80	1.363	0		9.9.80	1.302	-0.061	-1.27	24.10.80	15:30	1.292	-0.071	-1.48
17.7.80	1.364	+0.001	+0.02	10.9.80	1.302	-0.061	-1.27	27.10.80	15:30	1.291	-0.072	-1.50
18.7.80	1.364	0	+0.02	11.9.80	1.302	-0.061	-1.27	28.10.80	09:00	1.291	-0.072	-1.50
21.7.80	1.346	-0.017	-0.35	12.9.80	1.301	-0.062	-1.29	29.10.80	13:45	1.290	-0.073	-1.52
22.7.80	1.342	-0.021	-0.44	15.9.80	1.301	-0.062	-1.29	30.10.80	13:00	1.288	-0.075	-1.56
23.7.80	1.328	-0.035	-0.73	16.9.80	1.300	-0.063	-1.31	31.10.80	10:00	1.287	-0.076	-1.58
24.7.80	1.328	-0.035	-0.73	17.9.80	1.300	-0.063	-1.31	4.11.80	13:05	1.287	-0.076	-1.58
25.7.80	1.325	-0.038	-0.79	18.9.80	1.299	-0.064	-1.33	6.11.80	10:15	1.286	-0.077	-1.60
28.7.80	1.324	-0.039	-0.81	19.9.80	1.299	-0.064	-1.33	10.11.80	9:30	1.283	-0.080	-1.66
29.7.80	1.324	-0.039	-0.81	22.9.80	1.297	-0.066	-1.37	12.11.80	07:45	1.283	-0.080	-1.66
4.8.80	1.315	-0.048	-1.00	23.9.80	1.296	-0.067	-1.39	13.11.80	11:00	1.284	-0.081	-1.69
5.8.80	1.315	-0.048	-1.00	24.9.80	1.295	-0.068	-1.41	19.11.80	10:30	1.280	-0.083	-1.73
6.8.80	1.315	-0.048	-1.00	25.9.80	1.295	-0.068	-1.41	25.11.80	09:00	1.275	-0.088	-1.83
11.8.80	1.311	-0.052	-1.08	26.9.80	1.299	-0.064	-1.33	27.11.80	08:45	0.710	-0.093	-1.93
12.8.80	1.312	-0.051	-1.06	29.9.80	1.294	-0.069	-1.44	28.11.80	14:00	0.709	-0.092	-1.91
13.8.80	1.311	-0.052	-1.08	30.9.80	1.293	-0.070	-1.46	1.12.80	10:15	0.710	-0.093	-1.93
14.8.80	1.311	-0.052	-1.08	1.10.80	1.293	-0.070	-1.46	3.12.80	08:45	0.710	-0.093	-1.93
15.8.80	1.310	-0.053	-1.10	2.10.80	1.294	-0.069	-1.44	4.12.80	09:00	0.710	-0.093	-1.93
18.8.80	1.309	-0.054	-1.12	3.10.80	1.293	-0.070	-1.46	9.12.80	10:00	0.710	-0.093	-1.93
19.8.80	1.308	-0.055	-1.14	6.10.80	1.308	-0.055	-1.14	16.12.80	09:30	0.735	-0.118	-2.45
20.8.80	1.308	-0.055	-1.14	7.10.80	1.303	-0.060	-1.25	17.12.80	08:15	0.736	-0.119	-2.48
21.8.80	1.308	-0.055	-1.14	8.10.80	1.300	-0.063	-1.31	18.12.80	08:45	0.737	-0.120	-2.50
22.8.80	1.307	-0.056	-1.16	9.10.80	1.300	-0.063	-1.31	22.12.80	11:00	0.737	-0.120	-2.50
25.8.80	1.307	-0.056	-1.16	10.10.80	1.297	-0.066	-1.37	24.12.80	10:00	0.737	-0.120	-2.50
26.8.80	1.307	-0.056	-1.16	13.10.80	1.297	-0.066	-1.37	29.12.80	10:50	0.737	-0.120	-2.50
27.8.80	1.306	-0.057	-1.19	15.10.80	1.296	-0.067	-1.39	2.1.81	13:30	0.737	-0.120	-2.50
28.8.80	1.306	-0.057	-1.19	16.10.80	1.295	-0.068	-1.41	6.1.81	08:45	0.737	-0.120	-2.50
29.8.80	1.305	-0.058	-1.21	17.10.80	1.294	-0.069	-1.44	9.1.81	08:15	0.737	-0.120	-2.50
1.9.80	1.303	-0.060	-1.25	20.10.80	1.294	-0.069	-1.44	12.1.81	09:15	0.737	-0.120	-2.50
3.9.80	1.302	-0.061	-1.27	21.10.80	1.292	-0.071	-1.48	14.1.81	10:15	0.737	-0.120	-2.50
4.9.80	1.302	-0.061	-1.27									

New Term Point