0374_3043

5 cm

NUMBER 2 (38) (LOWER PIT)

INSTALLATION DETAILS:

PILLAR S4161

LIFT 2nd

R.L. -219.47

BEARING 45°

DATE 10-6-1980

CALIBRATION 20·1 mm /Volt.

ROD LENGTHS

NUMBER	LENGTH

TRANSVERSE MONITORING UNIT

DIAGRAM

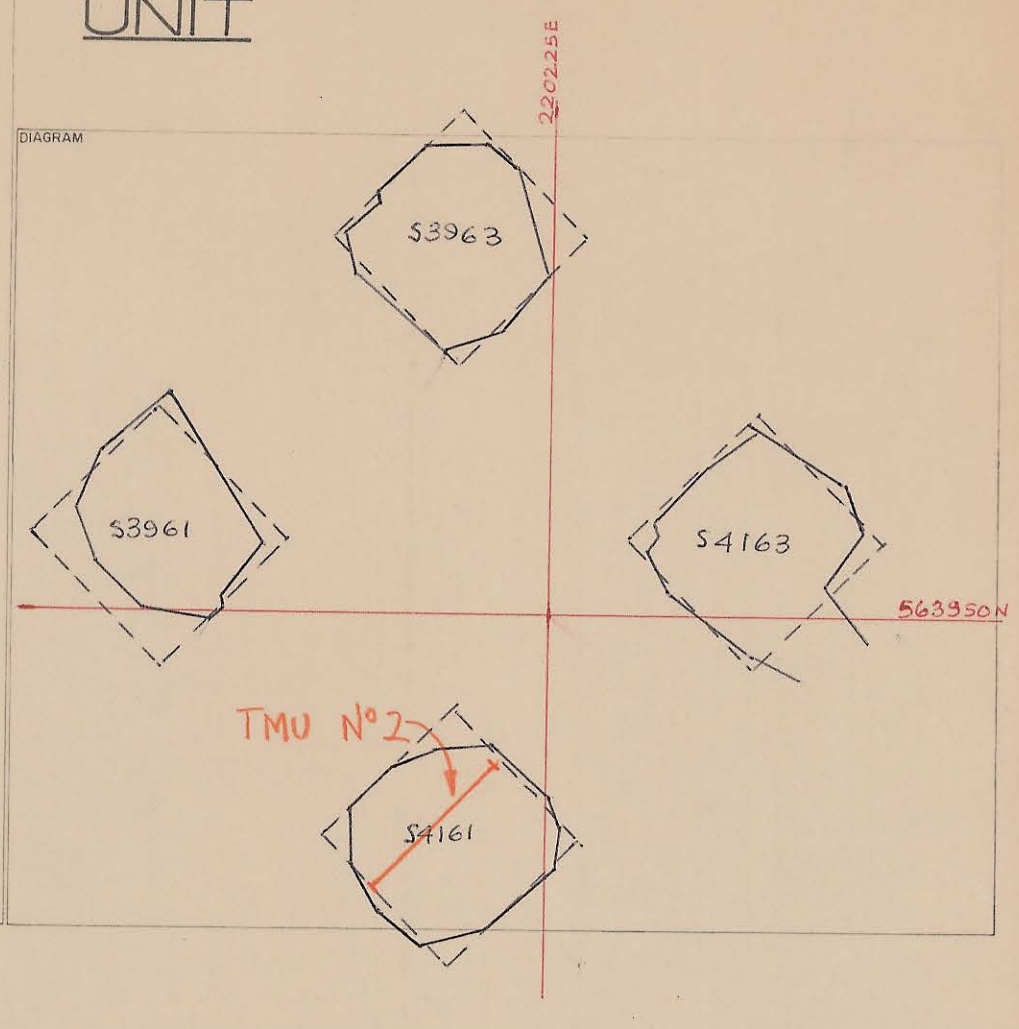

READINGS

DATE		ROD V	ΔV	Δmm	ROD DATE	V	ΔV	ROD Δmm	DATE	TIME	ROD V	ΔV	Δmm
15·7·80		1·929 ?			8·9·80 15:45	0·678	+0·194	+3·90	24·10·80	15:30	0·745	0·261	+5·25
15·7·80 16·7·80		1·929 ? 0·4849	0		9·9·80 16:00	0·678	+0·194	+3·90	27·10·80	15:30	0·748	0·264	+5·31
17·7·80	16:00	0·490 10	+0·006	+0·12	10·9·80 15:45	0·680	+0·196	+3·94	28·10·80	09:00	0·749	0·265	+5·33
18·7·80	15:30	0·503 11	+0·019	+0·38	11·9·80 16:00	0·680	+0·196	+3·94	29·10·80	13:45	0·753	0·269	+5·41
21·7·80	15:30	0·541 12	+0·057	+1·15	12·9·80 16:15	0·680	+0·196	+3·94	30·10·80	13:00	0·750	0·266	+5·35
22·7·80	16:00	+0·545	+0·061	+1·23	15·9·80 15:15	0·685	+0·201	+4·04	31·10·80	10:00	0·762	0·278	+5·59
23·7·80	16:00	+0·550 14	+0·066	+1·33	16·9·80 15:45	0·688	+0·204	+4·10	4·11·80	13:05	0·771	0·287	+5·77
24·7·80	15:45	+0·551	+0·067	+1·35	17·9·80 16:15	0·696	+0·212	+4·26	6·11·80	10:15	0·778	0·294	+5·91
25·7·80	15:30	+0·565	+0·081	+1·63	18·9·80 13:45	0·699	+0·215	+4·32	10·11·80	09:30	0·776	0·292	+5·87
28·7·80	15:30	+0·567	+0·083	+1·67	19·9·80 16:00	0·704	+0·220	+4·42	12·11·80	07:45	0·782	0·298	+5·99
29·7·80	16:00	+0·567 16	+0·083	+1·67	22·9·80 16:00	0·713	+0·229	+4·60	13·11·80	11:00	0·784	0·300	+6·03
4·8·80	16:15	+0·572 22	+0·088	+1·77	23·9·80 15:45	0·715	+0·231	+4·64	19·11·80	10:30	0·788	0·304	+6·11
5·8·80	16:00	+0·576	+0·092	+1·85	24·9·80 15:45	0·717	+0·233	+4·68	25·11·80	09:00	0·789	0·305	+6·13
6·8·80	15:45	+0·579 24	+0·095	+1·91	25·9·80 16:00	0·724	+0·240	+4·82	NEW BASE 27·11·80	08:45	1·431 1·174	0 0·307	0 +6·17
11·8·80	15:45	+0·653 27	+0·169	+3·40	26·9·80 15:45	0·725	+0·241	+4·84	28·11·80	14:00	1·174	0·307	6·17
12·8·80	16:00	+0·657	+0·173	+3·48	29·9·80 15:40	0·727	+0·243	+4·88	1·12·80 160	10:15	1·173	0·308	6·19
13·8·80	15:30	+0·657	+0·173	+3·48	30·9·80 10:45	0·729	+0·245	+4·92	3·12·80 162	08:45	1·172	0·309	6·21
14·8·80	15:30	+0·658	+0·174	+3·50	1·10·80 15:45	0·731	+0·247	+4·96	4·12·80 163	09:00	1·171 0·794	0·310	6·23
15·8·80	16:00	+0·659	+0·175	+3·52	2·10·80 14:15	0·732	+0·248	+4·98	9·12·80 168	10:00	1·169	0·312	6·27
18·8·80	15:30	+0·662	+0·178	+3·58	3·10·80 15:45	0·733	+0·249	+5·00	16·12·80 175	09:30	1·159	0·322	6·47
19·8·80	16:00	+0·664	+0·180	+3·62	6·10·80 15:30	0·745	+0·261	+5·25	17·12·80 176	08:15	1·158	0·323	6·49
20·8·80	15:30	+0·664	+0·180	+3·62	7·10·80 15:45	0·759	+0·275	+5·53	18·12·80 177	08:45	1·151	0·330	6·63
21·8·80	15:30	+0·664	+0·180	+3·62	8·10·80 16:00	0·734	+0·250	+5·03	22·12·80 181	11:00	1·138	0·343	6·89
22·8·80	13:30	+0·665	+0·181	+3·64	9·10·80 15:45	0·754	+0·270	+5·43	24·12·80 183		1·134	0·347	6·97
25·8·80	15:50	+0·665	+0·181	+3·64	10·10·80 15:30	0·749	+0·265	+5·33	29·12·80 188	10:50	1·132	0·349	7·01
26·8·80	15:30	+0·665	+0·181	+3·64	13·10·80 11:00	0·750	0·266	+5·35	2·1·81 192	13:30	1·129	0·352	7·08
27·8·80	15:30	+0·665	+0·181	+3·64	15·10·80 15:45	0·744	0·260	+5·23	6·1·81 196	08:45	1·127	0·354	7·12
28·8·80	15:35	+0·666	+0·182	+3·66	16·10·80 11:00	0·744	0·260	+5·23	9·1·81 199	08:15	1·127	0·354	7·12
29·8·80	13:50	+0·666	+0·182	+3·66	17·10·80 16:00	0·743	0·259	+5·21	12·1·81 202	09:15	1·127	0·354	7·12
1·9·80	15:45	+0·673	+0·189	+3·80	20·10·80 15:45	0·744	0·260	+5·23	14·1·81 204	10:15	1·126	0·355	7·14
3·9·80	15:45	+0·675	+0·191	+3·84	21·10·80 16:00	0·744	0·260	+5·23	19·1·81 209	13:00	1·118	0·363	7·30
4·9·80	15:30	+0·676	+0·192	+3·86	22·10·80 15:45	0·744	0·260	+5·23	21·1·81 211	09:00	1·110	0·371	7·46
5·9·80	11:00	+0·677 45	+0·193	+3·88	23·10·80 15:45	0·744	0·260	+5·23	27·1·81 217	13:30	1·095 111	0·386	7·76