


EARTH PRESSURE CELL

INSTALLATION N° 34 (17)
 DATE 8.6.1980
 ID small CSIRO
 UNIT N° 0999
 CABLE LENGTH ~ 30 m
 ZERO STRESS READING +3665 μE
 SENSITIVITY = 1.23 $\mu E / kPa$
 INITIAL STRESS _____
 ORIENTATION HORIZONTAL

LOCATION 2ND LIFT LOWER PIT

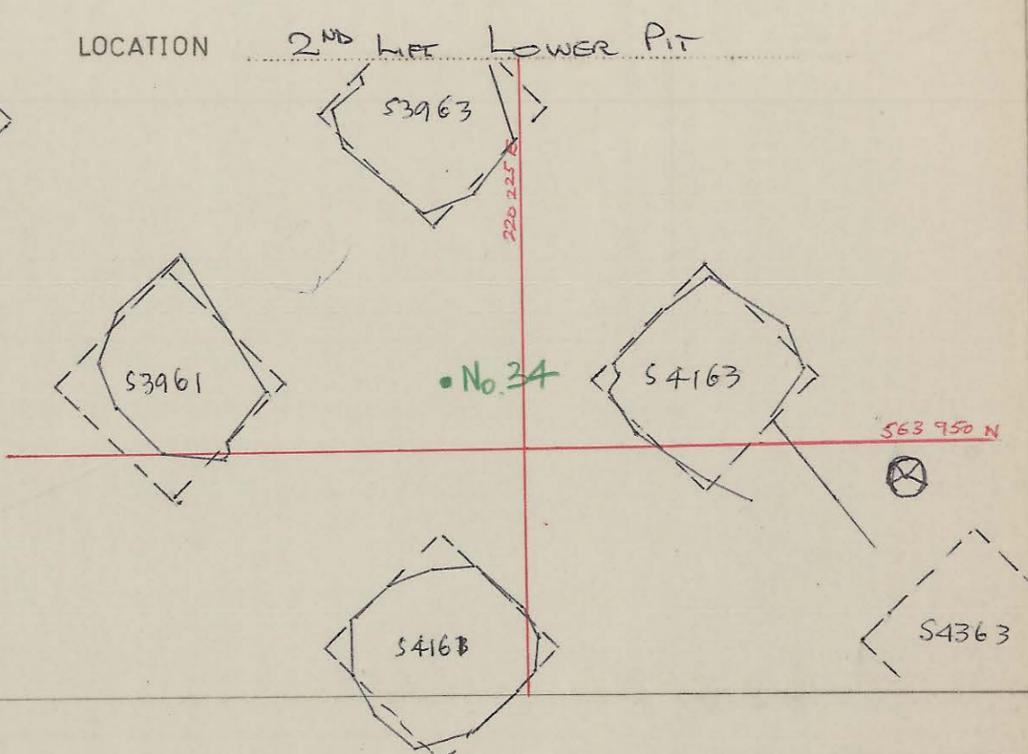

Date	Day	Reading μ	Δ Stress kPa	Stress kPa	Remarks	Date	Day	Reading μ	Δ Stress kPa	Stress kPa	Remarks
25.6.1980	0				Filling of S4062 commenced	25.8.80	62	15:50	+3470	134.5	
7.7.1980	13	+3470		134.5		26.8.80	63	15:20	+3470	134.5	
8.7.1980					2nd Lift Filled	27.8.80	64	15:30	+3480	138.4	
9.7.1980	15	+3410		86.2		28.8.80	65	15:35	+3480	138.4	
10.7.1980	16	+3410		86.2		29.8.80	66	13:50	+3480	138.4	
11.7.1980	17	+3405		81.0		1.9.80	69	15:45	+3490	151.7	
14.7.1980	20	+3395		72.4	Further filling in 2nd lift	3.9.80	70	15:45	+3495	155.1	
15.7.1980	21	+3385		65.5		4.9.80	72	15:30	+3490	151.7	
15.7.1980	21	+3390		68.9	Readout access point changed from mounting strip to amphetal plug	5.9.80	73	11:00	+3490	151.7	
16.7.1980	22	-3385		65.5		8.9.80	76	15:45	+3490	151.7	
17.7.1980	23	-3365		48.3	S4062 has been mined.	9.9.80	77	16:00	+3490	151.7	
18.7.1980	24	-3370		51.7		10.9.80	78	15:45	+3490	151.7	Strike finished
21.7.1980	27	-3375		56.9		11.9.80	79	16:00	+3490	151.7	
22.7.1980	28	-3375		56.9		12.9.80	80	16:15	+3495	155.1	
23.7.1980	29	-3380		60.3		15.9.80	83	15:15	+3490	151.7	
24.7.1980	30	-3385		65.5		16.9.80	84	15:45	+3495	155.1	
25.7.1980	31	-3385		65.5		17.9.80	85	16:15	+3490	151.7	
28.7.1980	34	-3390		68.9		18.9.80	86	13:45	+3490	151.7	
29.7.1980	35	-3390		68.9		19.9.80	87	16:00	+3490	151.7	
30.7.1980	36	+3400		77.6	S+ and S- swapped.	22.9.80	90	16:00	+3495	155.1	
31.7.1980	37	+3420		93.1		23.9.80	91	15:45	+3495	155.1	
1.8.80	38	+3405		81.0		24.9.80	92	15:45	+3495	155.1	
4.8.80	41	+3410		86.2		25.9.80	93	16:00	+3490	151.7	
5.8.80	42	+3410		86.2		26.9.80	94	15:45	+3505	163.8	
6.8.80	43	+3410		86.2		29.9.80	97	15:40	+3505	163.8	
7.8.80	44	+3425		98.3		30.9.80	98	10:45	+3500	159.4	
8.8.80	45	+3425		98.3		1.10.80	99	15:45	+3505	163.8	
11.8.80	48	+3425		98.3		2.10.80	100	14:15	+3500	159.4	
12.8.80	49	+3420		93.1		3.10.80	101	15:45	+3500	159.4	
13.8.80	50	+3450		118.9		6.10.80	104	15:30	+3500	159.4	
14.8.80	51	+3460		127.6		7.10.80	105	15:45	+3525	181.0	
15.8.80	52	+3465		131.0		8.10.80	106	16:00	+3505	163.8	
18.8.80	55	+3465		131.0		9.10.80	107	15:45	+3525	181.0	
19.8.80	56	+3465		131.0		10.10.80	108	15:30	+3505	163.8	
20.8.80	57	+3460		126.7		13.10.80	111	11:00	+3510	168.9	
21.8.80	58	+3460		127.6		15.10.80	113	15:45	+3525	181.0	
22.8.80	59	+3460		127.6		16.10.80	114	11:00	+3520	175.8	
						17.10.80	115	16:00	+3520	175.8	