0374_3102

5 cm

# PRESSURE CELL

INSTALLATION Nº 40

DATE 6-11-82

TYPE CSIRO

UNIT Nº 0992

CABLE LENGTH

ZERO STRESS READING

SENSITIVITY

CALIBRATION CONSTANT

ORIENTATION HORIZONTAL

LOCATION LWR PIT STOPE LIFT 6

220186 East

563955 North

R.L.

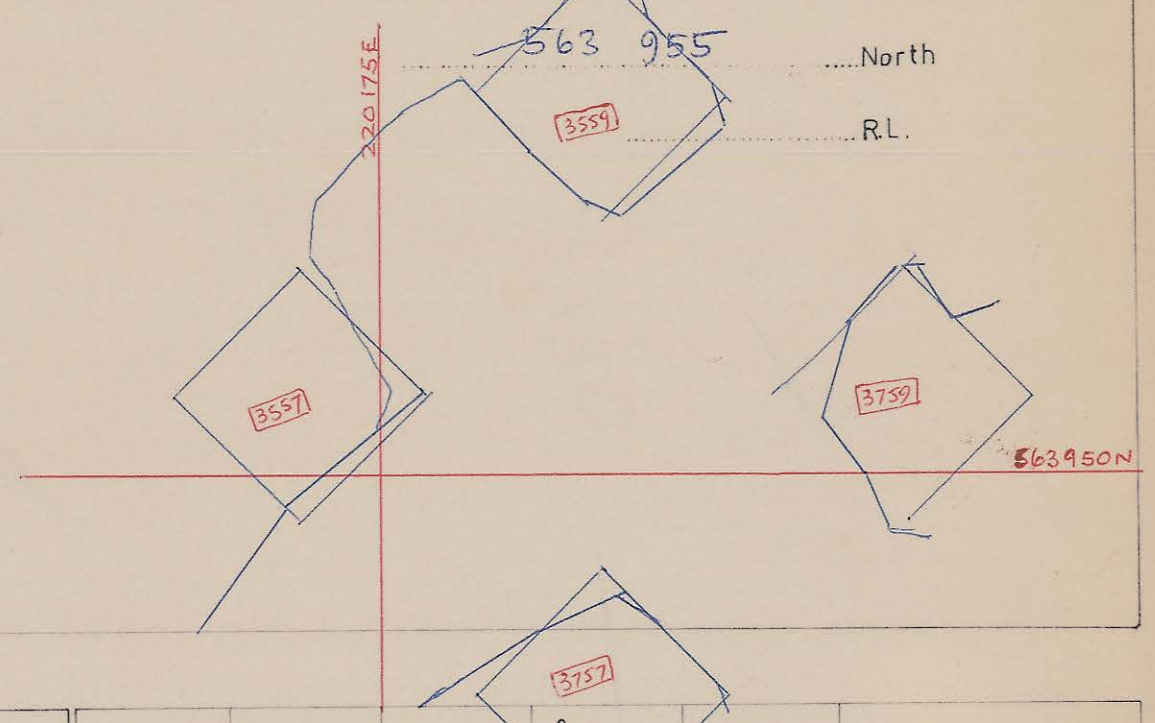


| Date | Day | Reading με | △Stress kPa | Stress kPa | Remarks |
|---|---|---|---|---|---|
| 6-11-82 | 0 | -3.32 | | | Before placement |
| 7-11-82 | 1 | -3.36 | | | At DDH in Q11 |
| 8-11-82 | 2 | -3.113 | | | At readout unit |
| | | -3.134 | | | |
| 9-11-82 | 3 | -3.063 | | | Full commenced 8am |
| | | -3.043 | | | ~.3m fill : 12v supply |
| 10-11-82 | 4 | -3.299 | | | |
| 11-11-82 | 5 | -2.036 | | | |
| 12-11-82 | 6 | -2.046 | | | |
| 15-11-82 | 9 | -1.226 | | | |
| 16-11-82 | 10 | -3.319 | | | Filling complete in the area |
| 18-11-82 | 12 | -3.244 | | | TF/Jc. visits & recipes the board |
| | | -3.314 | | | |
| 19-11-82 | 13 | -3.522 | | | |
| 22.11.82 | 16 | -3.126 | | | |
| 23.11.82 | 17 | -3.310 | | | |
| 24.11.82 | 18 | -3.184 | | | |
| 26.11.82 | 20 | -3.105 | | | |
| 1.12.82 | 25 | -3.169 | | | |
| 2.12.82 | 26 | -3.134 | | | |
| 3.12.82 | 27 | -3.108 | | | |
| 6.12.82 | 30 | -3.062 | | | |
| 7.12.82 | 31 | -3.077 | | | |
| 10.12.82 | 34 | -3.029 | | | |
| 13.12.82 | 37 | -3.025 | | | |
| 15.12.82 | 39 | | | | |
| 21.12.82 | 45 | | | | |
| 22.12.82 | 46 | -7.813 | | | |
| 24.12.82 | 48 | -8.396 | | | |
| 5.1.83 | | -8.523 | | | |
| 10.1.83 | | -3.283 | | | |
| 14.1.83 | | -3.114 | | | |
| 24.1.83 | | -3.091 | | | |
| 2-2-83 | | -3.286 | | | |
| 7-2-83 | | -3.083 | | | |
| 15-2-83 | | -3.813 | | | |
| 22-2-83 | | -3.042 | | | |
| 4-3-83 | | -3.066 | | | |
| 9-3-83 | | -2.974 | | | |

| Date | Day | Reading με | △Stress kPa | Stress kPa | Remarks |
|---|---|---|---|---|---|
| 14 3 83 | | -3.271 | | | |
| 21 3 83 | | -3.052 | | | |
| 6 4 83 | | -3.039 | | | |
| 11.5.83 | | 3.9 | | | |
| 13 5 83 | | -3.168 | | | |
| 19 5 83 | | -3.124 | | | |
| 15 6 83 | | -2.949 | | | |
| 15.6.83 | | -3004 | | | |
| 15.6.83 | | -3469 | | | New Plug connection |
| 29 6 83 | | -3327 | | | |
| 6 7 83 | | -3062 | | | |
| 20 7 83 | | -3016 | | | |
| 1 8 83 | | -3018 | | | |
| 9 8 83 | | -3075 | | | |
| 19 8 83 | | -2987 | | | |
| 30 8 83 | | -2964 | | | |
| 20 9 83 | | -2938 | | | |
| 11 10 83 | | -2997 | | | |
| 27 10 83 | | -3149 | | | |
| 8.11.83 | | -3025 | | | |
| 24 11 83 | | -3235 | | | |
| 5 12 83 | | -3006 | | | |
| 5 3 84 | | 0007 | | | |
| 10 4 84 | | 0037 | | | |
| 22 5 84 | | 45 | | | |