0374_3103

5 cm

PRESSURE CELL

INSTALLATION Nº 41

DATE 6-11-82

TYPE CSIRO

UNIT Nº 0989

CABLE LENGTH

ZERO STRESS READING

SENSITIVITY

CALIBRATION CONSTANT

ORIENTATION HORIZONTAL

LOCATION LWR PIT STOPE LIFT6

220 182 East

563 951 North

R.L.

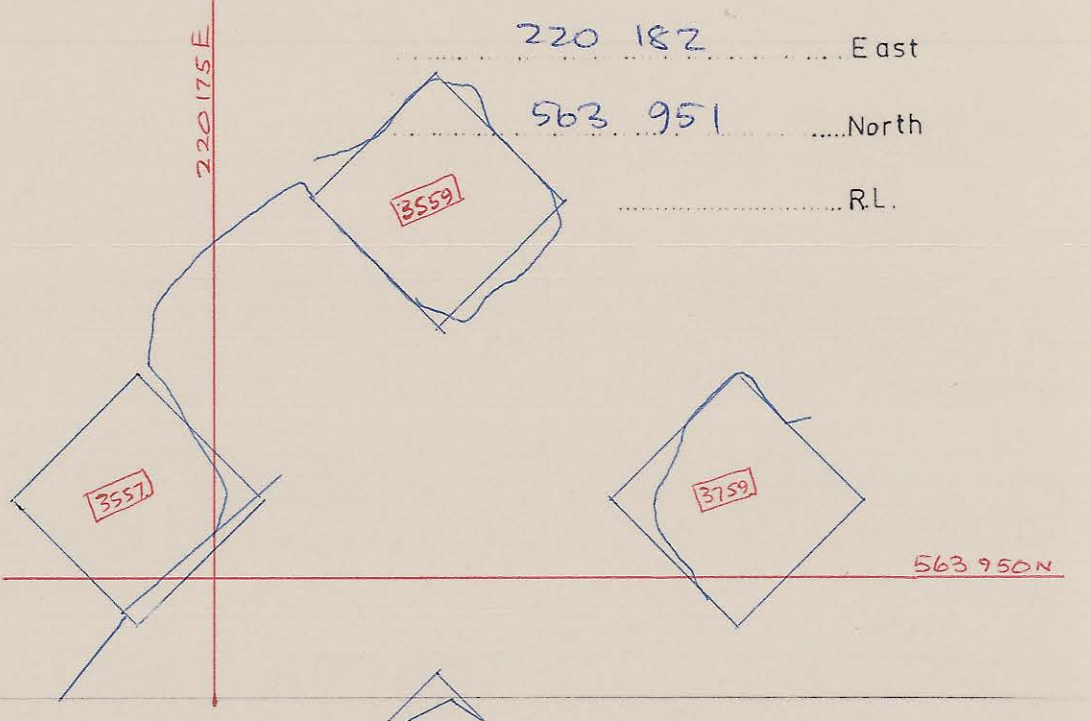

Date	Day	Reading με	△Stress kPa	Stress kPa	Remarks
6-11-82	0	-2.45			Before placement
7-11-82	1	-1.89			At DDH in QII
8-11-82	2	-2.047			At readout unit
		-2.068			
9-11-82	3	-2.028			Filling commenced 8am
		-2.040			~.3m fill; Now12V
10-11-82	4	-2.039			
11-11-82	5	-1.539			
12-11-82	6	-1.080			
15-11-82	9	3.122			
16-11-82	10	-1.214			Filling completed in the area
18-11-82	12	-2.032			TF/Jc. visits Board rectified
19-11-82	13	-2.105 -2.227			
22-11-82	16	-2.047			
23 11 82	17	-2.028			
24 11 82	18	-2.028			
26 11 82	20	-2.025			
1.12.82	25	-2.026			
2.12.82	26	-2.025			
3.12.82	27	-2.024			
6.12.82	30	-2.024			
7.12.82	31	-2.025			
10.12.82		-2.025			
13.12.82		-2.024			
16.12.82					
21.12.82					
22.12.82		-7.785			
24.12.82		-8.361			
5.1.83		-8.489			
10.1.83		-2.025			
14.1.83		-2.027			
24.1.83		-2.028			
2-2-83		-2.028			
7-2-83		-2.035			
15 2 83		-2.020			
22-2-83		-2.030			
28-2-83		-2.030			
4-3-83		-2.068			

Date	Day	Reading με	△Stress kPa	Stress kPa	Remarks
9.3.83	~~9-3-83~~	-2.009			
14 3 83		-2.007			
21 3 83		-2.009			
6 4 83		-1.998			
11.5.83		3.912			
13 5 83		-1.968			
19 5 83		-1.951			
15.6.83		-1.894			
15 6 83		-1.940			
15 6 83		-2.180			new Plug connecti
29 6 83		-1.872			
6 7 83		-1.857			
20 7 83		-1.819			
1 8 83		-1.784			
9 8 83		-1.763			
19 8 83		-1.743			
30 8 83		-1.725			
20 9 83		-1.711			
11 10 83		-1.562			
27 10 83		-1.544			
8.11.83		-1.528			
24 11 83		-1.508			
5 12 83		-1.496			
5 3 84		-1.435			
10 4 84		-1.3992			
22 5 84		-1.3727			