0374_3113

5 cm

PRESSURE CELL

INSTALLATION Nº 56

DATE 6-11-82

TYPE KYOWA PIEZOMETER

UNIT Nº YE 3098

CABLE LENGTH

ZERO STRESS READING ·003

SENSITIVITY ·8265 mV/V

CALIBRATION CONSTANT ·00242 kgm/cm² per μV/V = ·0484 kgm/cm² = 4·946 kPa

ORIENTATION VERTICAL

1 kPa = 101·97 mmH₂O

LOCATION LWR PIT STOPE LIFT 6

220 183 East

563 952 North

R.L.

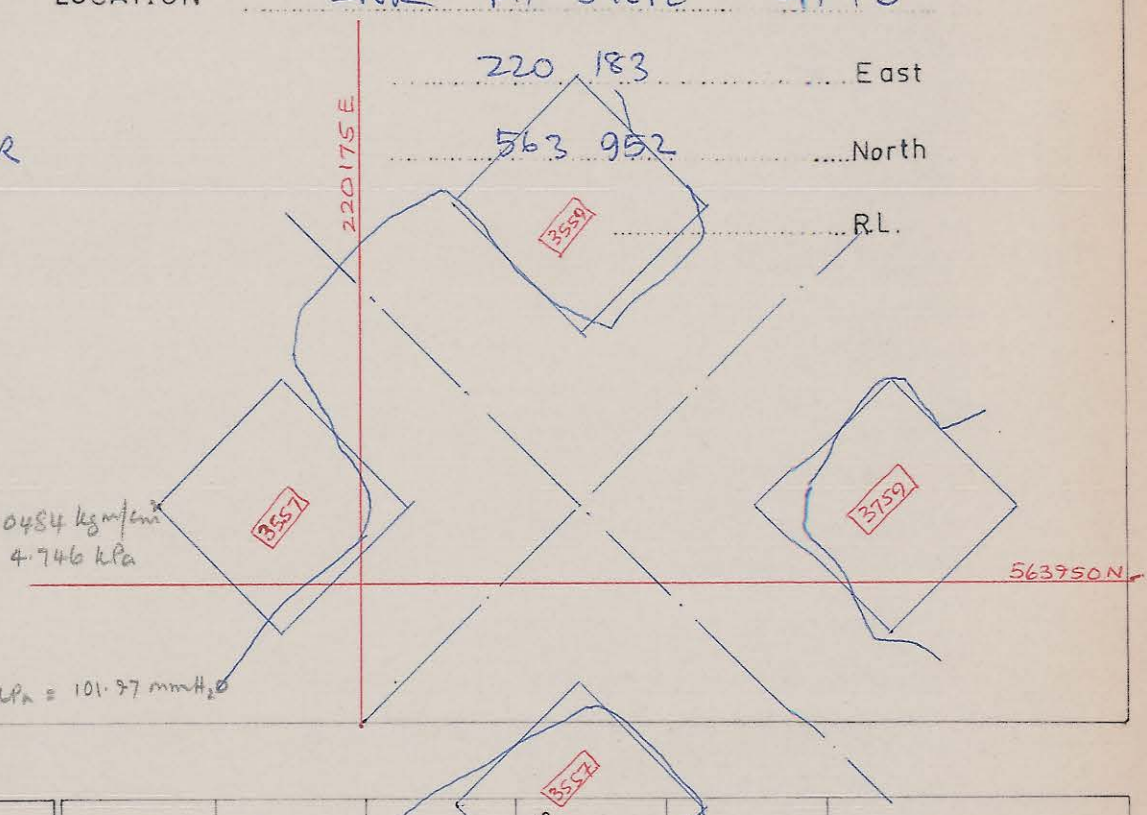

Date	Day	Reading με	△Stress kPa	Stress kPa	Remarks
6-11-82	0	-·04			Before placement
7-11-82	1	-·12			At DDH in Q11
8-11-82	2	—			
		·000			At read out unit
9-11-82	3	·000			Fill commenced 8am
		·003			~·3m fill; new supply
10-11-82	4	·003			
11-11-82	5	·004			
12-11-82	6	·006			
15-11-82	9	·008			
16-11-82	10	·009			Filling complete in this area
18-11-82	12	·017 ·012			
19.11.82	13	·006			
22.11.82	16	·009			
23.11.82	17	·009			
24.11.82	18	·007			
26.11.82	20	·008			
1.12.82	25	·006			
2.12.82	26	·006			
3.12.82	27	·005			
6.12.82	30	·005			
7.12.82	31	·004			
10.12.82		·005			
13.12.82		·0052			
15.12.82		-·005			
21.12.82		-·0			
22.12.82		·0112			
24.12.82		·035			
5.1.83		·023			
10.1.83		·003			
14.1.83		·005			
24.1.83		·005			
2.2.83		·002			
7-2-83		·001			
15-2-83		·005			
22-2-83		·001			
4-3-83		·009			
9-3-83		·004			

Date	Day	Reading με	△Stress kPa	Stress kPa	Remarks
14.3.83		·002			
21.3.83		·002			
11.5-83		—			Off scale
13 5 83		-			
19 5 83		-			
15 6 83		·0002			Key Board changed
15 6 83		·0002			Replacement of Readout Plug
29 6 83		-·003			
6 7 83		002			
20 7 83		-003			
1 8 83		-0049			
9 8 83		-006			
19 8 83		-009			
30 8 83		-010			
20 9 83		-013			
11 10 83		·007			
27 10 83		-005			
8 11 83		-007			
24 11 83		- 9			
5 12 83		- 8			
5 3 84		7			
10 4 84		9			
22 5 84		21			