


PORE PRESSURE CELL

INSTALLATION N° 25
 DATE 8.6.1980
 TYPE KYOWA BP-2KC
 UNIT N° YE 3086
 CABLE LENGTH ~ 30m
 ZERO STRESS READING -45 μE
 SENSITIVITY 1800 μE
 CALIBRATION CONSTANT 1111 $\frac{kg}{cm^2}$
 ORIENTATION

LOCATION Lower Pit, 2ND LIFT
 East
 North
 RL

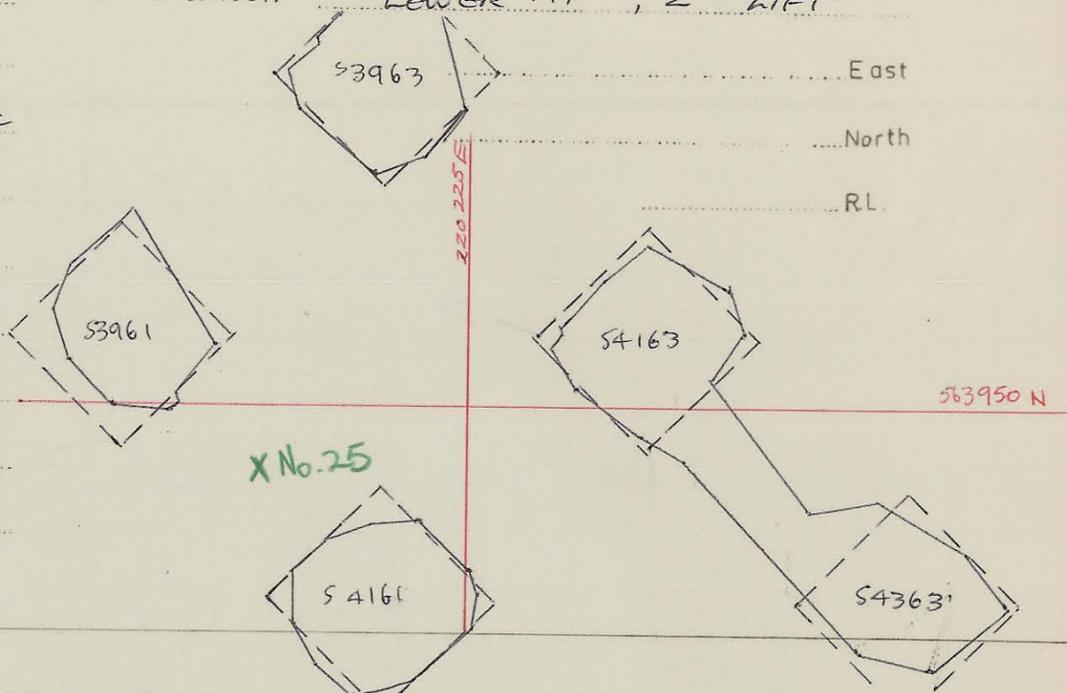

Date	Day	Reading μE	Δ Stress kPa	Stress kPa	Remarks	Date	Day	Reading μE	Δ Stress kPa	Stress kPa	Remarks
						16-9-80	84	15:45	+25	7.6	
						17-9-80	85	16:15	+60	11.4	
						18-9-80	86	13:15	+25	7.6	
7-7-80	13	15		10.5		19-9-80	87	16:00	+10	3.3	
15-7-1980	21	14:00	+15	8	+6.5	22-9-80	90	16:00	+50	10.4	
30-7-1980	36	15:30	+15	19	+6.5	23-9-80	91	15:45	+55	10.9	
31-7-1980	37	16:00	+10	20	+6.0	24-9-80	92	15:45	+60	11.4	
1-8-80	38	15:30	+10		6.0	25-9-80	93	16:00	+75	13.1	
4-8-80	41	16:15	+30?		8.2	26-9-80	94	15:45	+85	14.2	
5-8-80	42	16:00	+30		8.2	29-9-80	97	15:40	+90	14.7	
6-8-80	43	15:45	+25		7.6	30-9-80	98	10:45	+80	13.6	
7-8-80	44	16:00	+20		7.1	1-10-80	99	15:45	+105	16.3	
8-8-80	45	16:00	+10		6.0	2-10-80	100	14:15	+75	13.1	
11-8-80	48		0		4.9	3-10-80	101	15:45	+90	14.7	
12-8-80	49	16:00	+35		8.7	6-10-80	104	15:30	+80	13.6	
13-8-80	50	15:30	+70		12.5	7-10-80	105	15:45	-825		? pressure cell?
14-8-80	51	15:30	+60	30	11.4	8-10-80	106	16:00	+80	13.6	
15-8-80	52	16:00	+100		15.8	9-10-80	107	15:45	0	4.9	
18-8-80	55	15:30	+85		14.2	10-10-80	108	15:30	-20	2.7	
19-8-80	56	16:00	+60		11.4	13-10-80	111	11:00	-5	4.4	
20-8-80	57	15:30	+50		10.4	15-10-80	113	15:45	+15	6.5	
21-8-80	58	15:30	+90		14.7	16-10-80	114	11:00	+20	7.1	
22-8-80	59	13:30	+95		15.3	17-10-80	115	16:00	+25	7.6	
25-8-80	62	15:50	+90		14.7	20-10-80	118	15:45	+35	8.7	
26-8-80	63	15:20	+80		13.6	21-10-80	119	16:00	+55	10.9	
27-8-80	64	15:30	+90		14.7	22-10-80	120	15:45	+50	10.4	
28-8-80	65	15:35	+90	40	14.7	23-10-80	121	15:45	+50	10.4	
24-8-80	66	13:50	+80		13.6	24-10-80	122	15:30	+60	11.4	
1-9-80	69	15:45	+30		8.2	27-10-80	125	15:30	+50	10.4	
3-9-80	71	15:45	+40		9.3	28-10-80	126	09:00	+55	10.9	
4-9-80	72	15:30	+30		8.2	29-10-80	127	13:45	+65	12.0	
5-9-80	73	11:00	+45		9.8	30-10-80	128	13:00	+95	15.3	? pressure cell?
8-9-80	76	15:45	0		4.9	31-10-80	129	10:00	+65	12.0	
9-9-80	77	16:00	5		5.4	4-11-80	133	13:05	+60	11.4	
10-9-80	78	15:45	+20		7.1	6-11-80	135	10:15	0	4.9	?
11-9-80	79	16:00	+10		6.0	10-11-80	139	09:30	0	4.9	?
12-9-80	80	16:15	+30	50	8.2	12-11-80	141	07:45	+60	11.4	
5-9-80	83	15:15	+15	5A	6.5	13-11-80	142	11:00	+60	11.4	