


5 cm

PORE PRESSURE CELL

INSTALLATION N° 26
 DATE 8.6.1980
 TYPE KYOWA BP-2KC
 UNIT N° YE 3097
 CABLE LENGTH = 30m
 ZERO STRESS READING -23 μE
 SENSITIVITY 2115 μE
 CALIBRATION CONSTANT 945.6 kg/cm^2
 ORIENTATION

LOCATION Lower P.T. 2ND LIFT

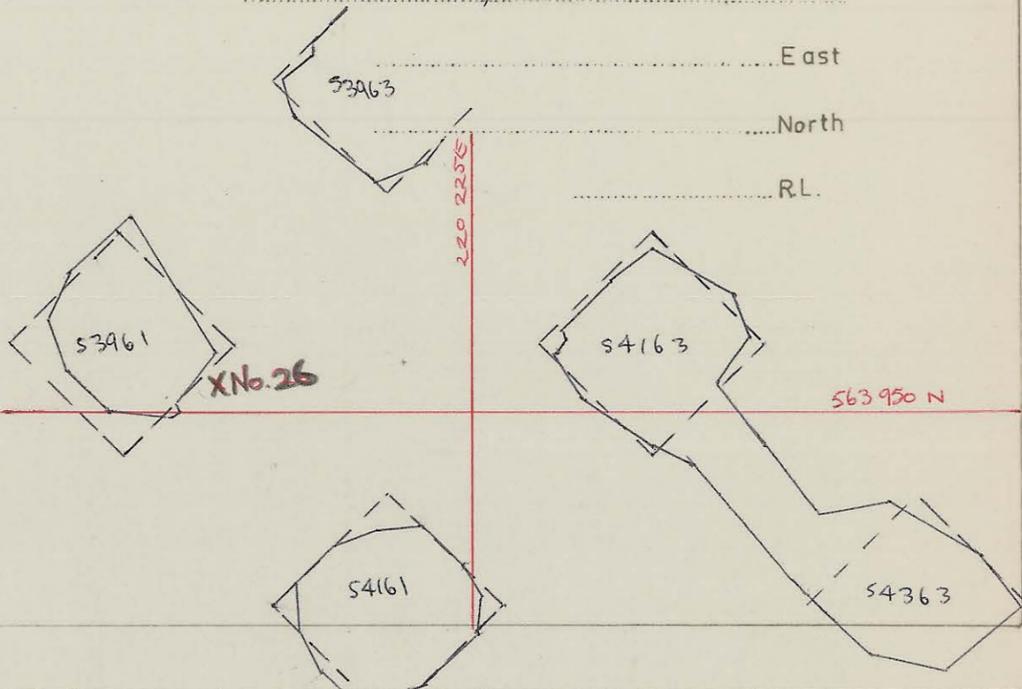

NOTE CAL. FACTOR WAS TO BE CHANGED TO 1.00 FOR THIS DATA!

Date	Day	Reading μE	Δ Stress kPa	Stress kPa	Remarks	Date	Day	Reading μE	Δ Stress kPa	Stress kPa	Remarks			
			-23			25.8.80	62	15.50	+5	50	2.6	6.7		
						26.8.80	63	15.20	+10	15	5.8	3.5		
7.7.1980	13	-15	70	+3.5	8.6	27.8.80	64	15.30	+40	15	5.8	3.5		
8.7.1980	14					28.8.80	65	15.35	+70	+15	8.6	0.7		
9.7.1980	15	-20	75	+0.3	9.0	29.8.80	66	13.50	+40	15	5.8	3.5		
10.7.1980	16	0	55	2.1	7.2	1.9.80	69	15.45	+5	50	2.6	6.7		
11.7.1980	17	+50	5	6.5	2.5	2.9.80	71	15.45	+10	45	3	6.2		
14.7.1980	20					4.9.80	72	15.30	+10	45	3.1	6.2		
15.7.1980	21	+40	15	5.8	3.5	5.9.80	73	11:00	+10	45	3.1	6.2		
15.7.1980	21				Readings taken from amplified plug.	8.9.80	76	15:45	+45	10	6.3	3.0		
16.7.1980	22	-30	25	4.9	4.4	9.9.80	77	16:00	+35	20	5.4	3.9		
17.7.1980	23	-15	40	3.5	5.8	10.9.80	78	15:45	+25	30	4.5	4.8		
18.7.1980	24	-40	15	5.8	3.5	11.9.80	79	16:00	+25	30	4.5	4.8		
21.7.1980	27	15:30	-10	45	3.1	6.2	12.9.80	80	16:15	+15	40	50	3.5	5.8
22.7.1980	28	16:00	-30	25	4.9	4.4	15.9.80	83	15:15	+5	50	2.6	6.8	
23.7.1980	29	16:00	-30	25	4.9	4.4	16.9.80	84	15:45	-10	65	1.2	8.1	
24.7.1980	30	15:45	-35	20	5.4	3.9	17.9.80	85	16:15	-45	100	-2.0	11.3	
25.7.1980	31	16:00	-30	25	4.9	4.4	18.9.80	86	13:45	-10	65	1.2	8.1	
28.7.1980	34	15:30	+20	75	0.3	9.0	19.9.80	87	16:00	+35	20	5.4	3.9	
29.7.1980	35	16:00	-10	45	3.1	6.2	22.9.80	90	16:00	-30	85	-0.6	9.9	
30.7.1980	36	15:30	+25	30	4.5	4.8	23.9.80	91	15:45	-35	90	-1.1	10.4	
31.7.1980	37	16:00	+25	30	4.5	4.8	24.9.80	92	15:45	-35	90	-1.1	10.4	
1.8.80	38	15:30	+25	30	4.5	4.8	25.9.80	93	16:00	-60	135	-3.4	12.7	
4.8.80	41	16:15	+50?	50	2.8	6.7	26.9.80	94	15:45	-50	105	-2.5	11.8	
5.8.80	42	16:00	+15	40	3.5	5.8	29.9.80	97	15:40	-45	100	-2.0	11.3	
6.8.80	43	15:45	+20	35	4.0	5.3	30.9.80	98	10:45	-70	125	-4.4	13.7	
7.8.80	44	16:00	+15	40	3.5	5.8	1.10.80	99	15:45	-90	145	-6.2	15.5	
8.8.80	45	16:00	+35	20	5.4	3.9	2.10.80	100	14:15	-75	130	-4.8	14.1	
11.8.80	48		+25	30	4.5	4.8	3.10.80	101	15:45	-45	100	-2.0	11.3	
12.8.80	49	16:00	-5	60	1.7	7.6	6.10.80	104	15:30	-60	135	-3.4	12.7	
13.8.80	50	15:30	-50	105	-2.5	11.8	7.10.80	105	15:45	+85 (+60)			? pins wet.	
14.8.80	51	15:30	-45	100	-2.0	11.3	8.10.80	106	16:00	-65	120	-3.9	13.2	
15.8.80	52	16:00	-70	125	-4.4	13.7	9.10.80	107	15:45	-65	120	-3.9	13.2	
18.8.80	55	15:30	-60	115	-3.4	12.7	10.10.80	108	15:30	-70	125	(70) -4.4	13.7	
19.8.80	56	16:00	-30	85	-0.6	9.9	13.10.80	111	11:00	-35	90	-1.1	10.4	
20.8.80	57	15:30	-10	65	1.2	8.1	15.10.80	113	15:45	-65	120	-3.9	13.2	
21.8.80	58	15:30	-5	60	1.7	7.6	16.10.80	114	11:00	-65	120	-3.9	13.2	
22.8.80	59	13:30	+5	50	2.6	6.7	17.10.80	115	16:00	-55	110	(74) -3.0	12.3	