5 cm

03DM07-3030A

0374_3245

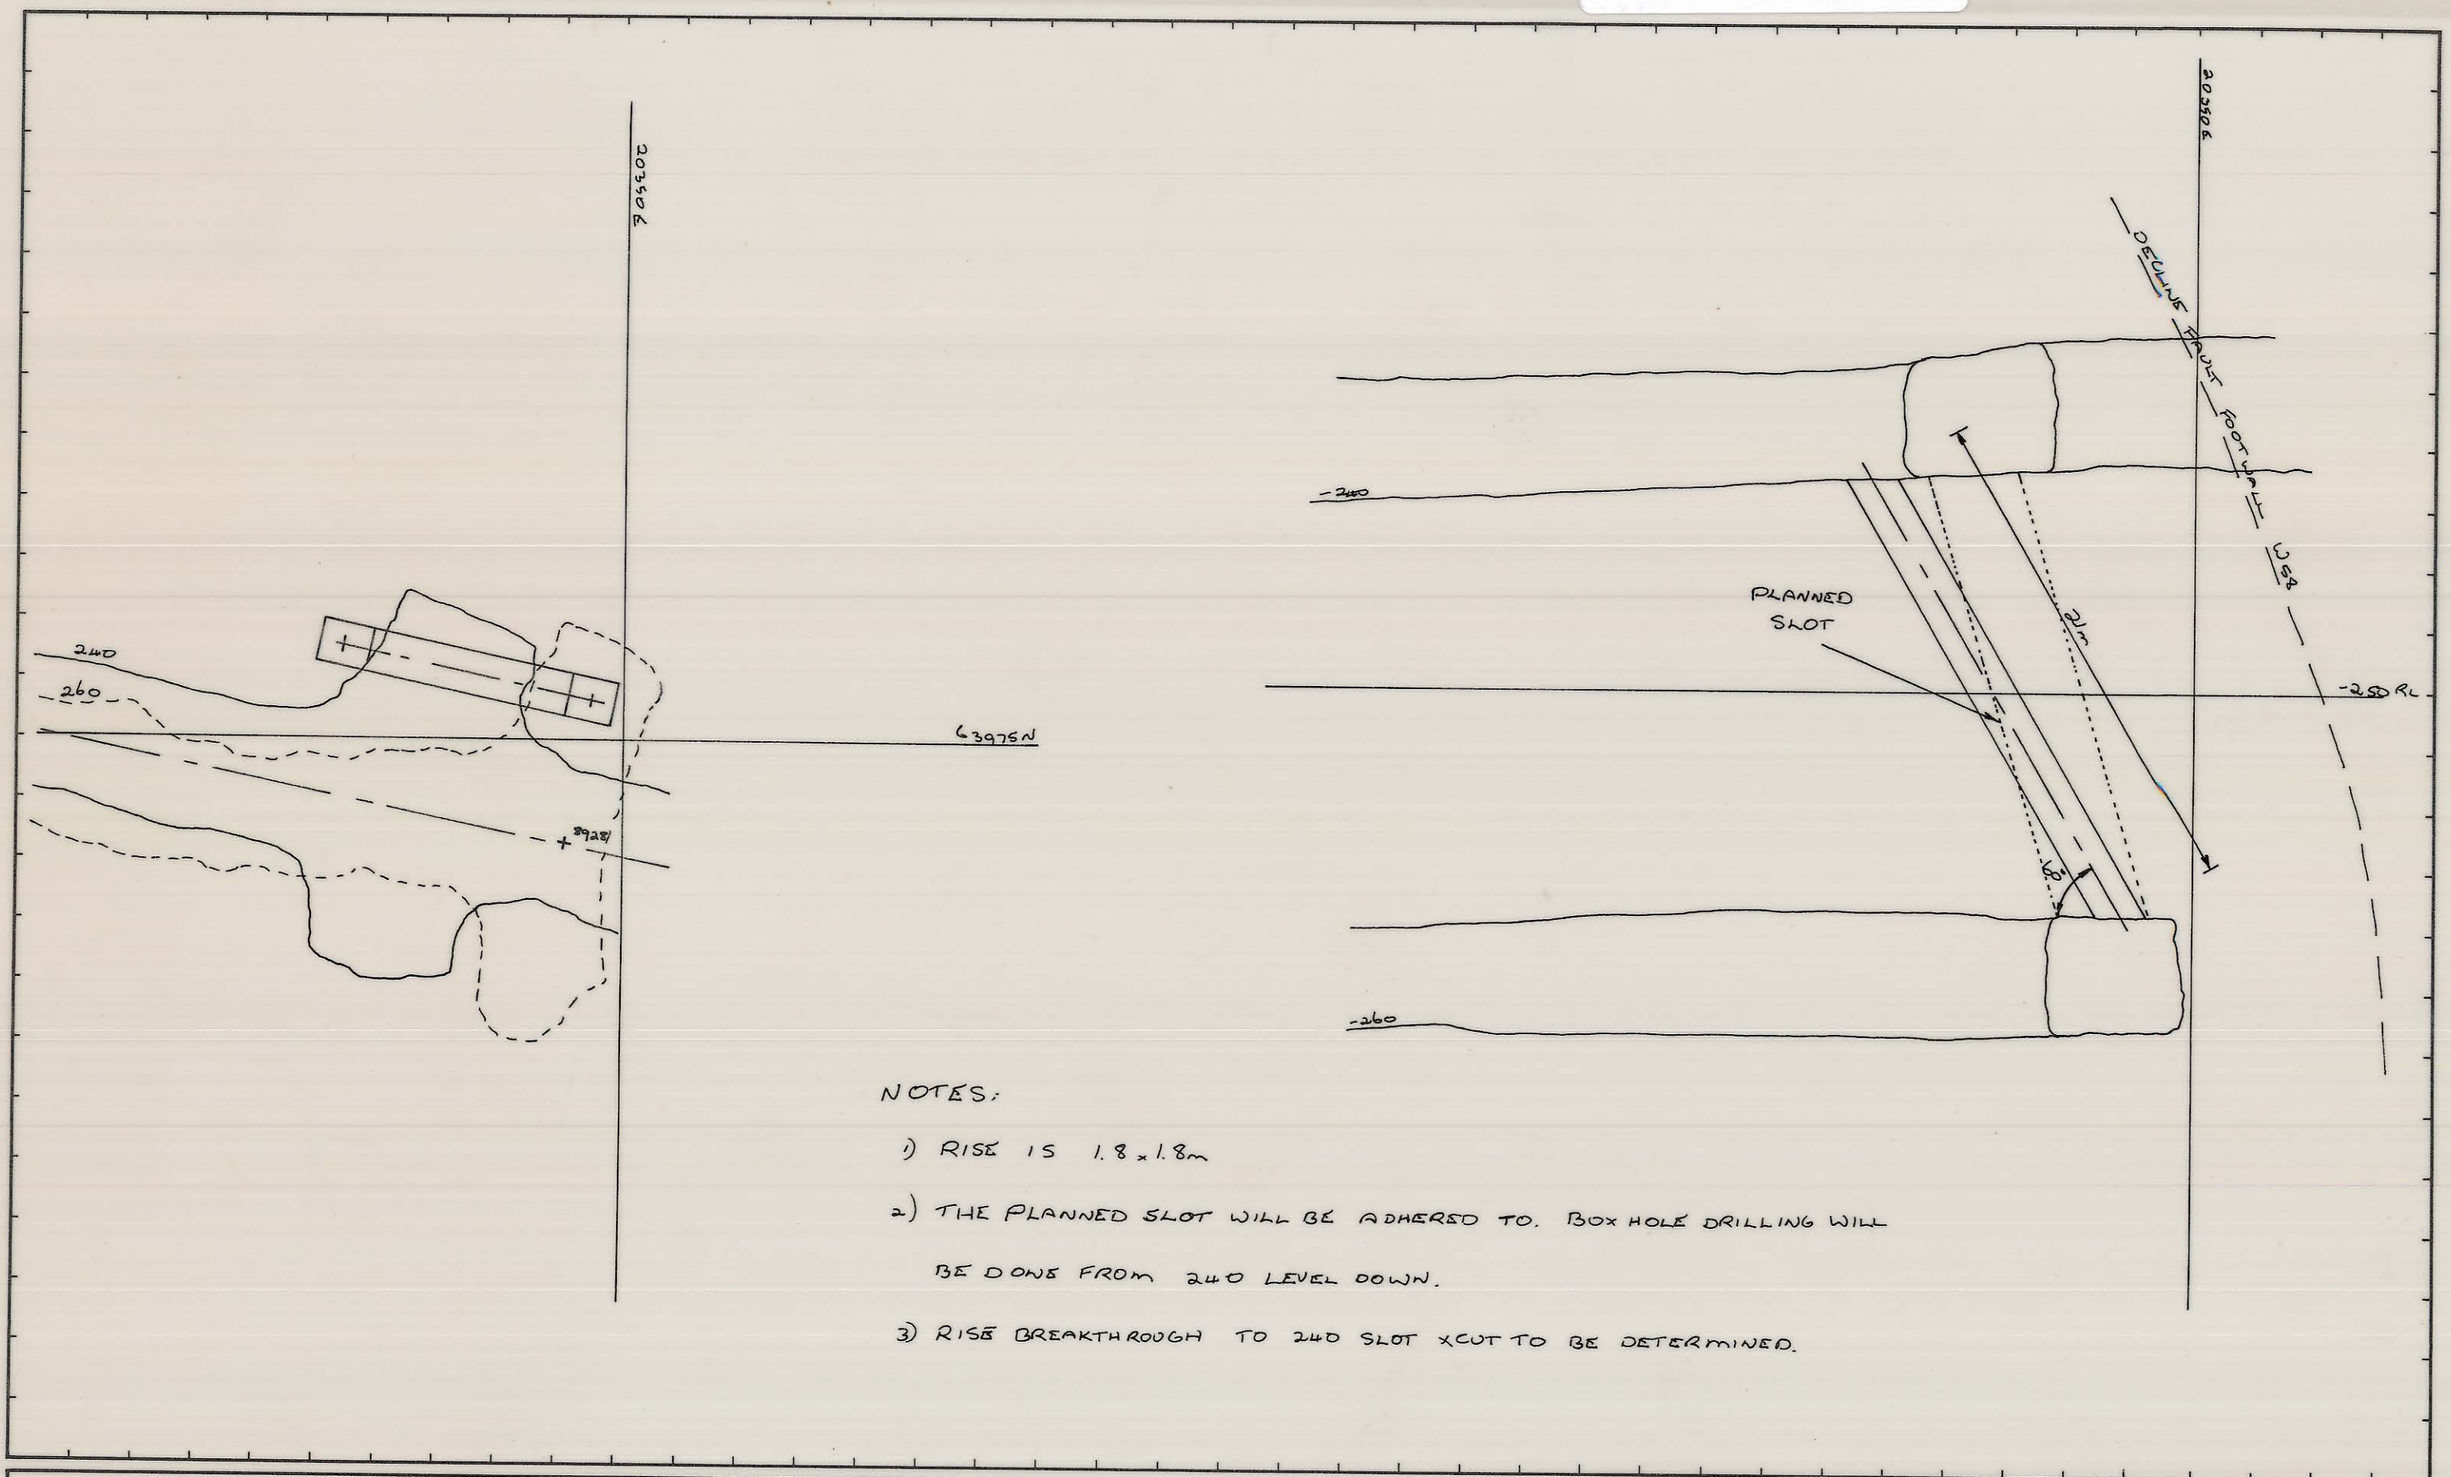

NOTES:

1) RISE IS 1.8 x 1.8m

2) THE PLANNED SLOT WILL BE ADHERED TO. BOX HOLE DRILLING WILL BE DONE FROM 240 LEVEL DOWN.

3) RISE BREAKTHROUGH TO 240 SLOT XCUT TO BE DETERMINED.

REF. PLAN 03DM07-1023	GEOLOGY		
	SURVEY		
	PLANNING		
	ROCK MEC.		
	GRADE CON.		
	DRAFTING		
	T.S.S.	Agc	13/1/83

SCALE 1: 250

KIS KING ISLAND SCHEELITE GRASSY KING ISLAND

DOLPHIN MINE
W58
240 - 260
REVISED SLOT RISE

DRAWING NUMBER
03DM07 - 3030 A