5 cm

03 DM 07 – 3031

0374_3246

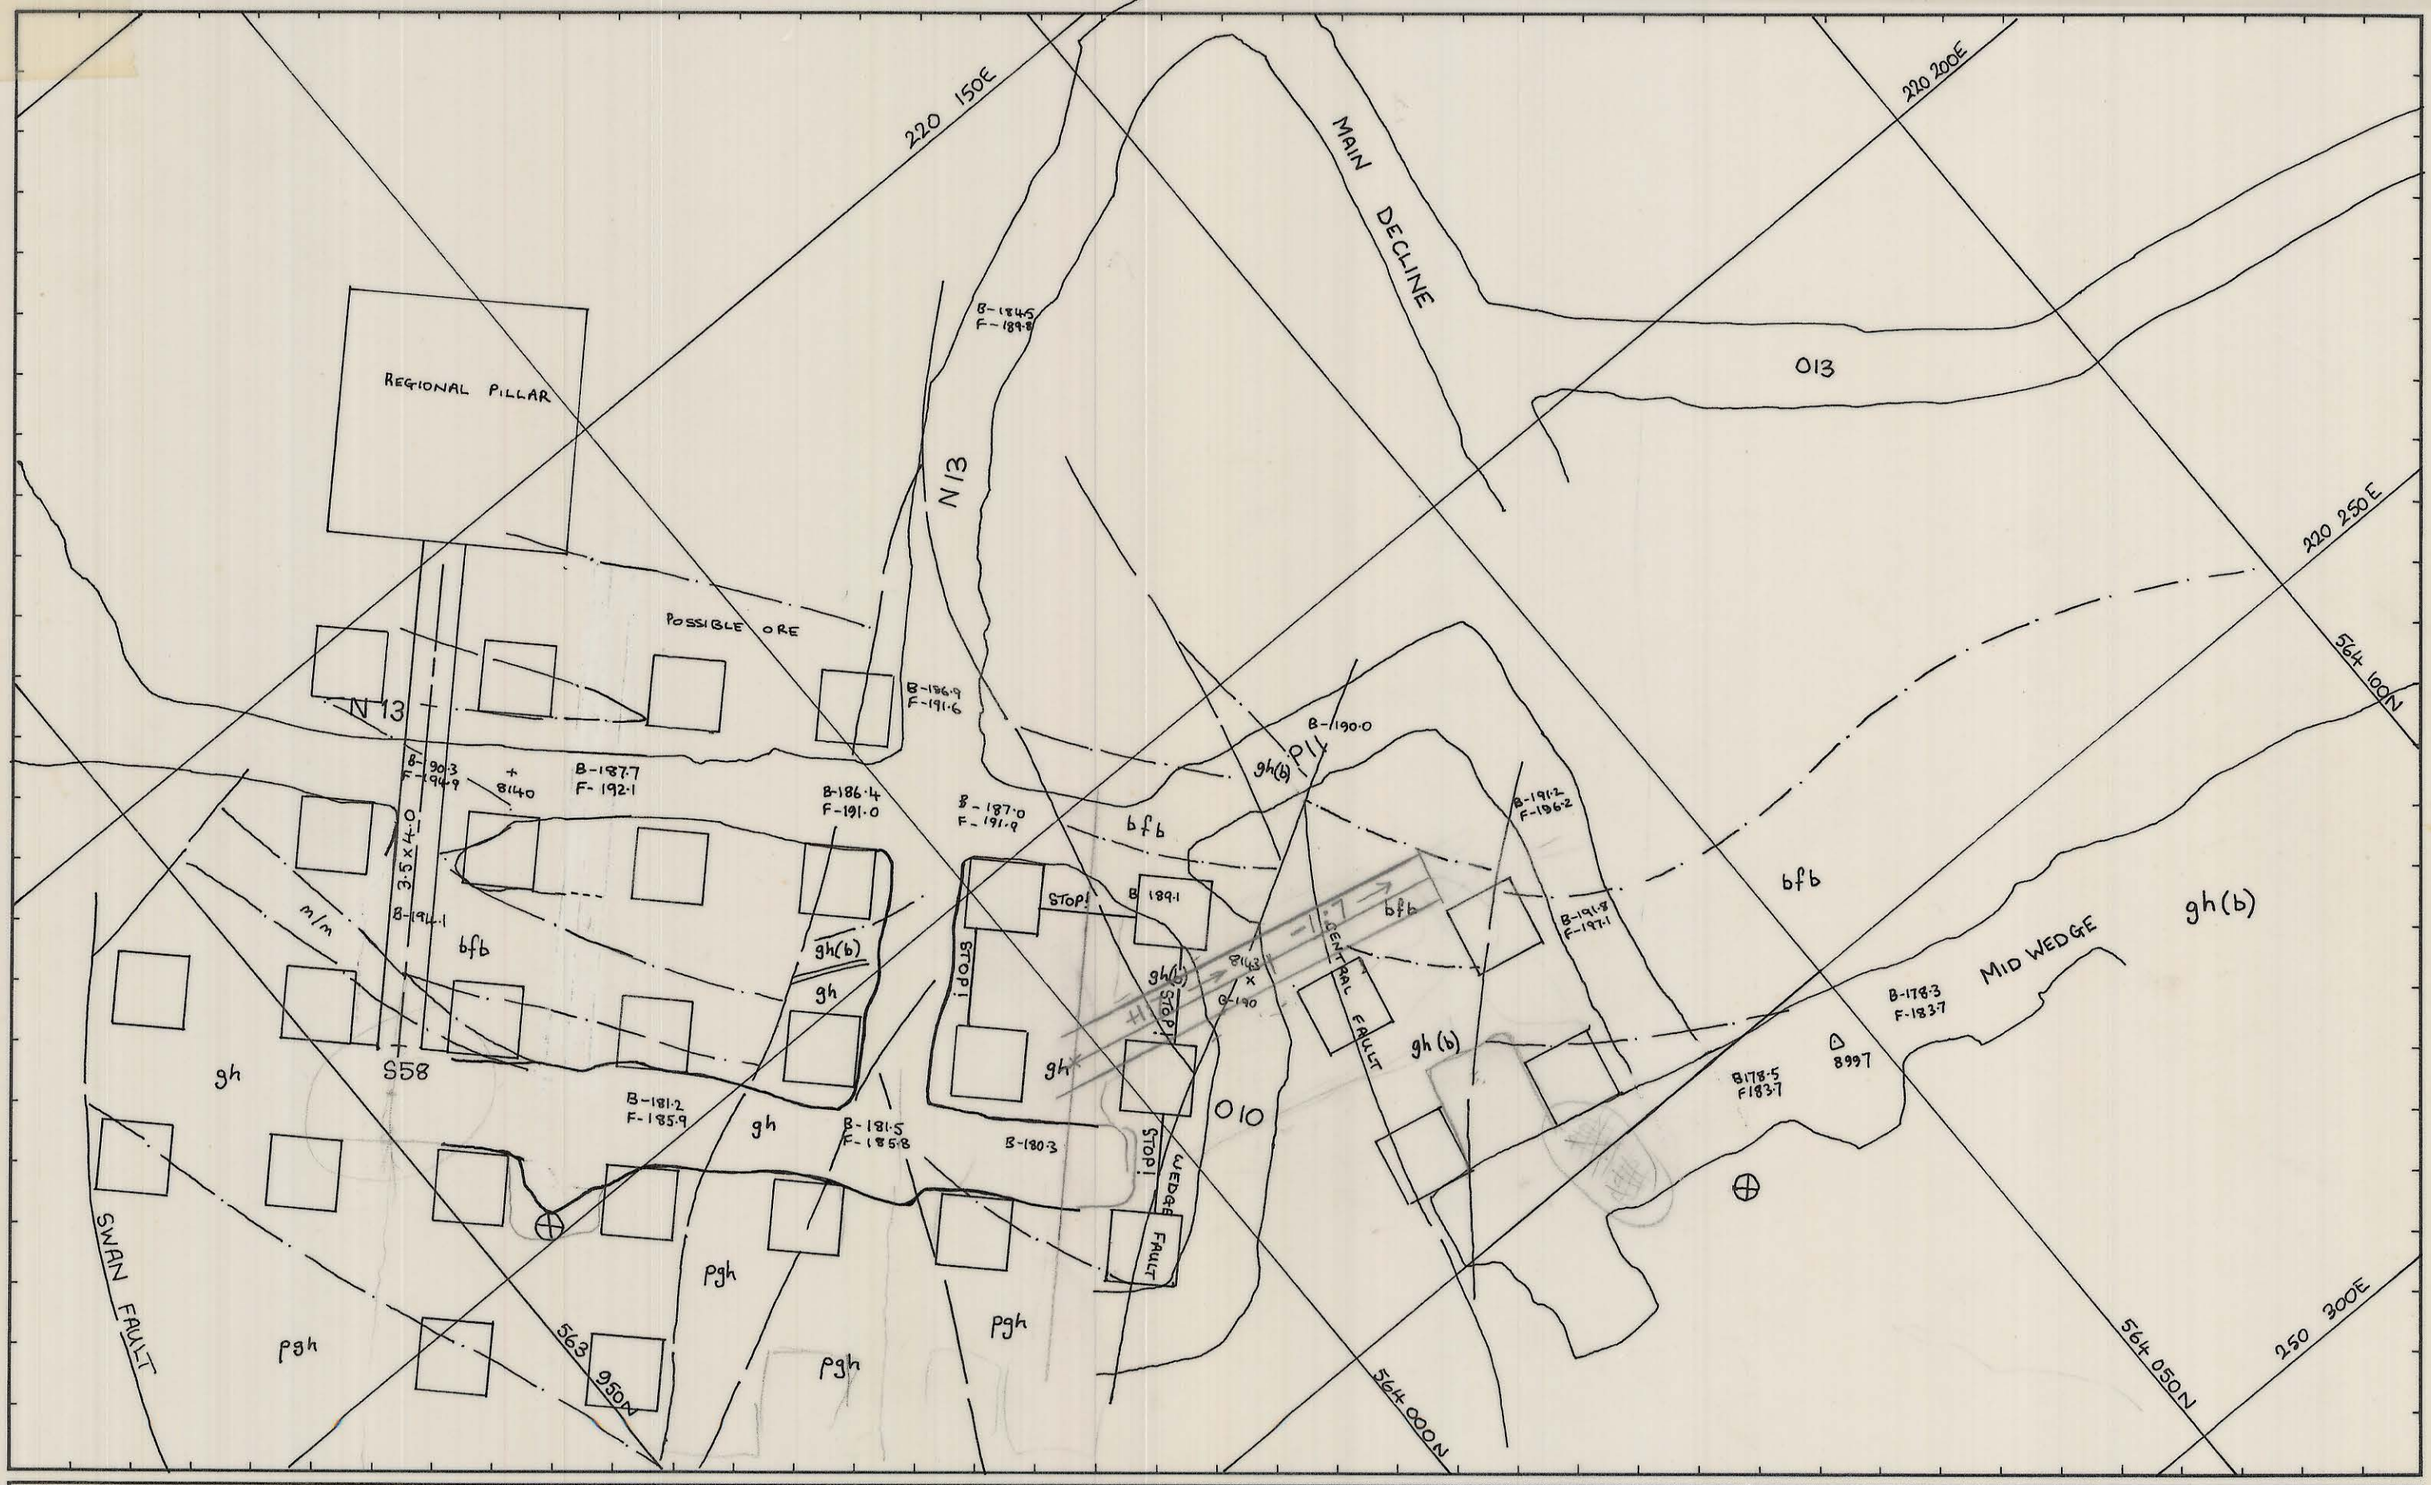

REF. PLAN	GEOLOGY			SCALE 1:500	KING ISLAND SCHEELITE GRASSY KING ISLAND
M.C.D. 30/10/84	SURVEY			LOWER PIT STOPE	
	PLANNING	A.D.7	4-9-84	S58 DEVELOPMENT & STOPE LIMITS.	
	ROCK MEC.		12.9.84.		
	GRADE CON.				
	DRAFTING			DRAWING NUMBER	
	T.S.S.			03 DM 07 – 3031	